

A. CALDWELL

ROBERT PATTERSON


CEMETERY

FRUIT HILL CHURCH
MAGE BLOOM

SMITH McNEEL

JOE WITHEROW

A. CALDWELL

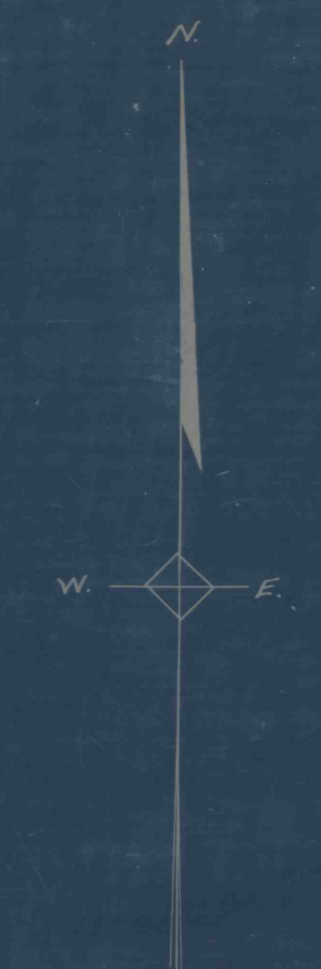

CARNWATH
2

1000'

"THE RAE PLACE"

POTTS

RUN

CARNWATH COAL CO.

MAP OF NO. 2-MINE

JORDAN TWP. CLEARFIELD CO. PA.

SCALE 1"=100'

CLEARFIELD PA.

OFFICE OF E. W. HESS
ENGINEER

JULY 5-1913

DATE OF SURVEYS
 JULY 1-2 1912
 DECEMBER 18-19 1913
 JUNE 10-11 1916
 JANUARY 24 1915
 CLEARFIELD 1915
 AUGUST 18 1916
 MARCH 22 1917
 FEBRUARY 10 1918
 DECEMBER 5 1918