


11543

11543

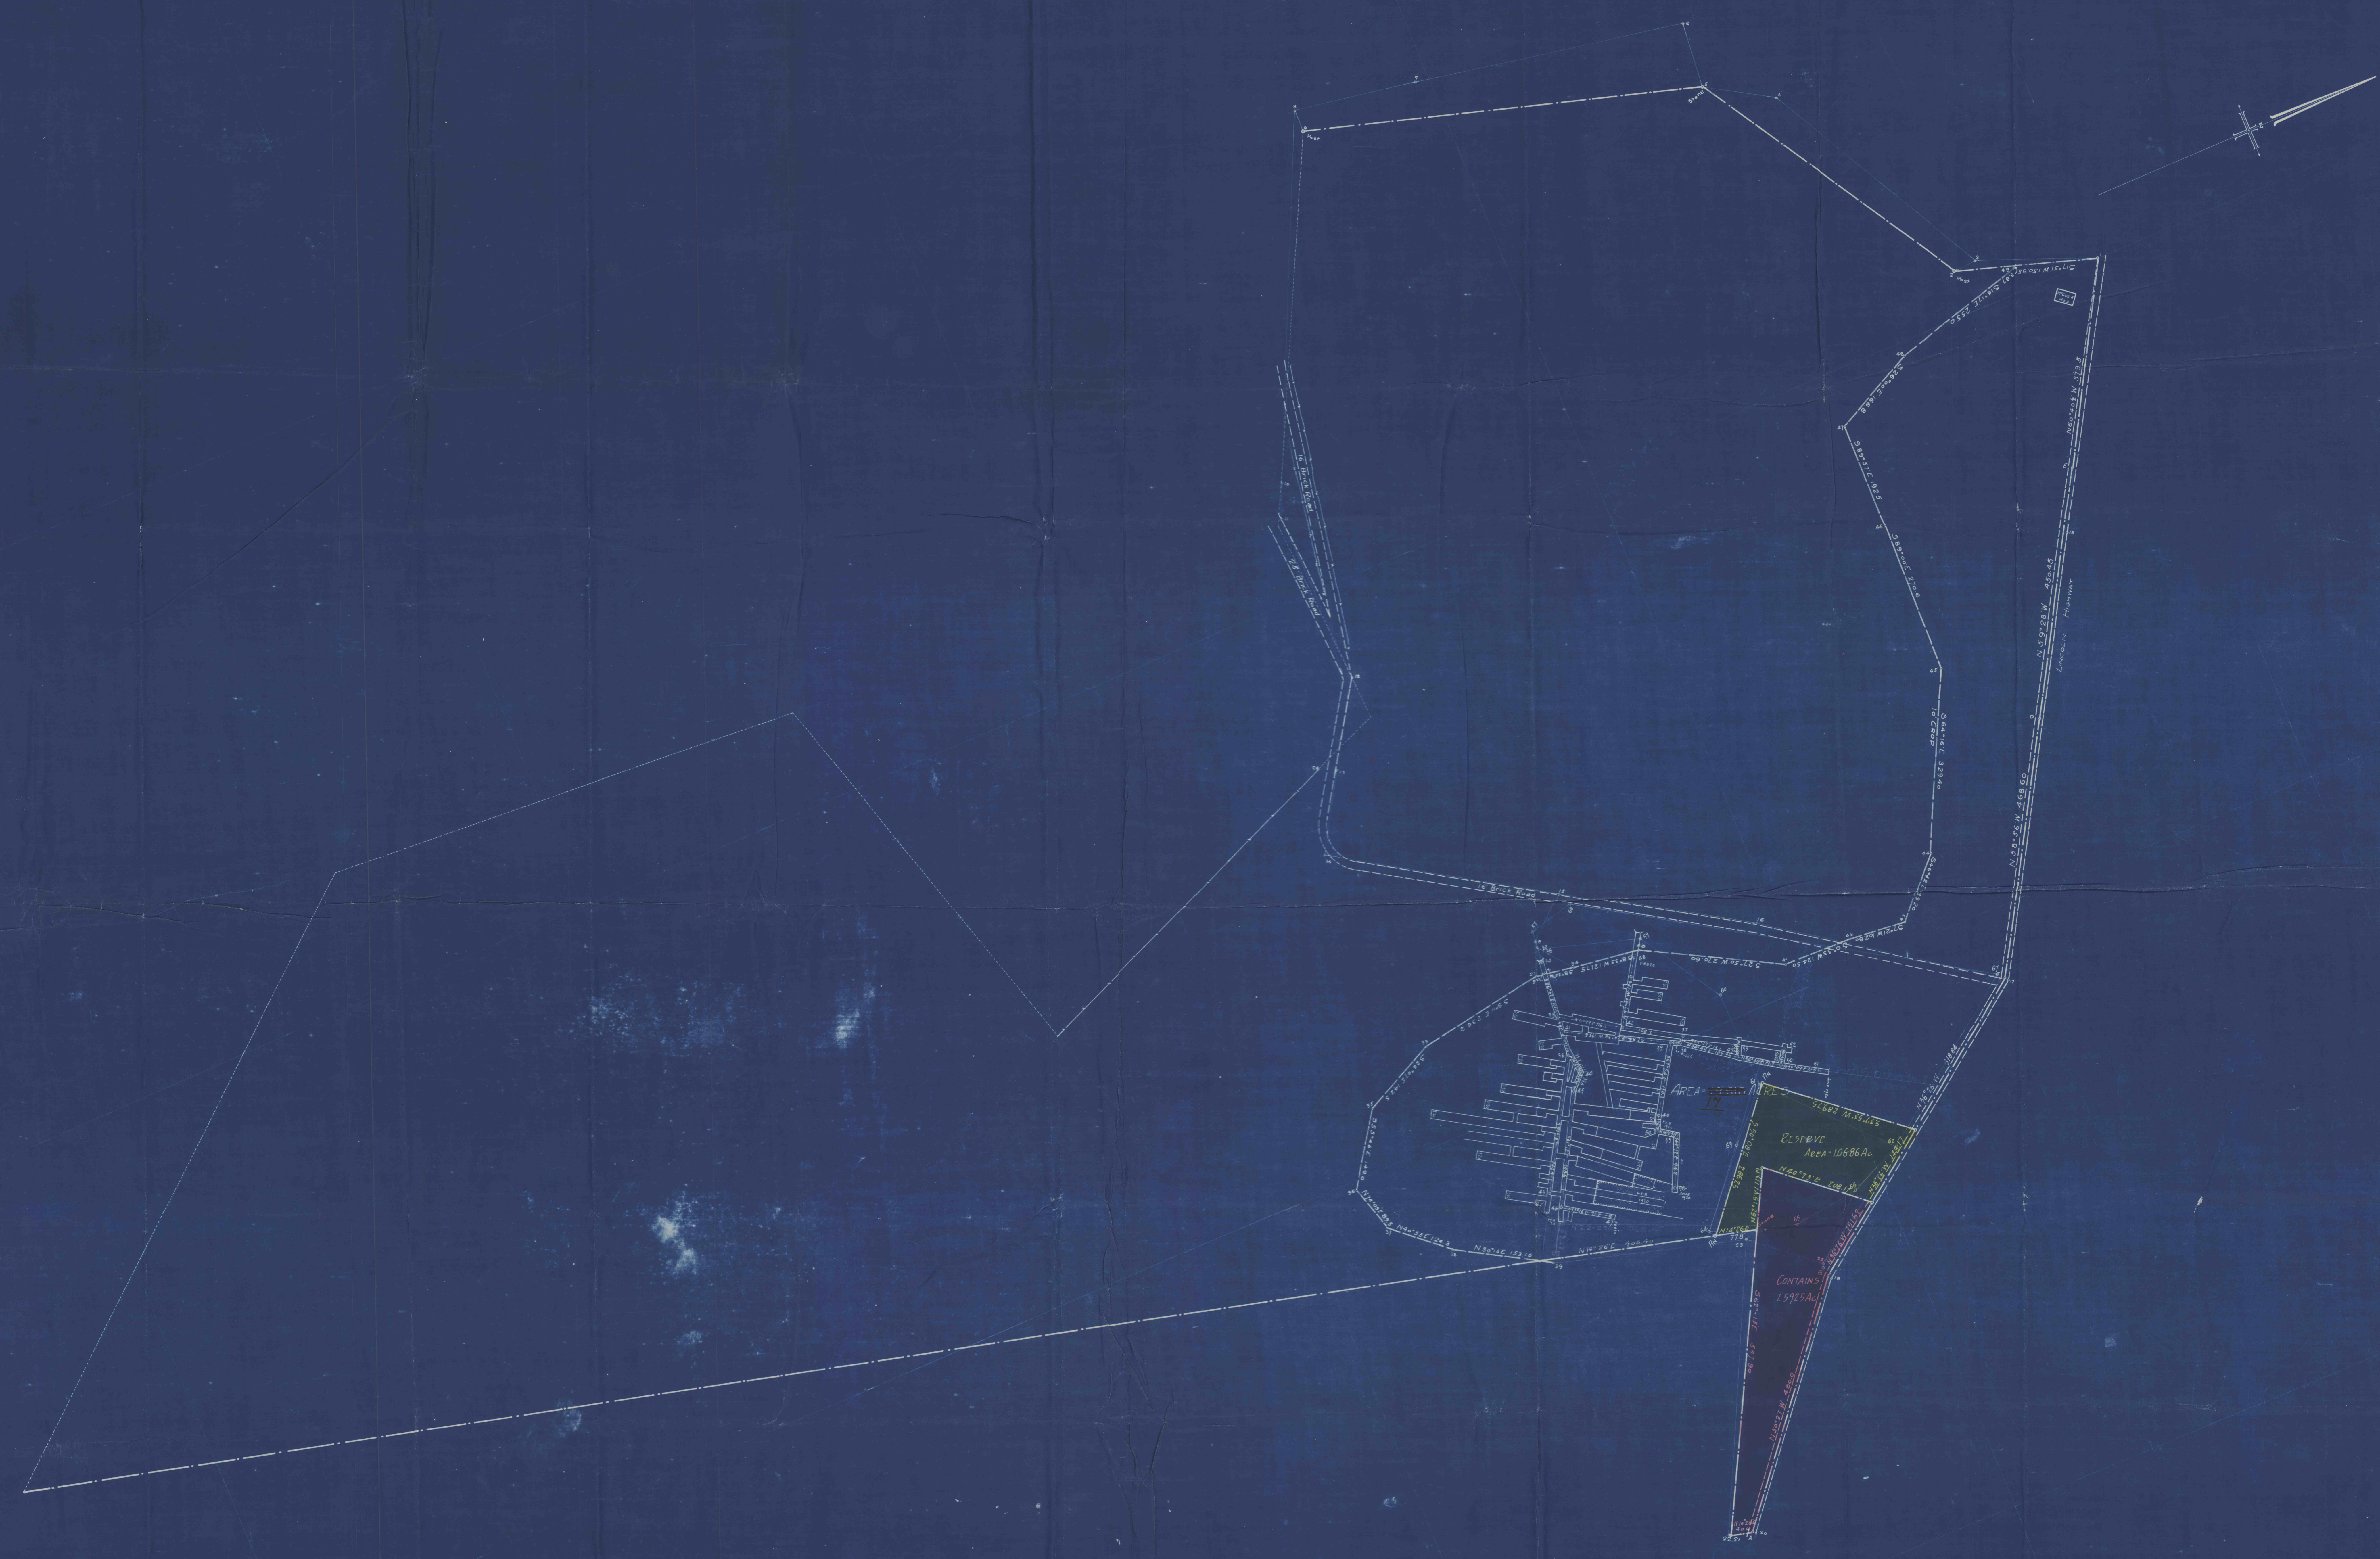

A C OVERHOLT COAL CO  
 CARPENTER MINE  
 IN NORTH VERSAILLES TWP ALLEGHENY COUNTY PA  
 SCALE 1"=100' JULY 24 1918  
 BATON & ELLIOTT  
 Engineers  
 Pittsburgh  
 Pa.  
 Area East of Road - 1234 Ac  
 West - 7296 -

11543

11543