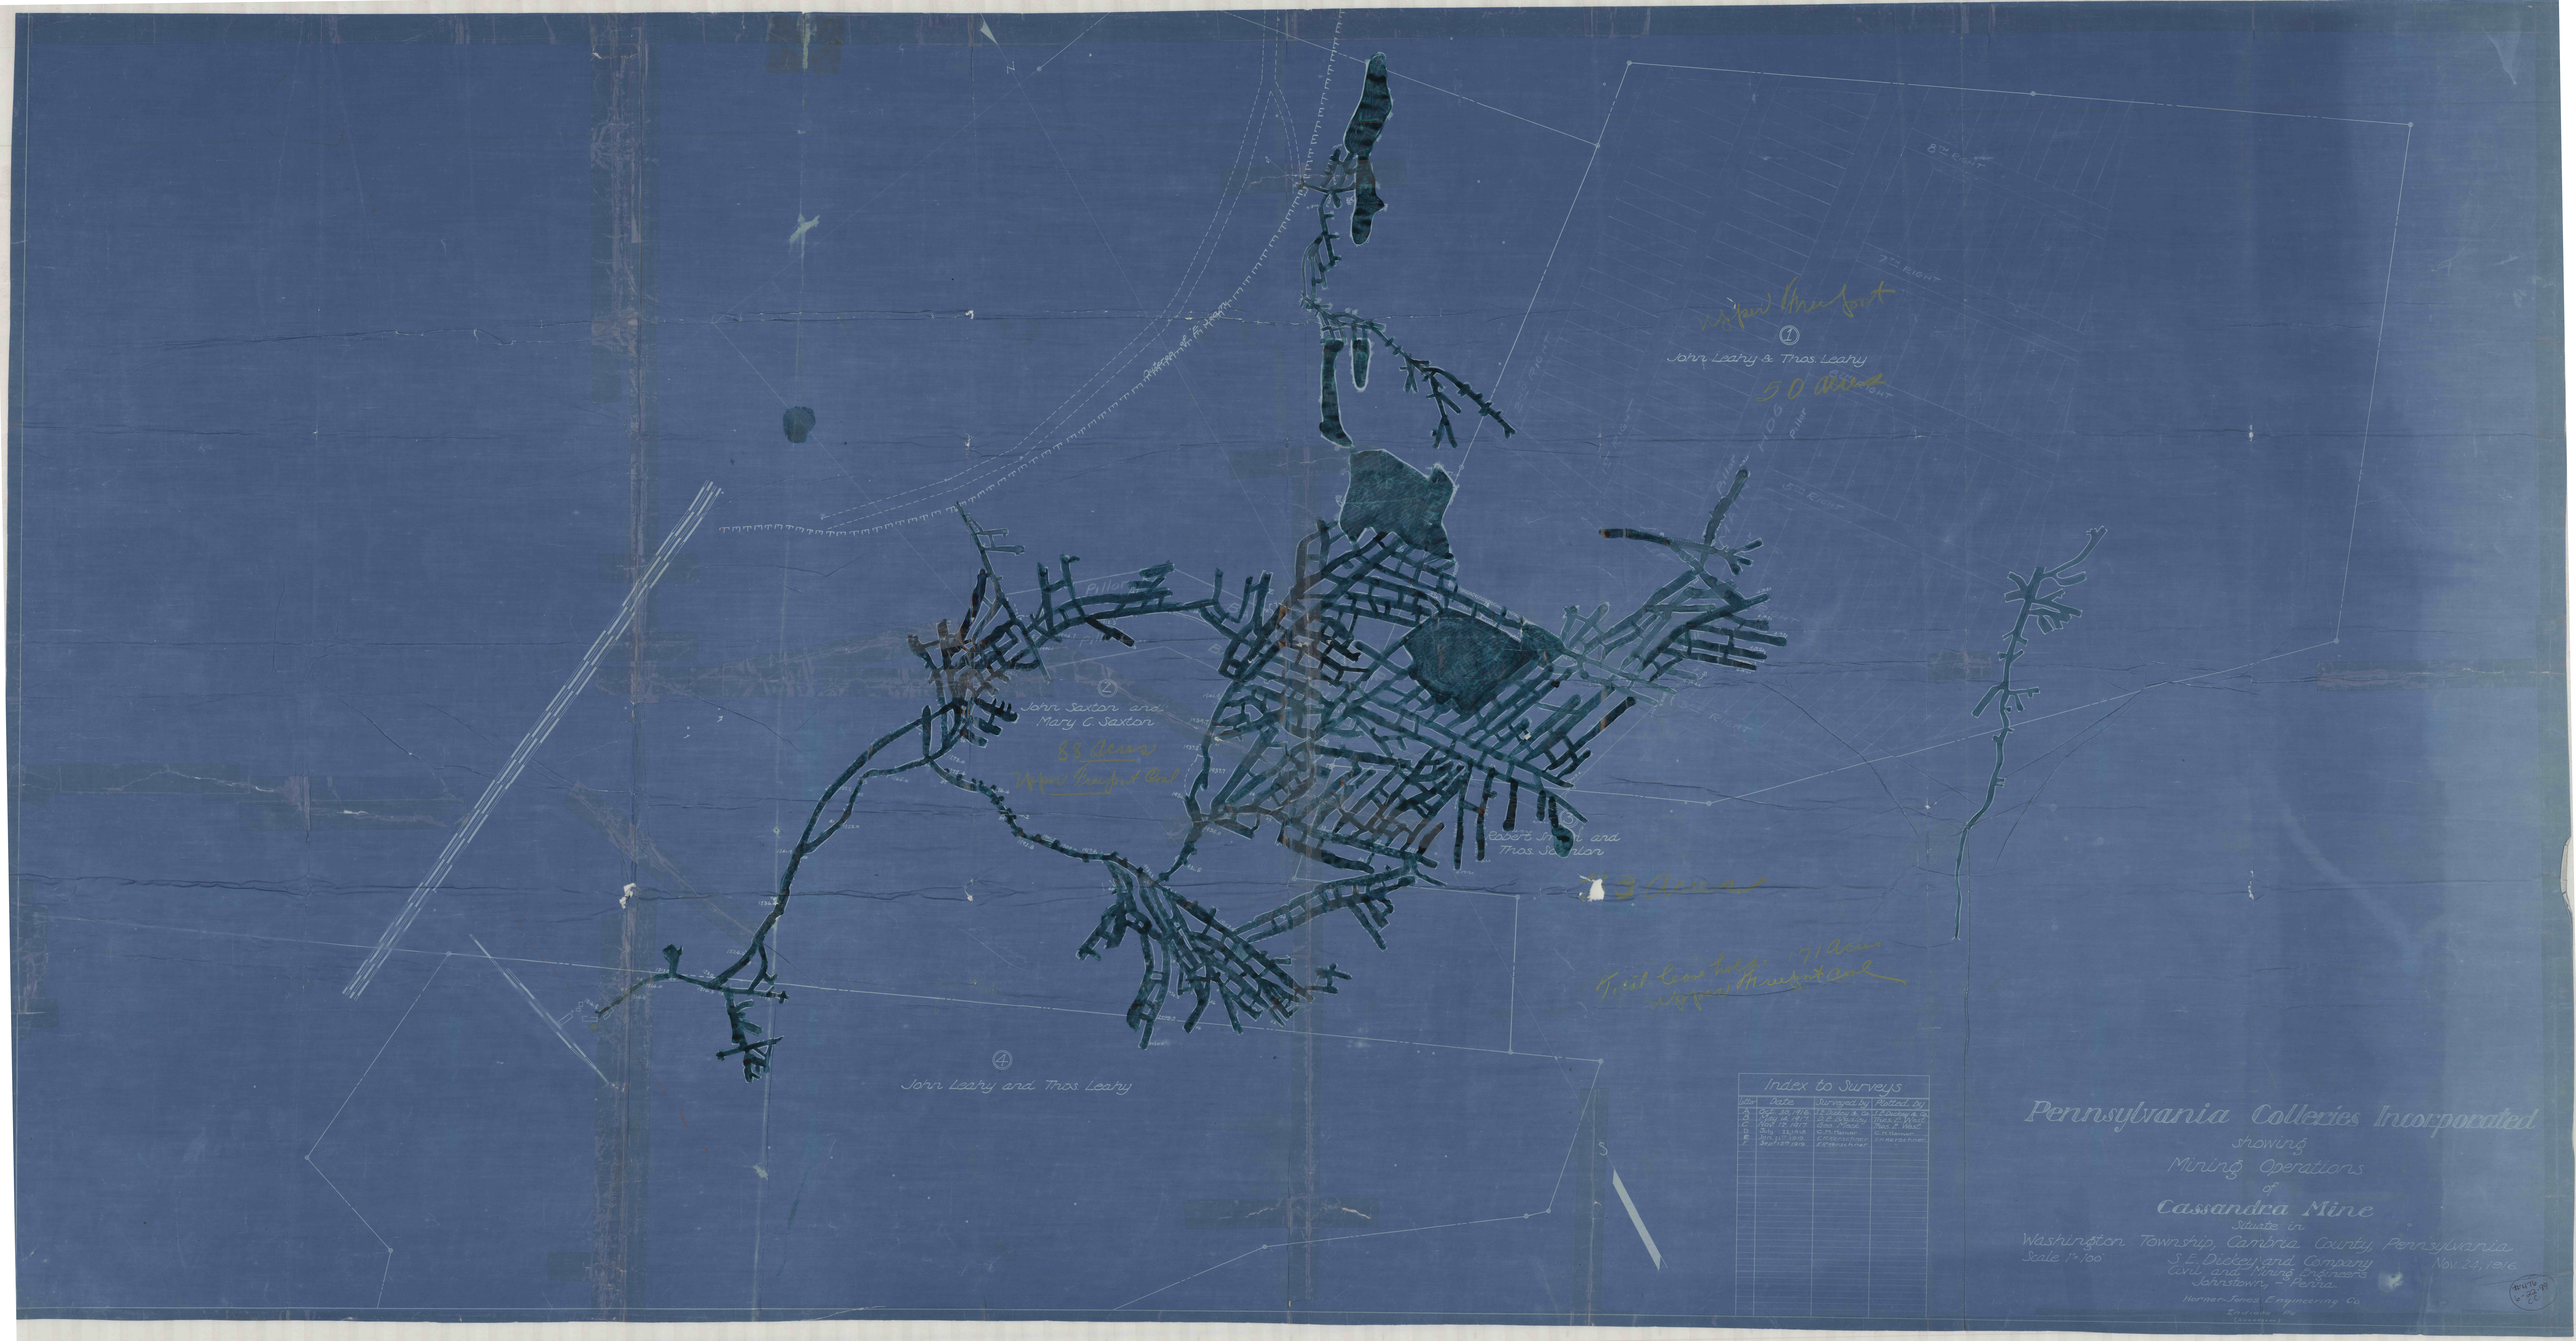
Upper Freeport
1
John Leahy & Thos Leahy
50 Acres
2
John Saxton and
Mary C. Saxton
33 Acres
Upper Freeport Coal
Robert Saxton and
Thos Saxton
73 Acres
Trial Crosscuts 71 Acres
Upper Freeport Coal
4
John Leahy and Thos Leahy
Index to Surveys
No. Date Surveyed by Plotted by
A Oct. 30, 1916 J.S. Dickey & Co J.S. Dickey & Co
B May 4, 1917 J.S. Dickey & Co J.S. Dickey & Co
C Nov 12, 1917 Geo. Mace Geo. Mace
D July 13, 1918 E.C. Hanner E.C. Hanner
E Oct. 17, 1918 E.R. Geschwiner E.R. Geschwiner
F Sept 27, 1919 E.R. Geschwiner E.R. Geschwiner
Pennsylvania Collieries Incorporated
showing
Mining Operations
of
Cassandra Mine
Situate in
Washington Township, Cambria County, Pennsylvania
Scale 1" = 100'
S. F. Dickey and Company
Civil and Mining Engineers
Johnstown, Pa.
Nov. 24, 1916
Horner-Jones Engineering Co.
Engineers
Cincinnati, O.