

240303


LOW MINERAL  
ADJUSTMENT

LOW MINERAL  
ADJUSTMENT

CASWIN NO 1  
EX-GRAVE MINE  
1913, 1919  
OPERATED BY  
BRIGHTON C.C.  
(PREVIOUSLY BY GRACE CO.)  
ON LAND OF P.C. & L. CO

#480  
1-22-99  
C.C.

1" = 100'

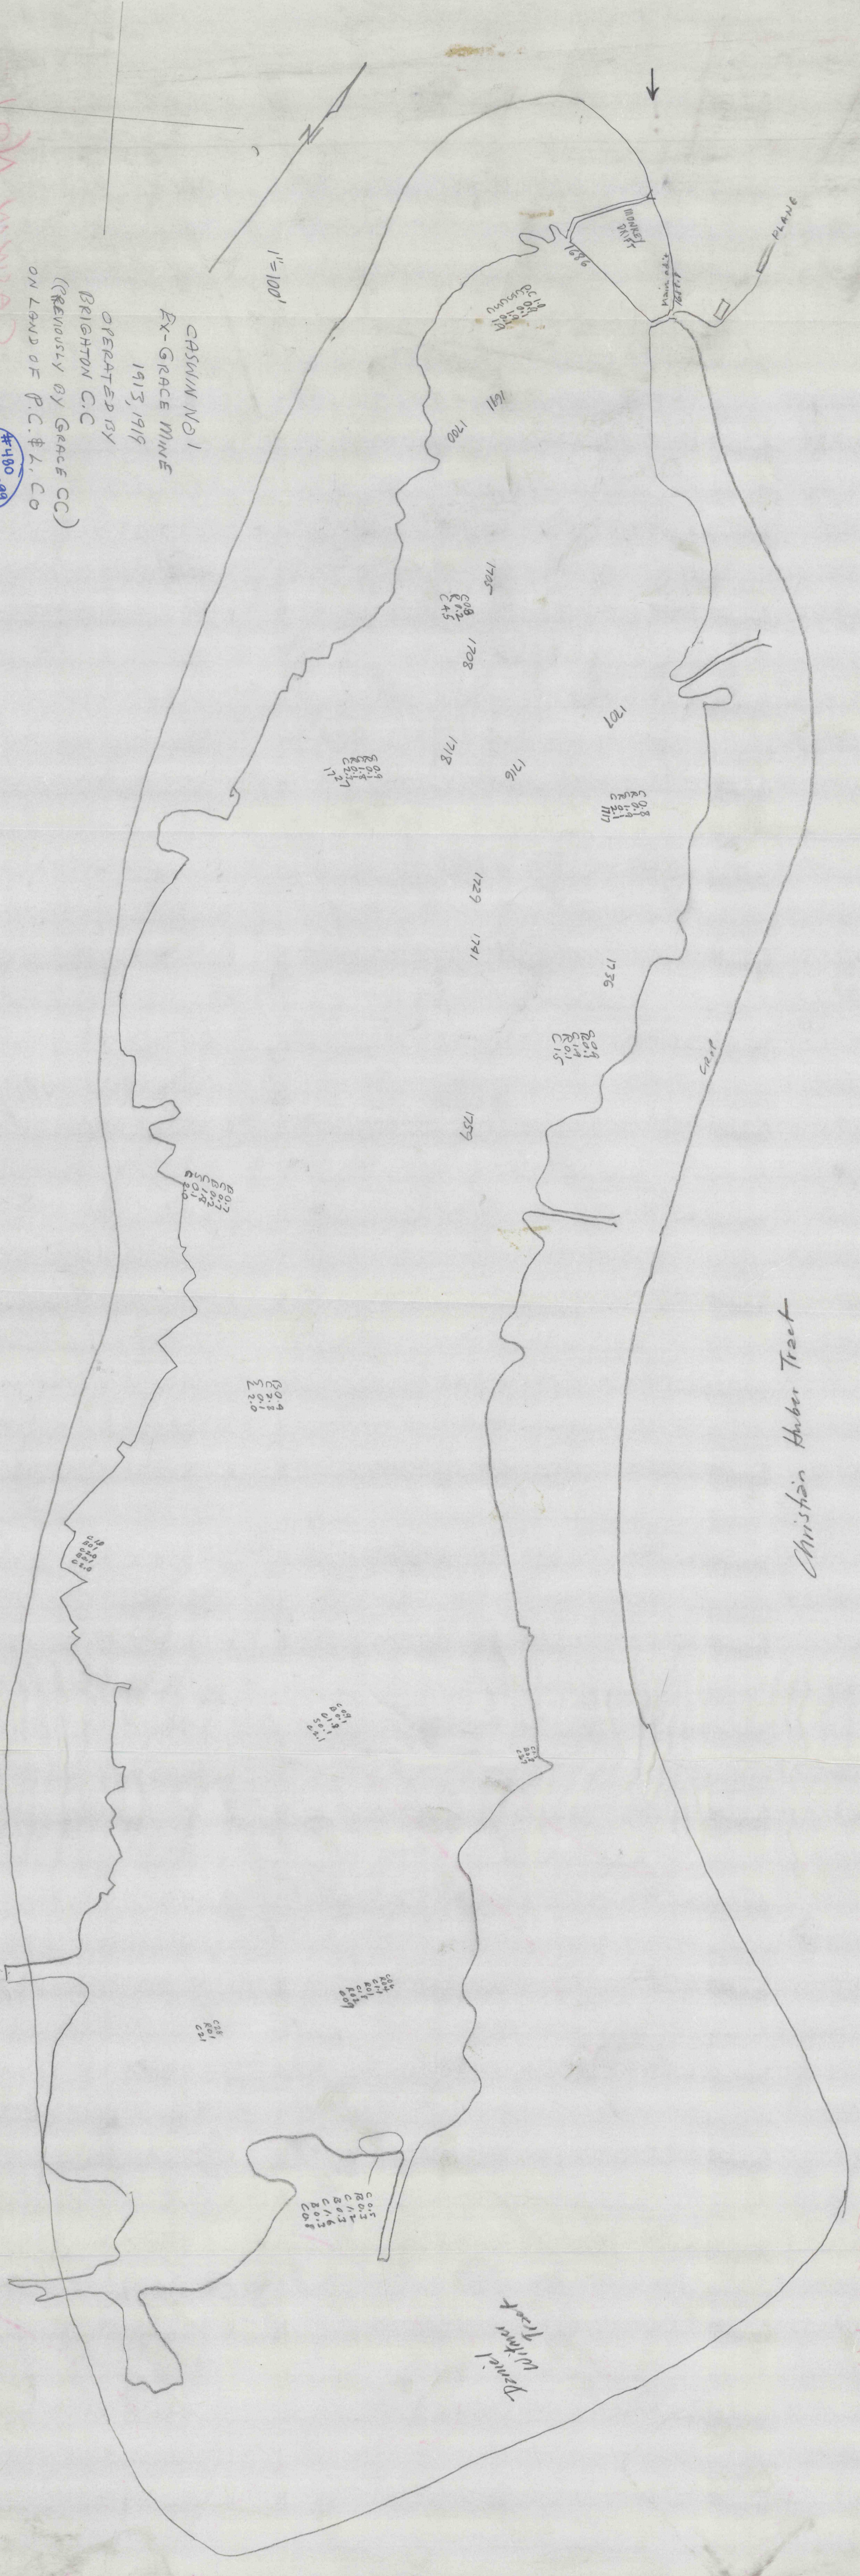

Christian Huber Tract

Daniel Withers Tract

#0480303  
CASWIN NO 1

CASWIN NO 1  
ADJUSTMENT