


#1877
6-22-9
CC

Cataract Mine

Scale = 1" = 100 ft

See Karthaus I. M. Kelley
Karthaus Sup. Eng'r
Clearfield Co.
M. Eastman corner Eng'r

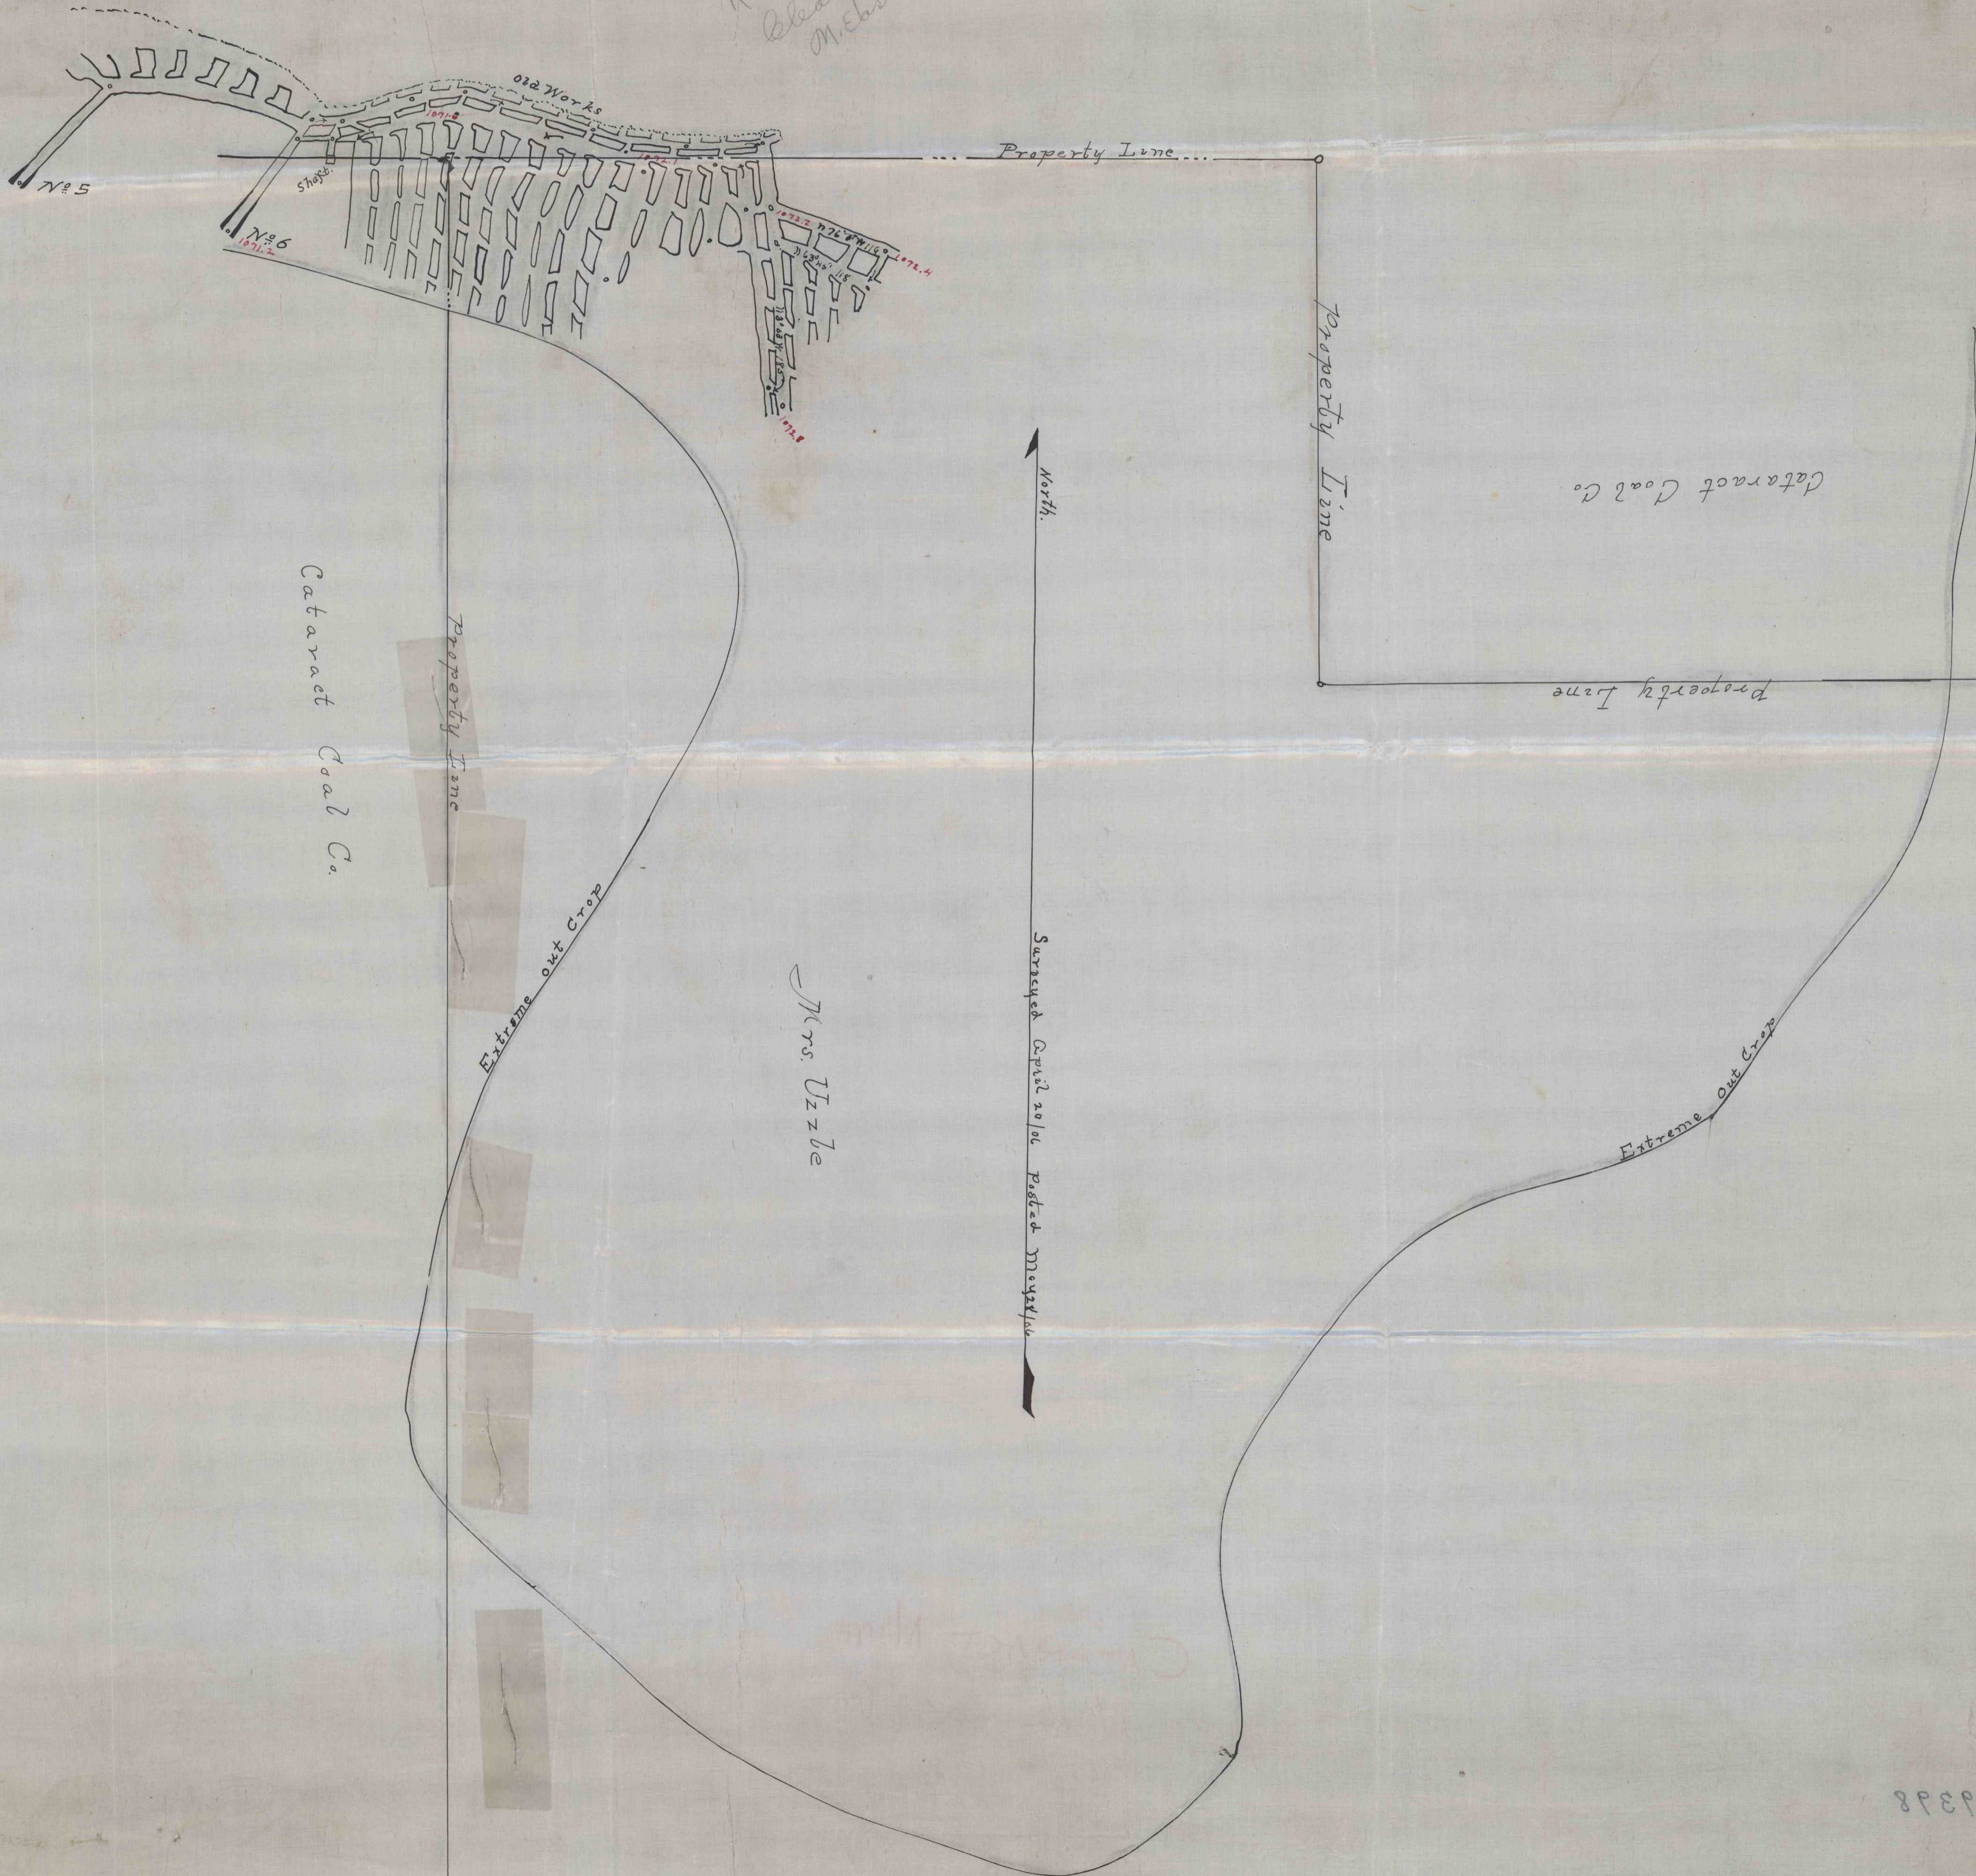

319328