


N 43° 30' E

S 74° 30' W

50 FT. BARRIER

56° 35' E
56,000

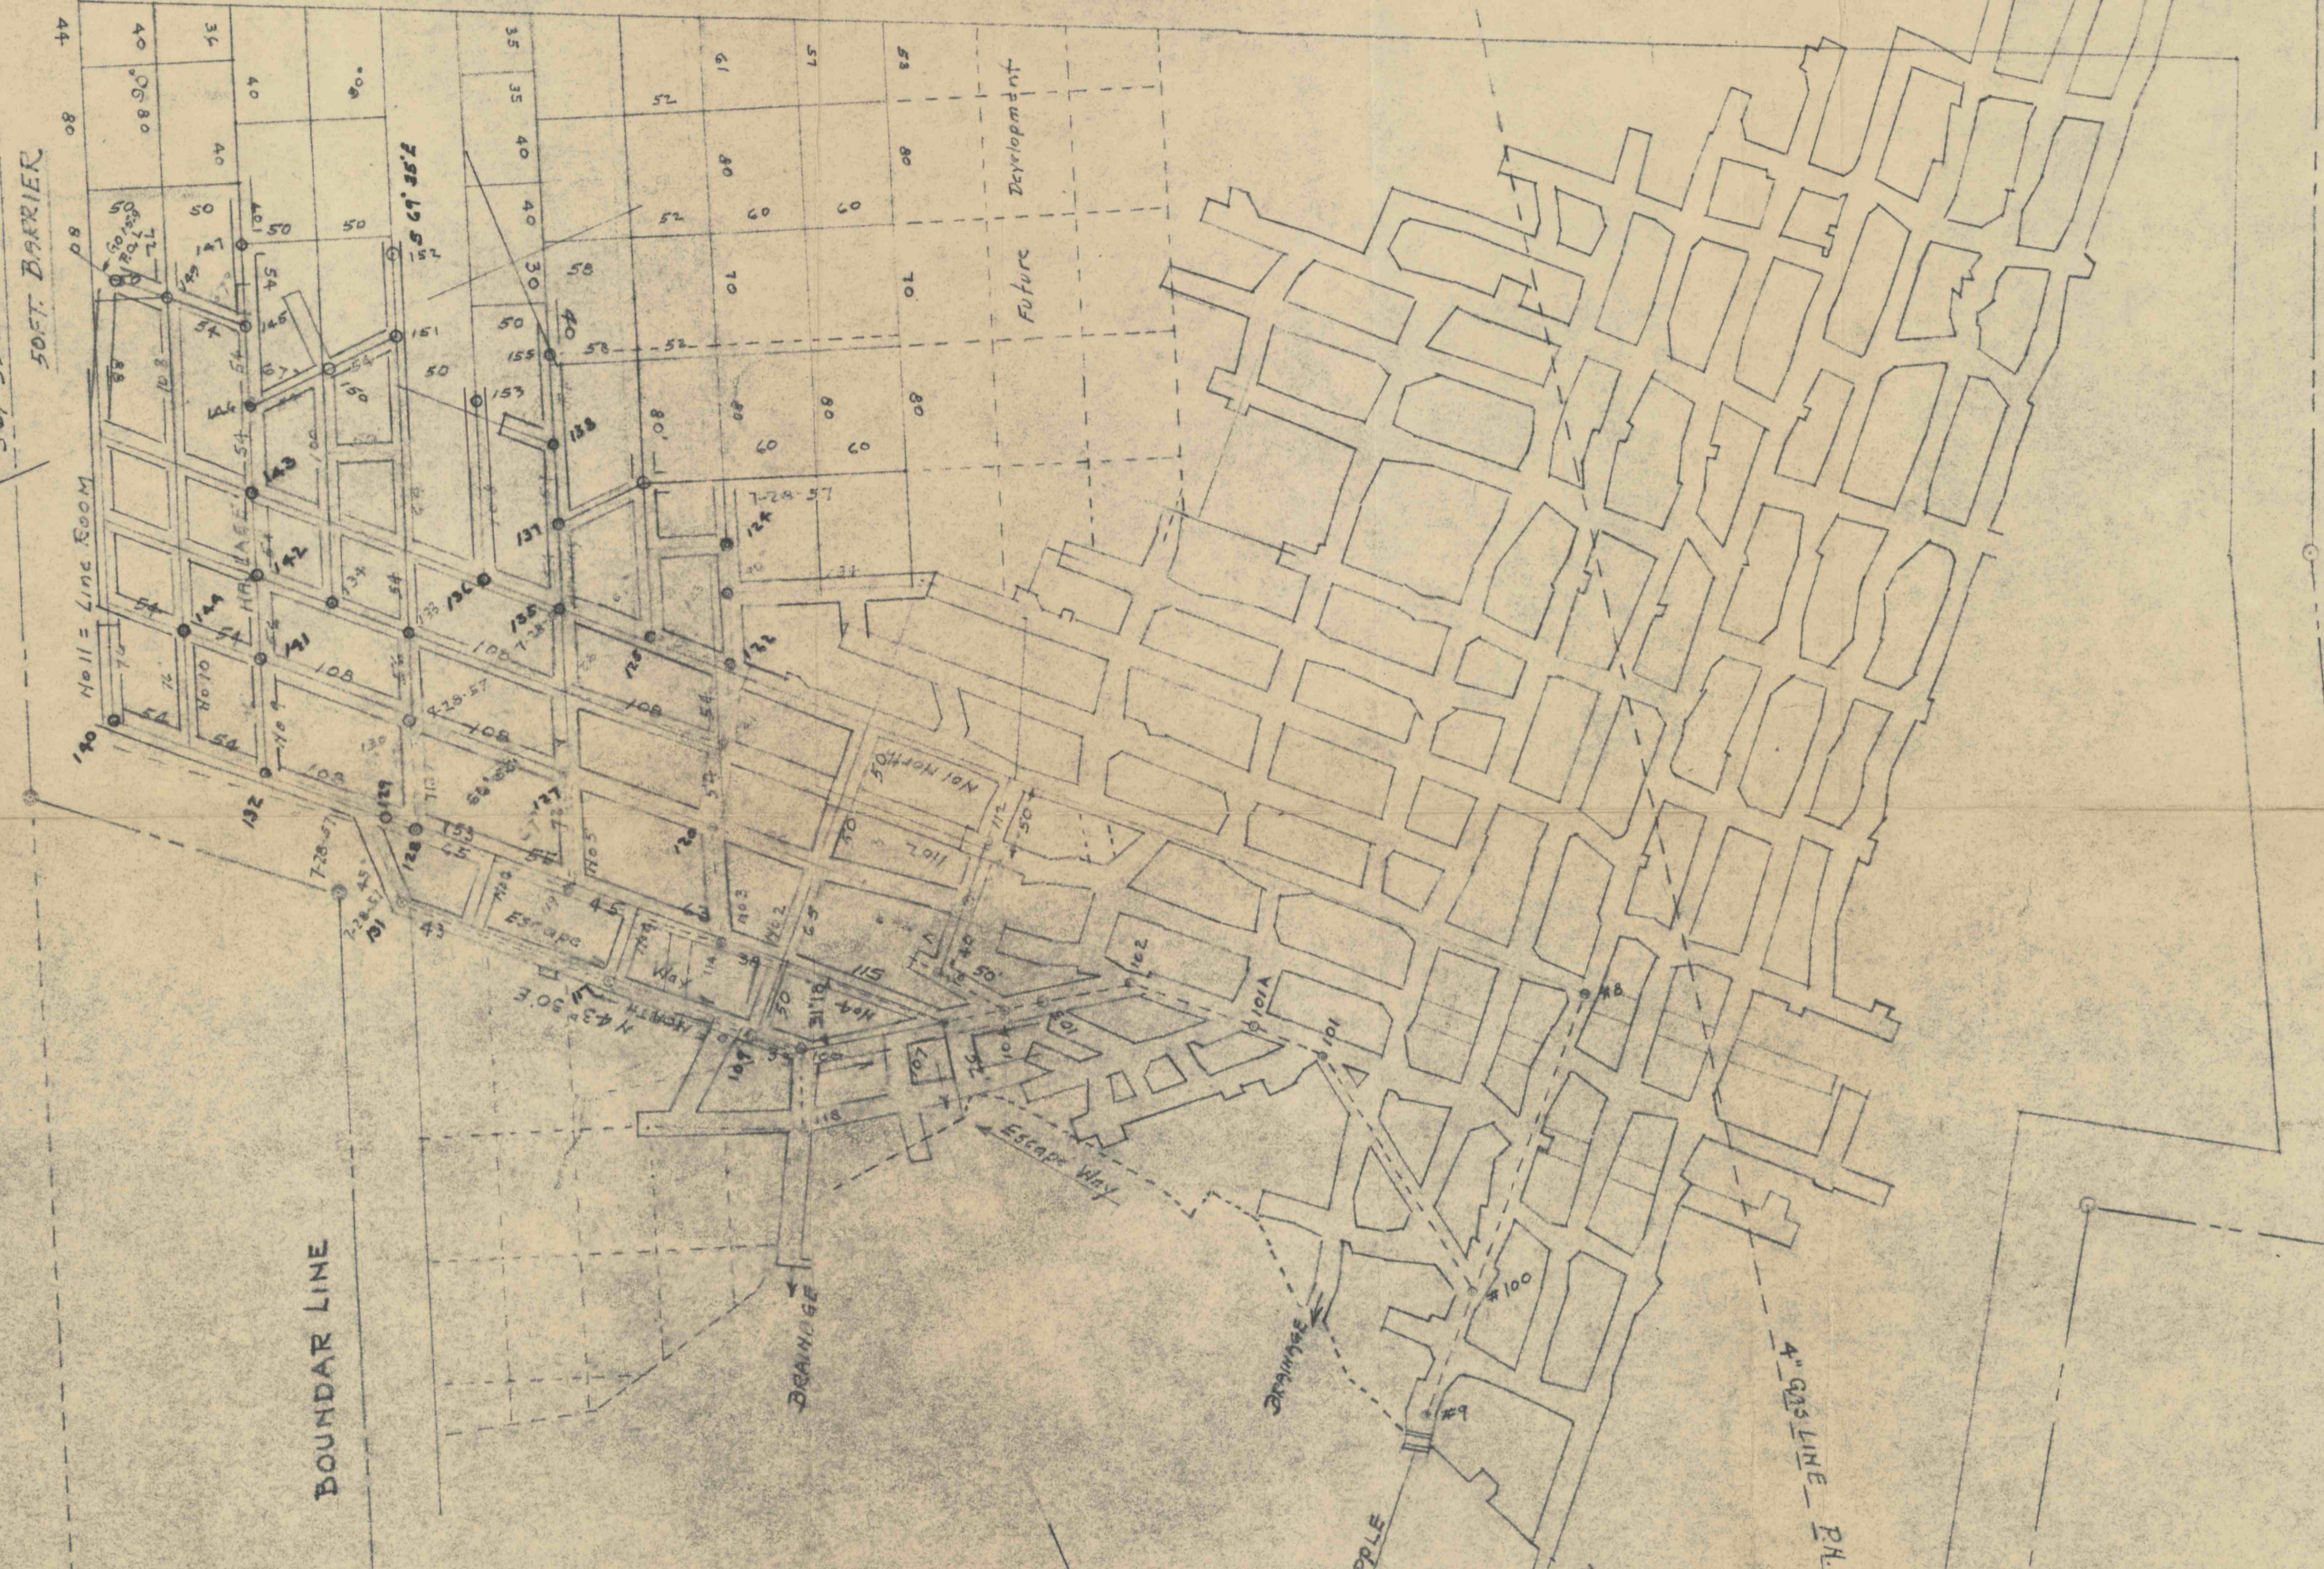

N
55,000 E
55,000 S

55,000 E
55,000 S

To DATE JULY 28 1957
To DATE DEC. 16, 1957

#484
6-22-99
C.C.

AMORE COAL CO.	
CATHRINE No 3 MINE	
MINE MAP AND PROJECTION	
SEWICKLEY SEAM	
FRANK J. SHOLTIS	FAIRCHANCE PA.
DUNKARD TWP.	GREENE CO. PA.
FRANK J. SHOLTIS	OPERATOR

© BY C.H.R.

Scale 1"=100'