

H. D. STRAW

M. EARENS



MINE WORKED OUT JULY 1ST 1934

No. 2 MINE WORKED OUT JULY 1ST 1934


JAMES McNEAL

MAP OF - No 1 MINE

Operated by the
CENTRAL MOSHANNON COAL MINING CO
 Scale 1" = 100'
 Mameisdorf Dunkle & Custer M.E.

Locate near McCarty, Pa.

PETER PATTERSON

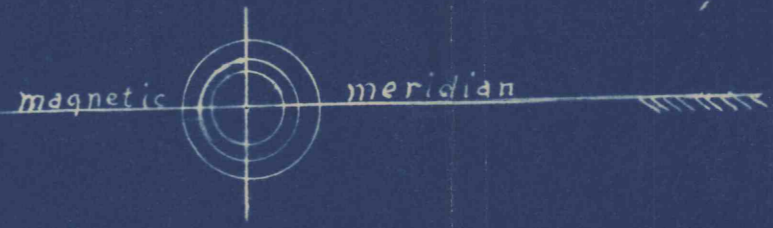

#487
 11-19-33
 CC

2516-27