

A  
 B  
 C  
 MO  
 MP  
 MQ  
 NO  
 NP  
 NQ  
 UY  
 UZ  
 VA  
 WX  
 WY  
 WZ  
 YZ  

DATE OF SURVEYS

|                |      |
|----------------|------|
| MAY 10, 1916   | E-10 |
| OCT 12, 1917   | F-10 |
| JAN 16, 1917   | G-10 |
| MAY 14, 1917   | H-10 |
| AUG 24, 1917   | I-10 |
| DEC 6, 1917    | J-10 |
| MAY 10, 1918   | K-10 |
| AUG 23, 1918   | L-10 |
| NOV 19, 1918   | M-10 |
| FEB 16, 1919   | N-10 |
| MAY 16, 1919   | O-10 |
| SEPT 5, 1919   | P-10 |
| SEPT 14, 1920  | Q-10 |
| APR 14, 1920   | R-10 |
| SEPT 28, 1920  | S-10 |
| FEB 8, 1921    | T-10 |
| JAN 25, 1923   | U-10 |
| JUL 19, 1923   | V-10 |
| NOV 9, 1923    | W-10 |
| FEB 4, 1923    | X-10 |
| ALIO 5, 1923   | Y-10 |
| JAN 22, 1928   | Z-10 |
| DEC 10, 1928   | A-11 |
| JUL 9, 1927    | B-11 |
| JAN 10, 1928   | C-11 |
| MARCH 25, 1941 | E-11 |
| JUNE 10, 1941  | F-11 |
| SEPT 30, 1941  | G-11 |
| APR 1, 1944    | H-11 |
| JUNE 2, 1944   | I-11 |

DATE OF SURVEYS


MAP OF THE  
**CENTURY MINE**  
 SITUATE IN  
 REDSTONE TOWNSHIP - FAYETTE CO. PA.  
 CENTURY COKE CO.

SCALE 1" = 100'

JUNE 15, 1907

SHEET No. 1

SHEET No. 4

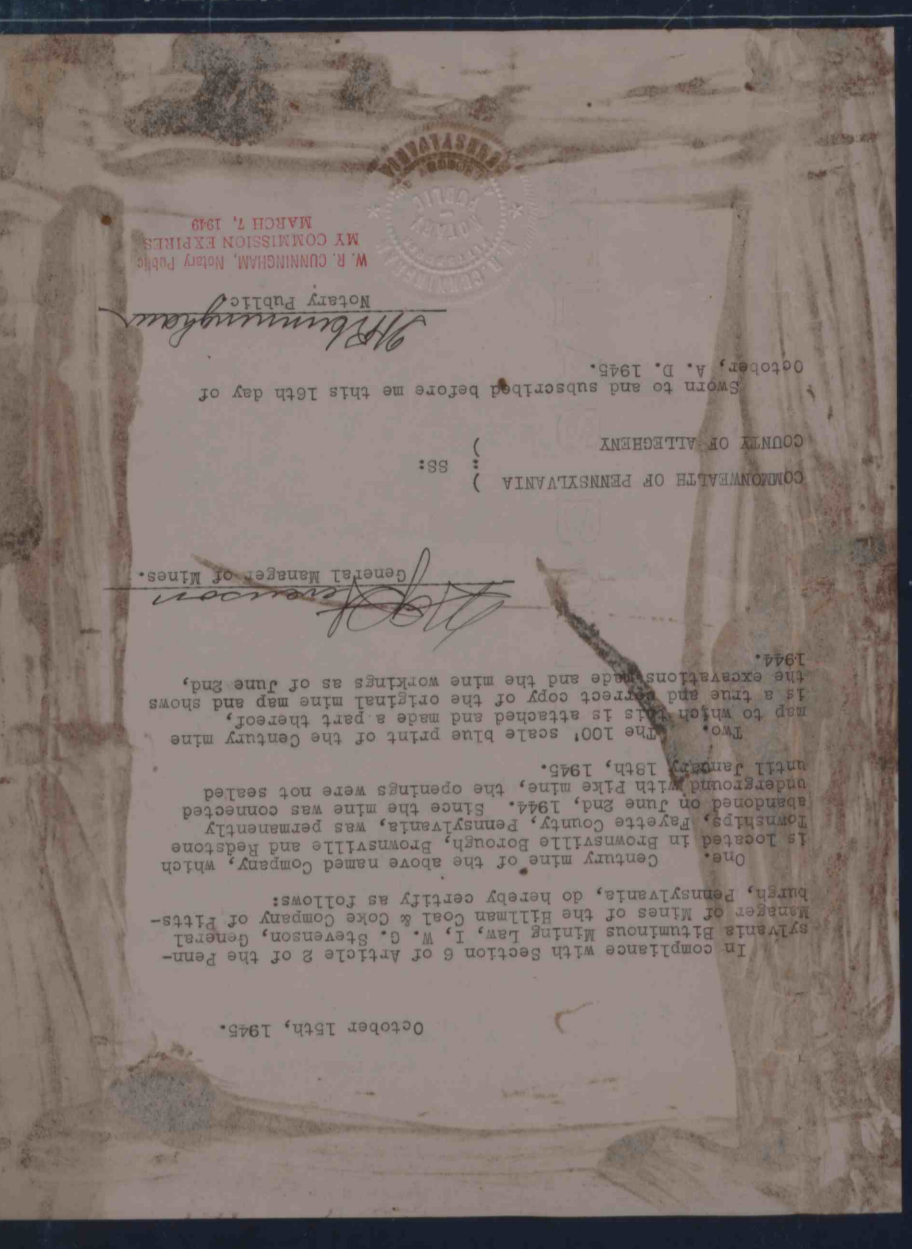

SHEET No. 6

APPARATUS GARWOOD TRACT  
 FINA - CONN COKE CO.