
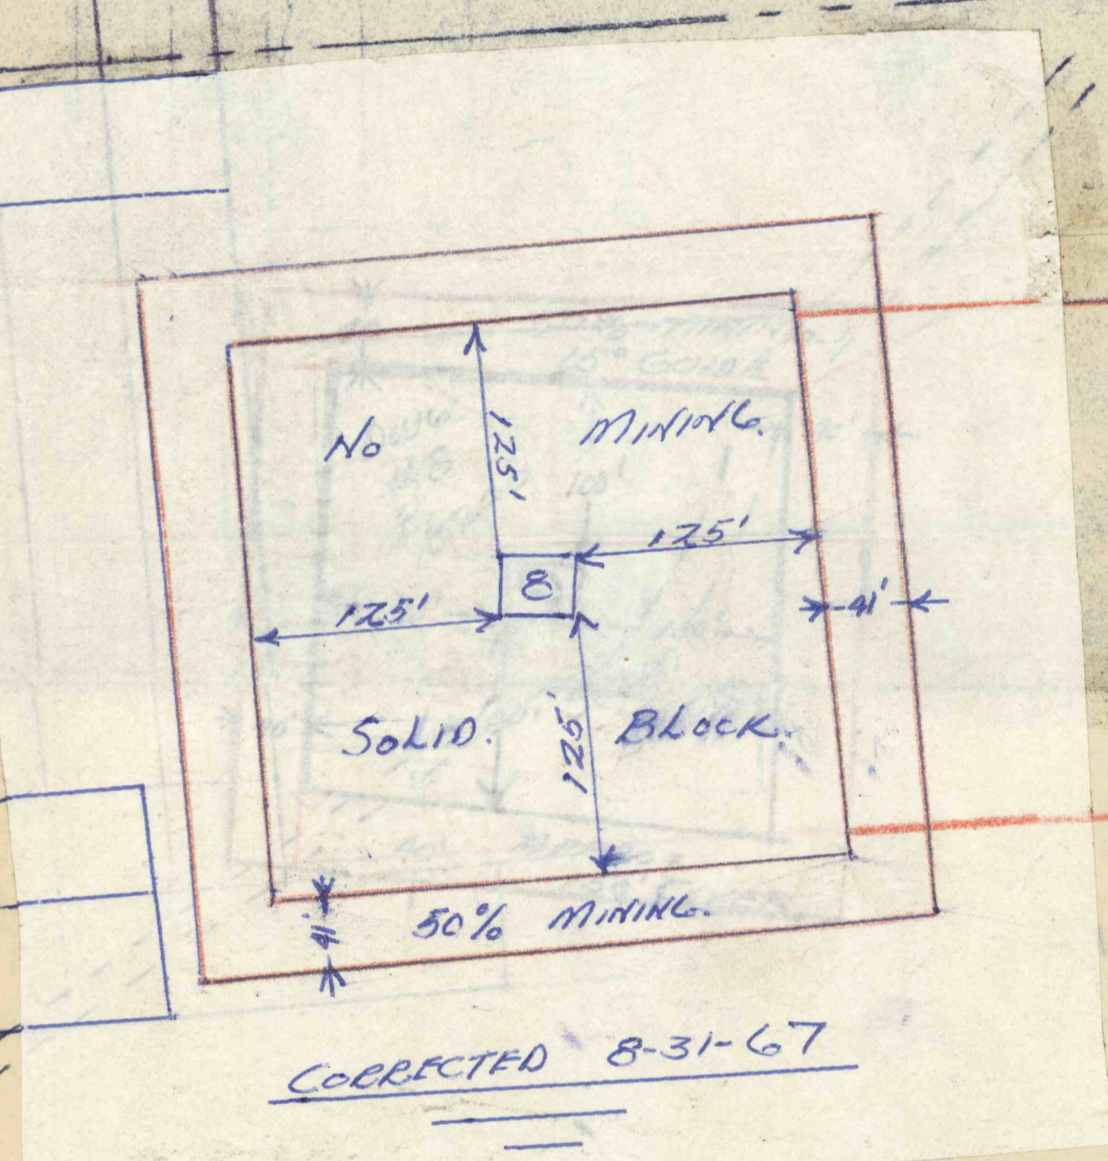


JEFF WRIGHT TRACK

J. WRIGHT TRACK

Jas. WRIGHT TRACK

Lewis SPICHER TRACK

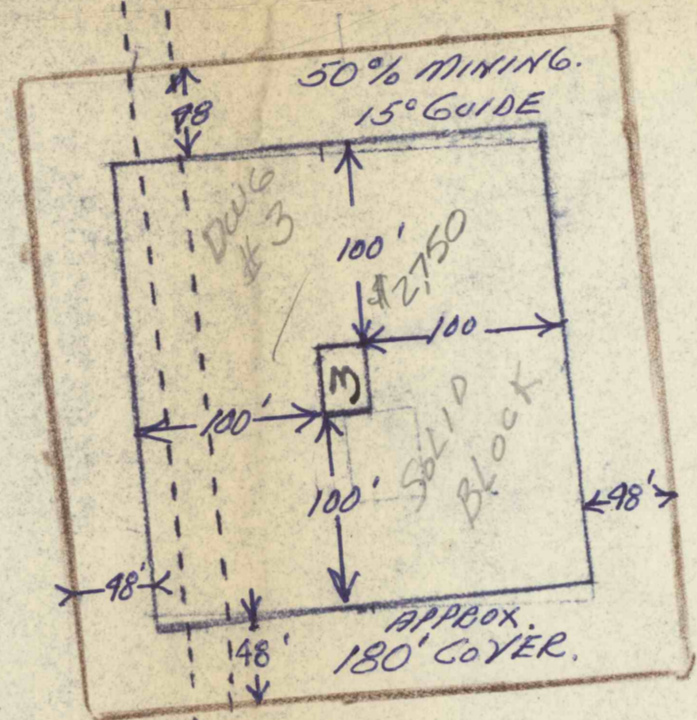

J. Mc MILLEN TRACK

J. BARTLEBAUGH

S. SPICHER

W. WRIGHT

CHURCH PROPERTY

D. FYOCK

D. BLOSE

M. SPICHER

6 MONTH EXTENSION'S
7-10-67 TO 1-10-68

RECD
SEP 1 1967
DEPT. OF MINE SUPERVISION

RECD
AUG 7 1967
DEPT. OF MINE SUPERVISION

DEED MINE PROPERTY MAP
THE WILLIAM CESSINA MINE
GRANT TOWNSHIP, INDIANA COUNTY
JULY 10, 1967 SCALE 1"=100'
DRAWN BY JOHN C. PASSMORE
SEAM OF COAL 'D'

100'