


SAGER COAL CO. - CHAMBERS MINE

- 6 MONTH PROJECTION
AUG. 15, 1966 to FEB. 15, 1967

- COAL LEFT IN FOR SUPPORT

SCALE: 1"=100' AUG. 15, 1966

Thomas Amick, Jr. R.S. 7094-E

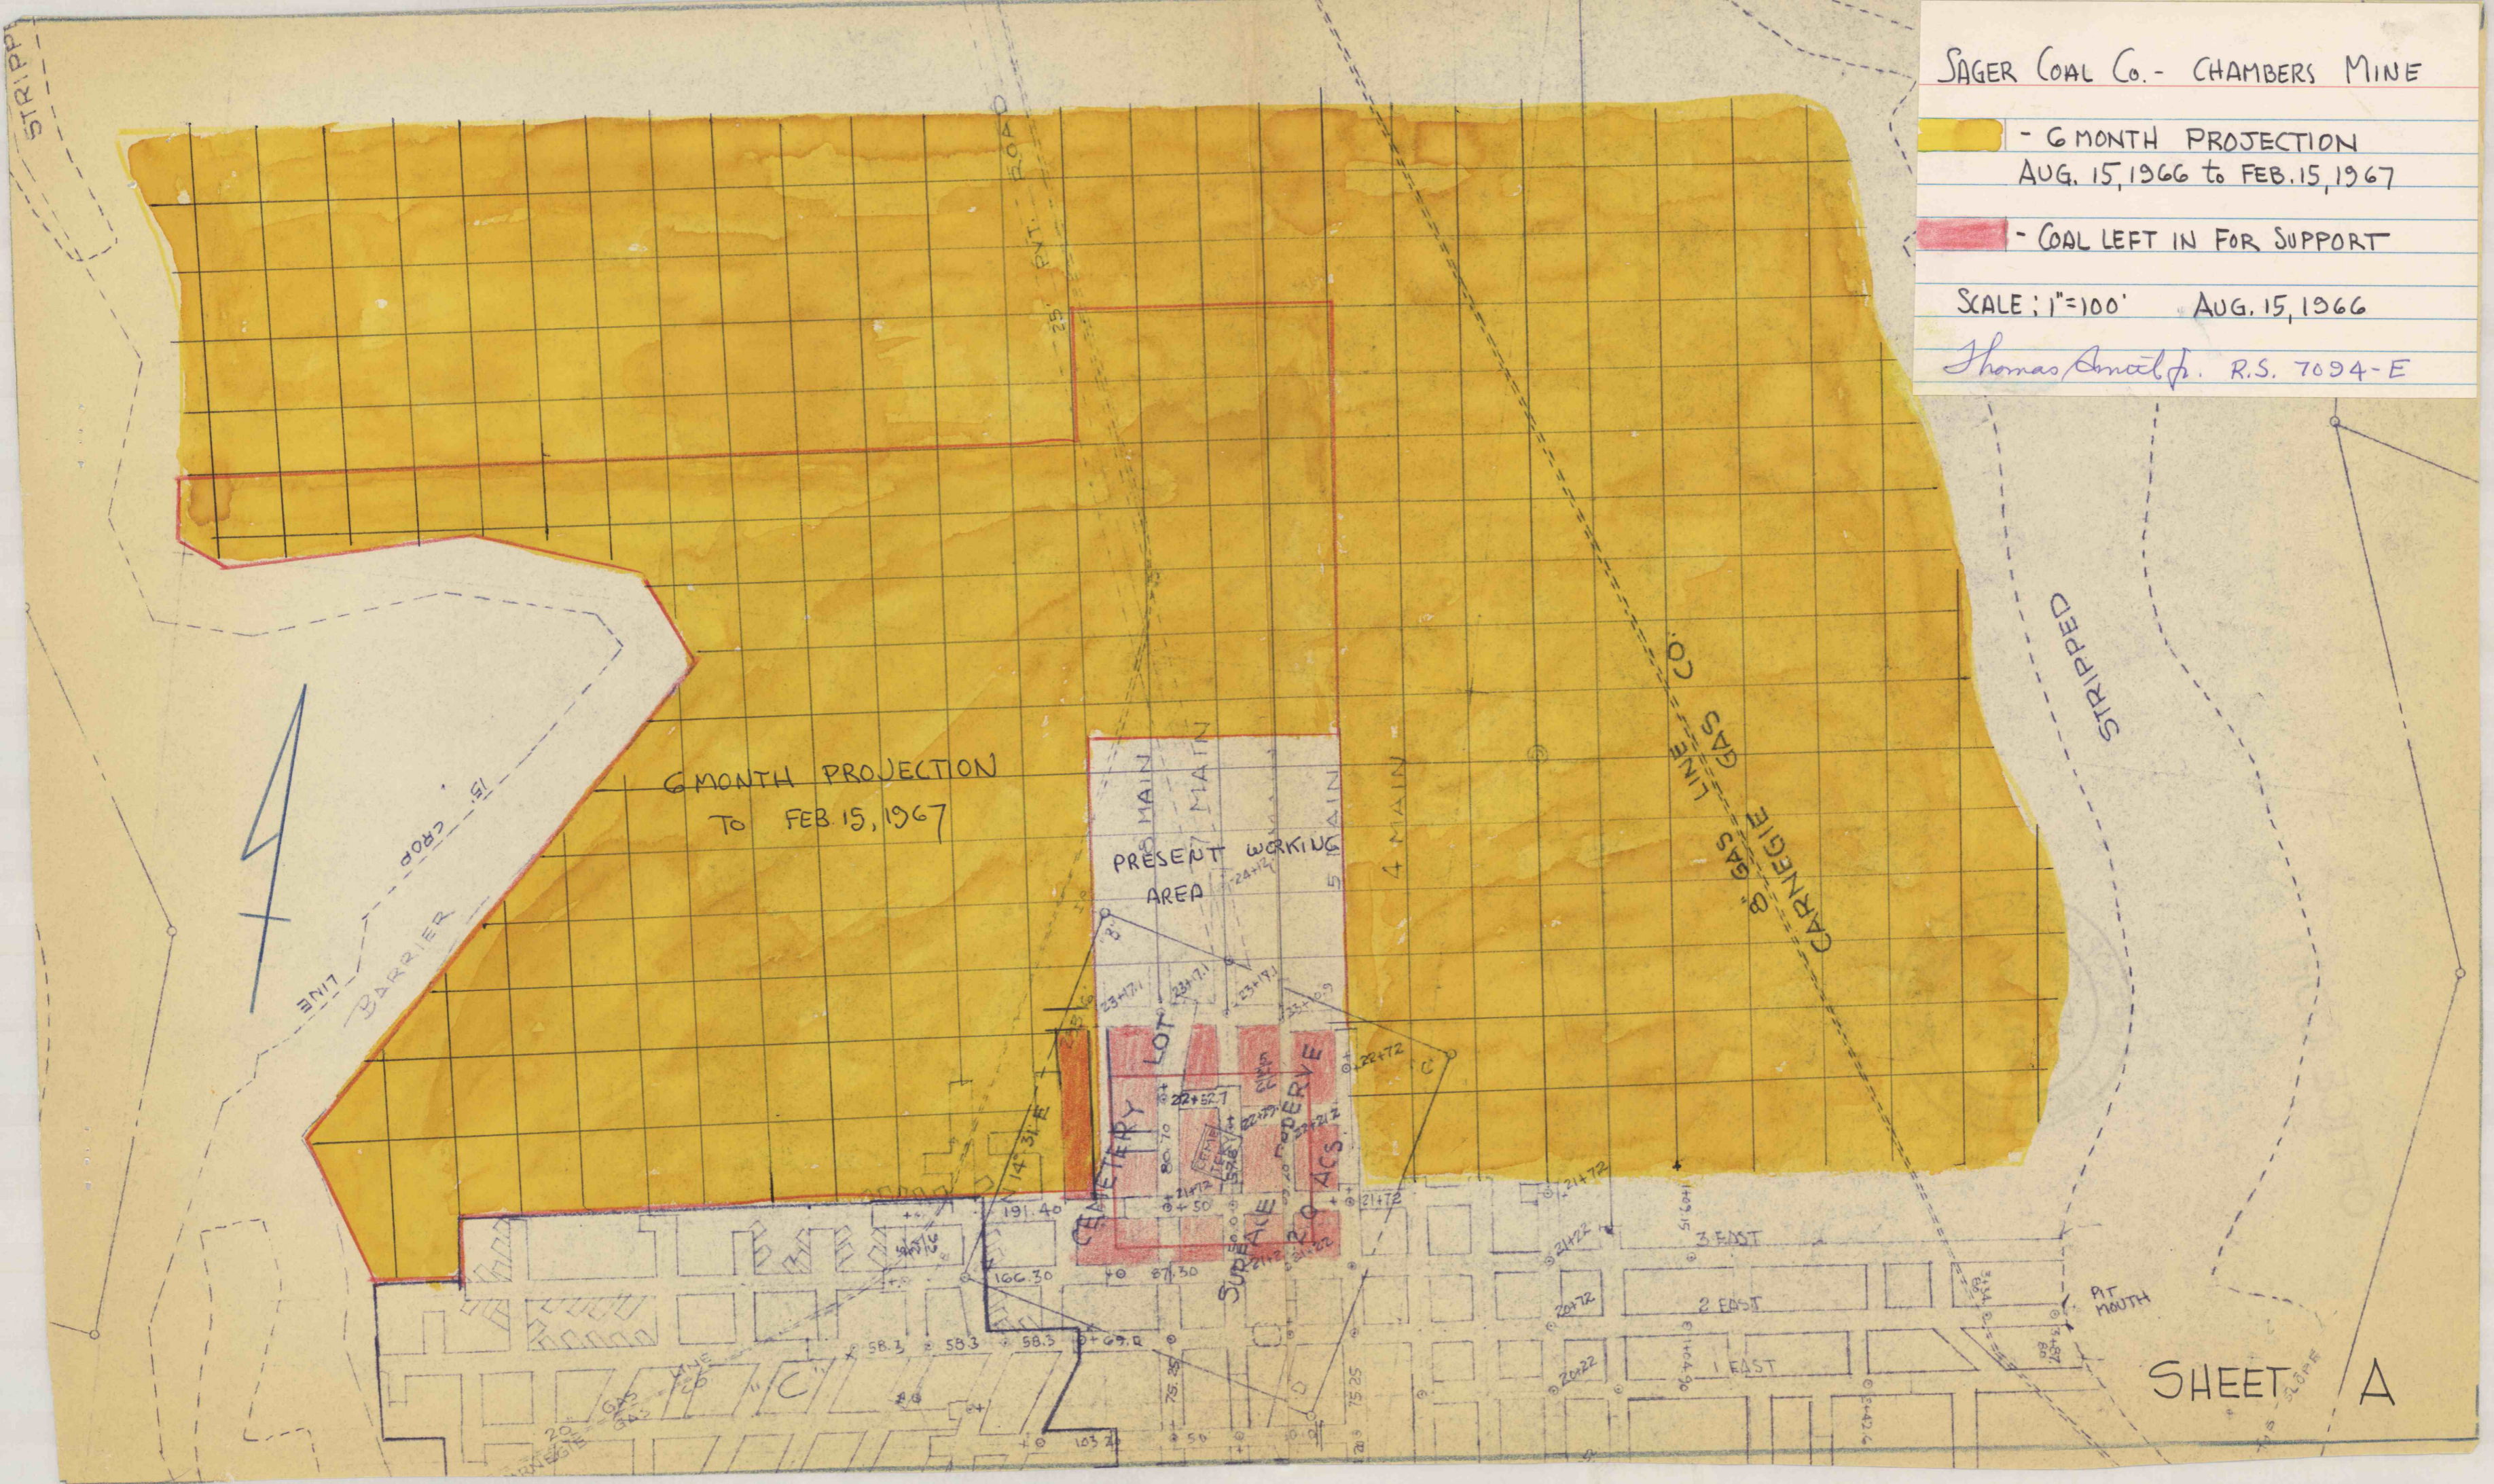

SHEET A