


DATE OF SURVEY.	
AUG. 20, 1907	= A.
DEC. 9, 1907	= B.
28, 1908	= C.
NOV. 24, 1909	= D.
JULY 13, 1910	= E.
NOV. 19, 1910	= F.
MAY 20, 1911	= G.
OCT. 6, 1912	= H.
APR. 2, 1913	= I.
JAN. 10, 1916	= J.
AUG. 16, 1917	= K.
JAN. 20, 1917	= L.
OCT. 18, 1917	= M.
NOV. 19, 1918	= N.
APR. 26, 1919	= O.
OCT. 25, 1919	= P.

SURFACE AREA 8.136 ACRES =   
 COAL AREA 53.289 ACRES =   
 COAL MINED TO JAN. 1, 1920 40.103 ACRES  
 COAL REMAINING 13.286 ACRES

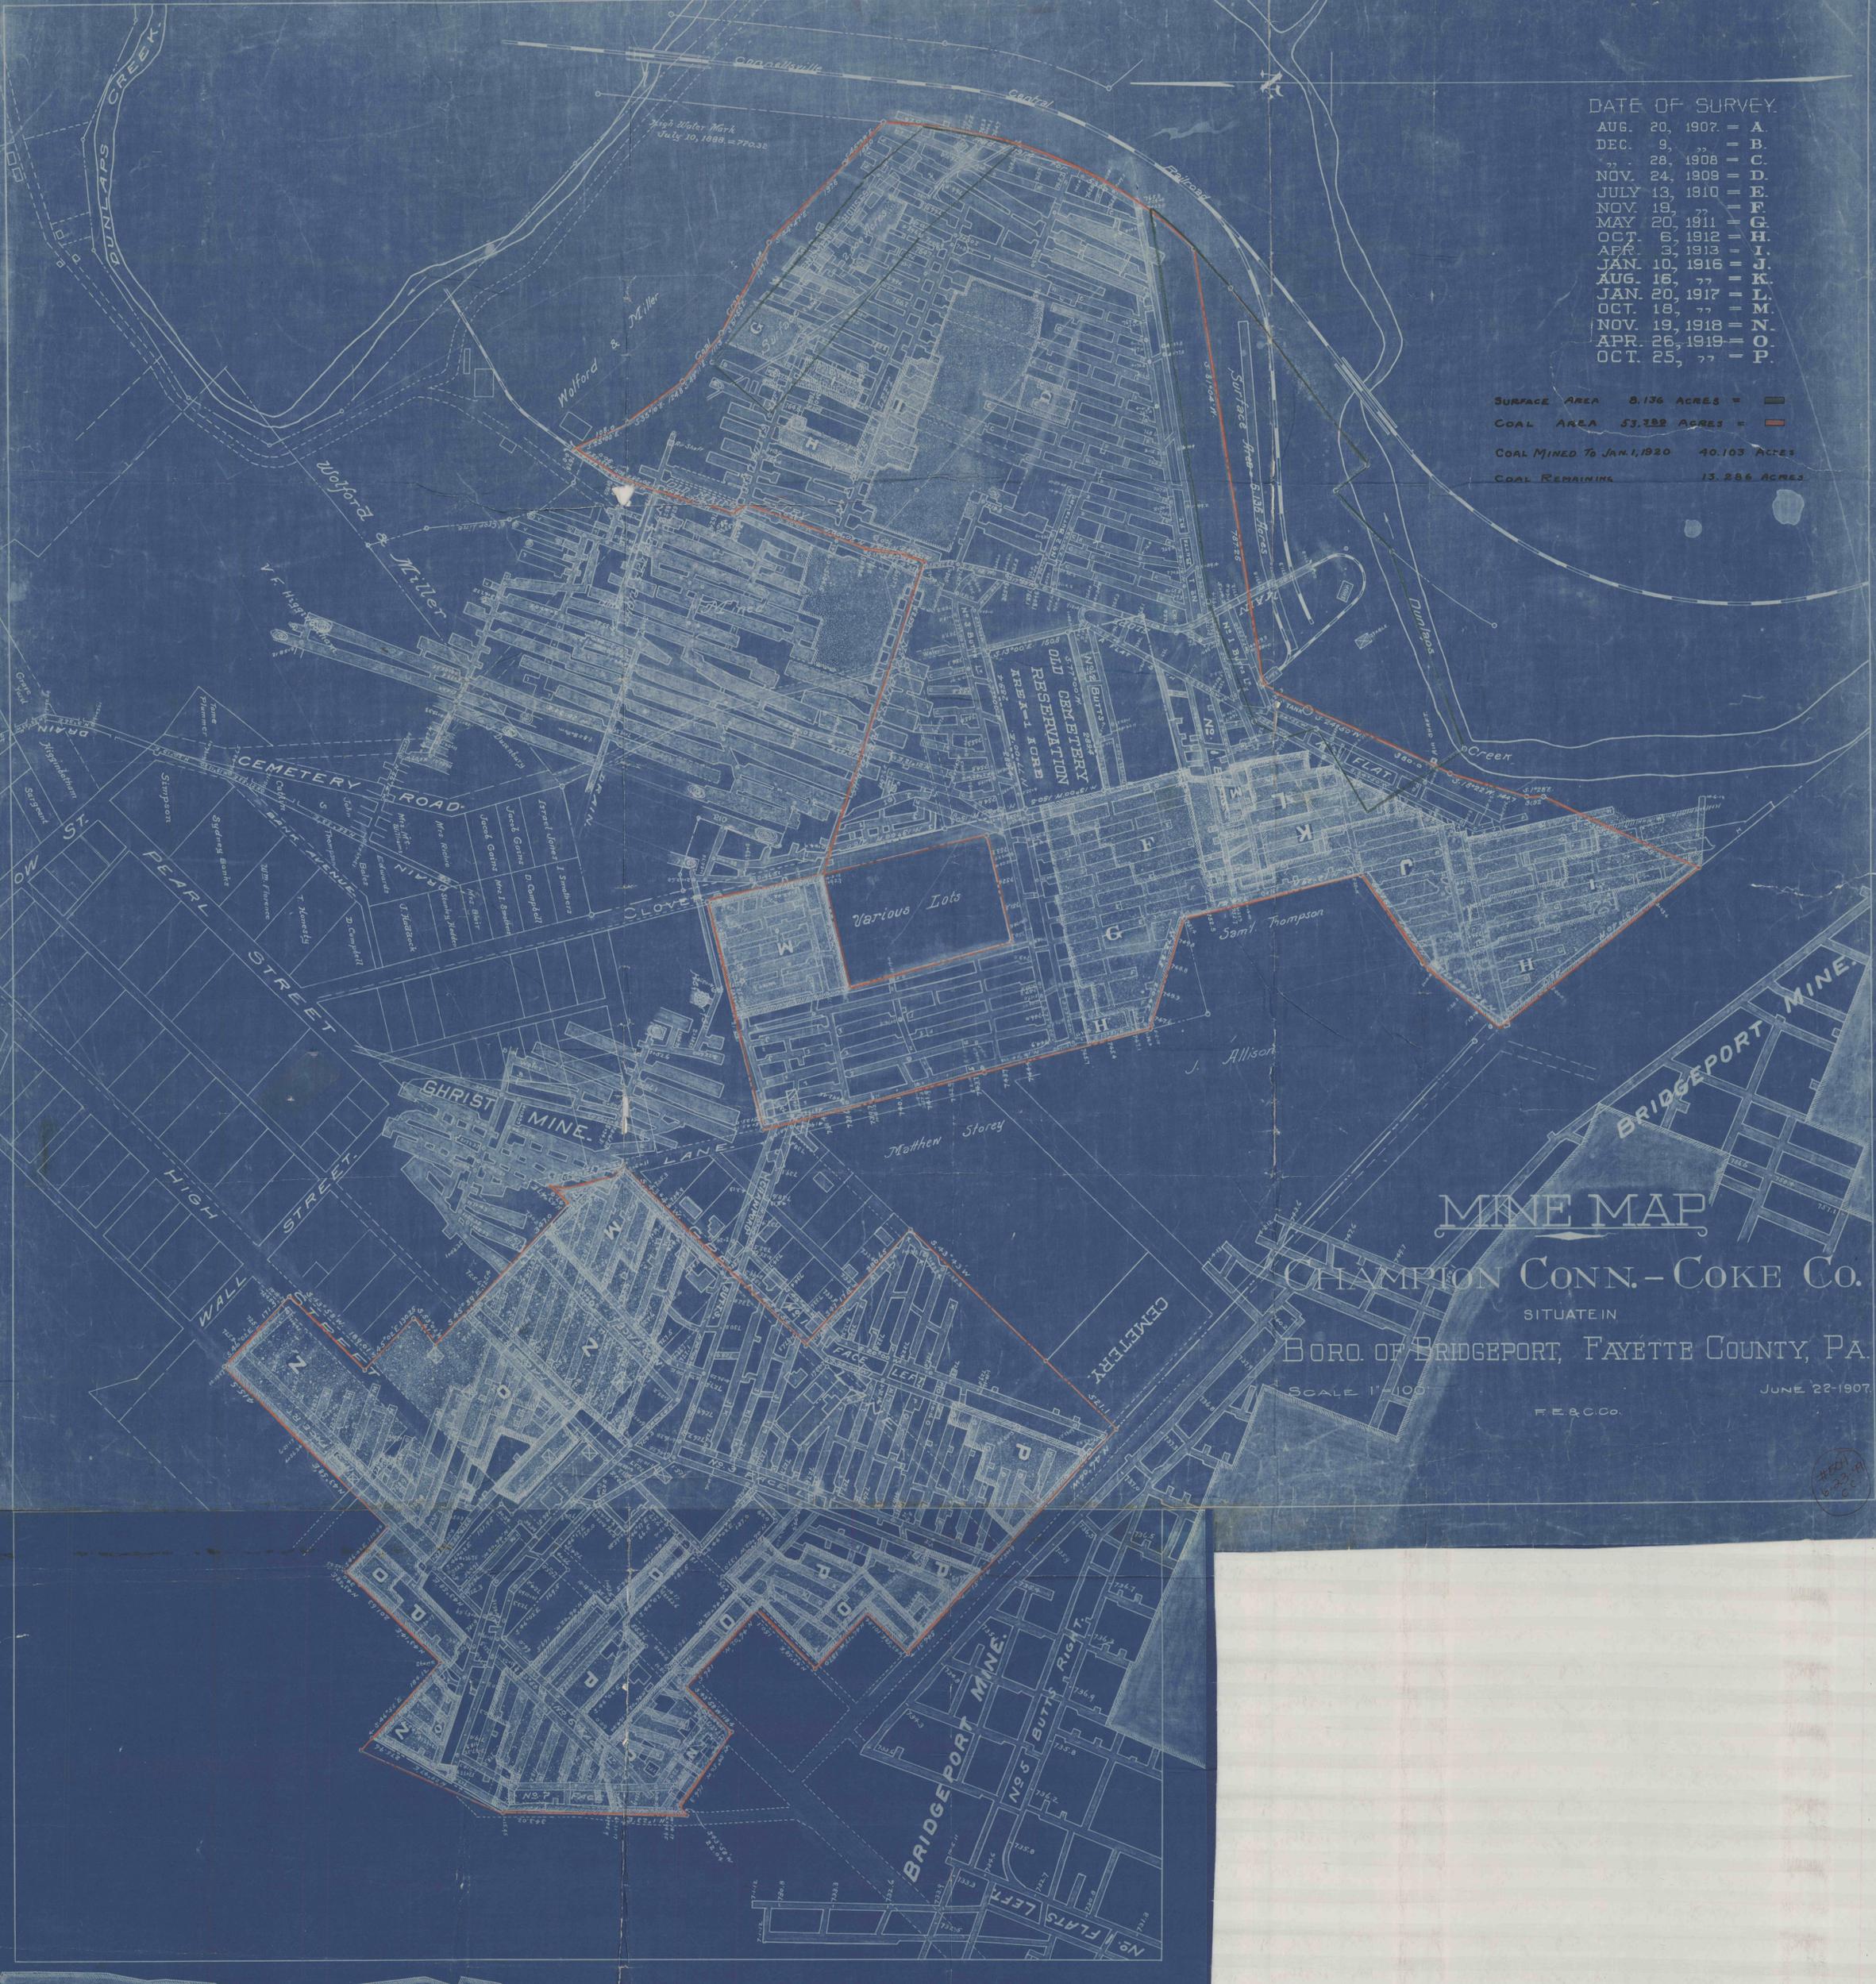

# MINE MAP

CHAMPION CONN.-COKE CO.

SITUATE IN  
BORO. OF BRIDGEPORT, FAYETTE COUNTY, PA.

SCALE 1"=100'

F.E.C.CO.

JUNE 22-1907.

#1001  
 6-22-1907  
 C.C.