


LACY COAL CO.
VIRGINIA MINE

DATE OF SURVEY.
MAY 7, 1917.

APRIL 2, 1920.
MAY 25, 1922.

COLUMNAR SECTION OF BORE HOLES

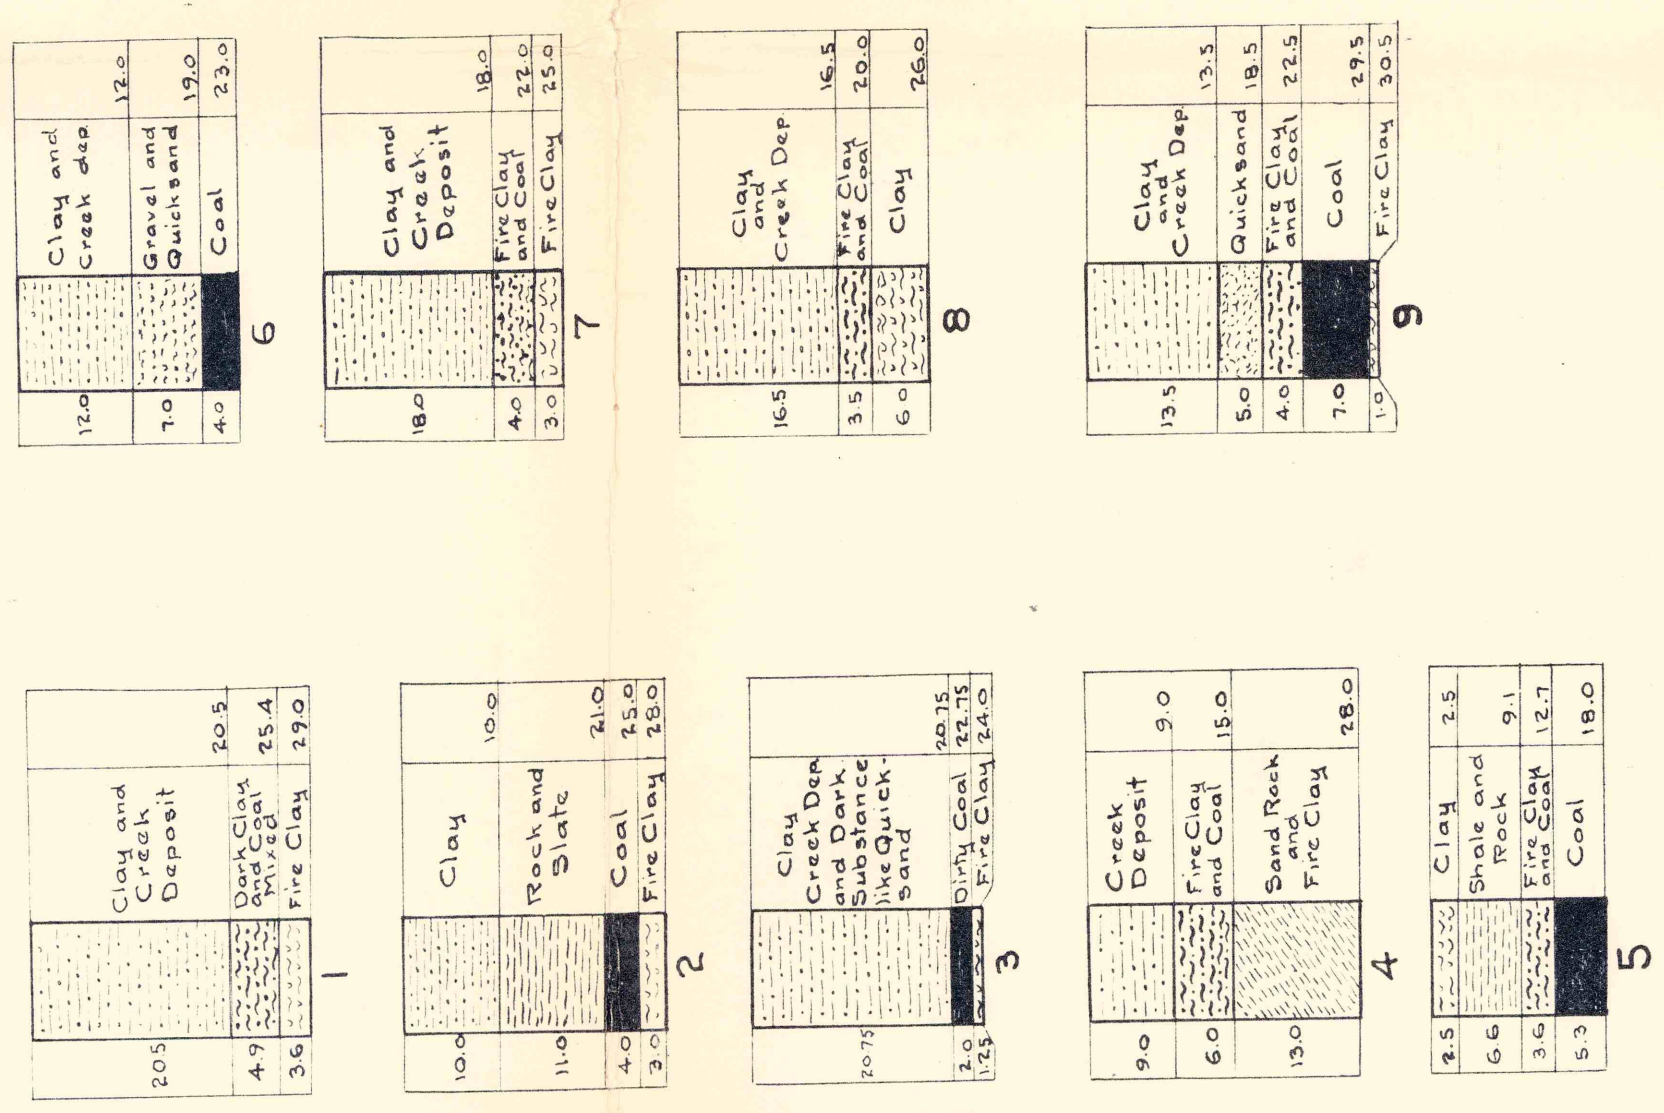

CHAMPION MINE

SITUATE IN
EAST BETHLEHEM TWP., WASHINGTON COUNTY, PA.

SCALE - 1 IN. = 100 FT. FEBRUARY 1914.

TRACED FROM BLUEPRINT BY JOHN M. RAYBURN.

EXTENSIONS

MAY 1, 1927
DEC 1, 1927
MAY 22, 1928
MAY 16, 1930
NOV 21, 1931
DEC 5, 1931
JULY 17, 1932

W-2
BARREN AREA = 15,372 ACRES.

7A
CHAMPION

ENGINEERING DEPT.