

(NOTE) STOPPIES ACCESS TO ENTRIES VISIT FROM PIT MOUTH ON NE BENTS ON THIS SIDE OF PAGES TO PIT MOUTH

Y. & B. COAL CO. PROPERTY


ROGERS HRS FARM.

LOADED OUT BUT NO FIRE

APPROXIMATE FIRE AREA ORIGINALLY

THIS SECTION FIRE LOADED OUT

PIT MOUTH

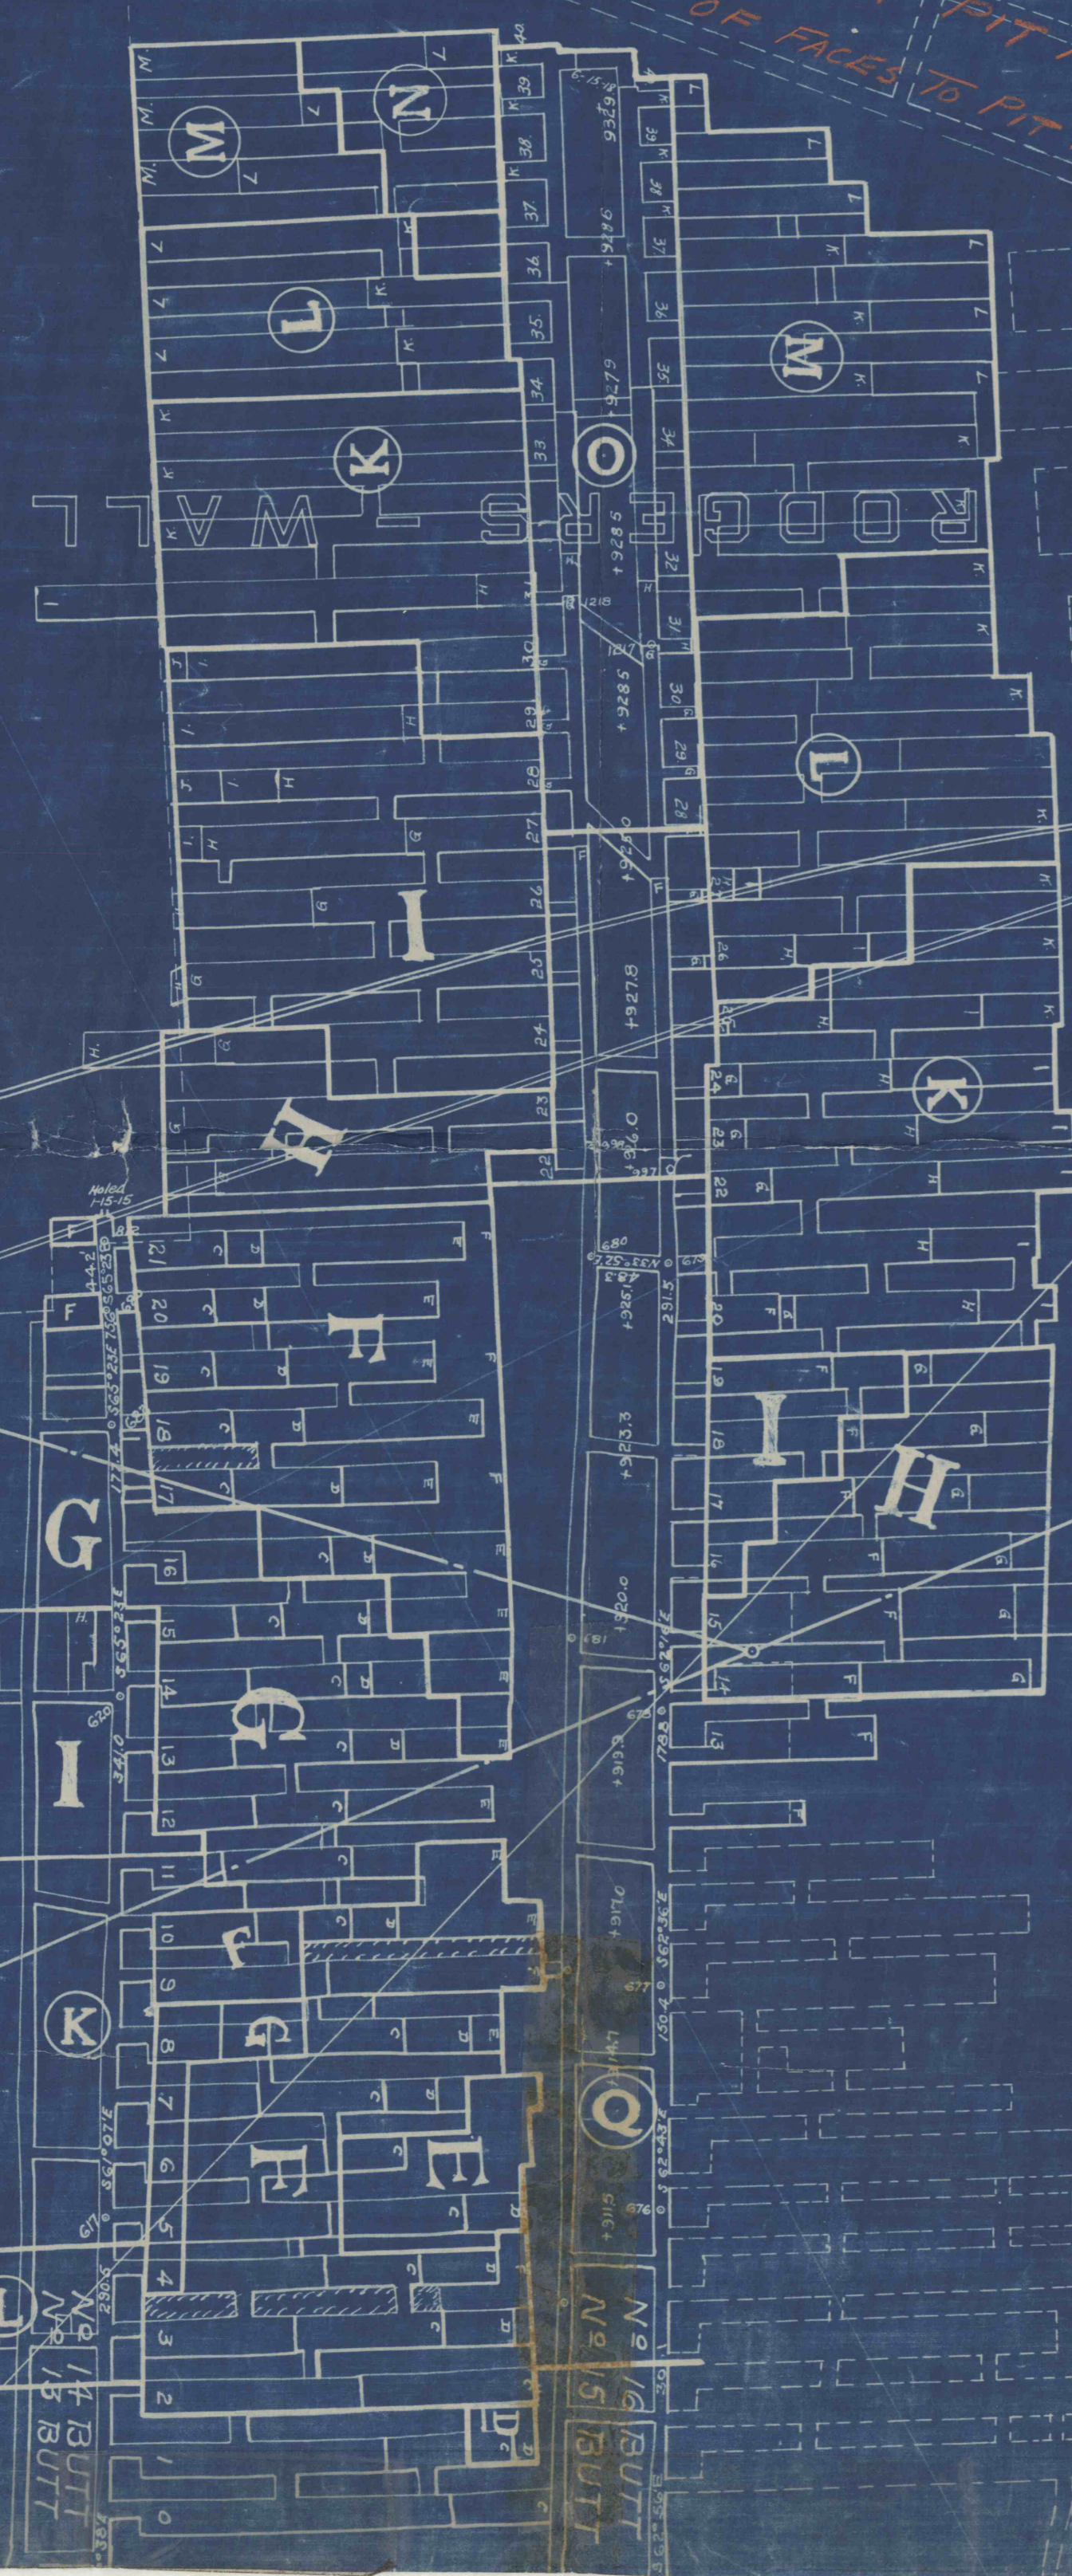

CHARLETON MINE
 YORKSHIRE & OHIO COAL CO.
 (FIRE AREA)
 SCALE 1"=100'
 (PERIL MINE) 2-10-23
 + LEGEND +
 ■ STOPPIES, BRICK & CEMENT

200
 100
 50