


CHELLINI MINE

LEGEND		
I	JULY 28	1953
J	JAN 20	1954
K	SEPT 15	1954
L	MAR 21	1955
M	OCT 27	1955

BELCH MINE

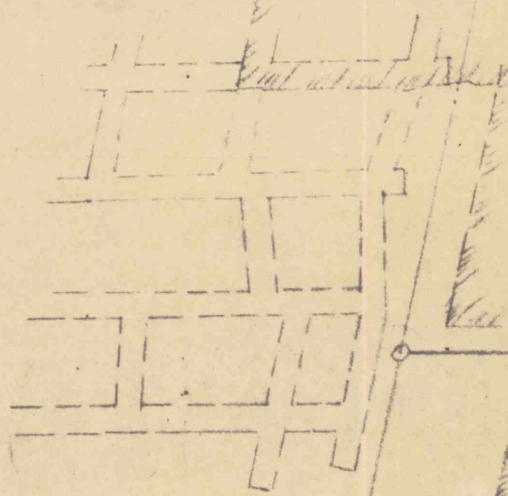

I, the undersigned, hereby certify that this map is correct and shows all the information, to the best of my knowledge and belief, required by the mining laws of this State, and covers the period ending Explosives

E.R. de Forest R.P.E.

Acknowledged before me a Notary Public this 10 day of Nov 1955
 My Commission Expires Jan. 21, 1959
 404 Union Trust Bldg. Uniontown, Pa.

John A. Henry

MAP OF
 CHELLINI MINE No 4
 CHELLINI COAL CO.
 SPRINGHILL TOWNSHIP - FAYETTE COUNTY - PA.
 SCALE 1"=100 MAY 25-1950
 ERDE FORESTR.P.E.

#512
 b-23-99
 C.C.