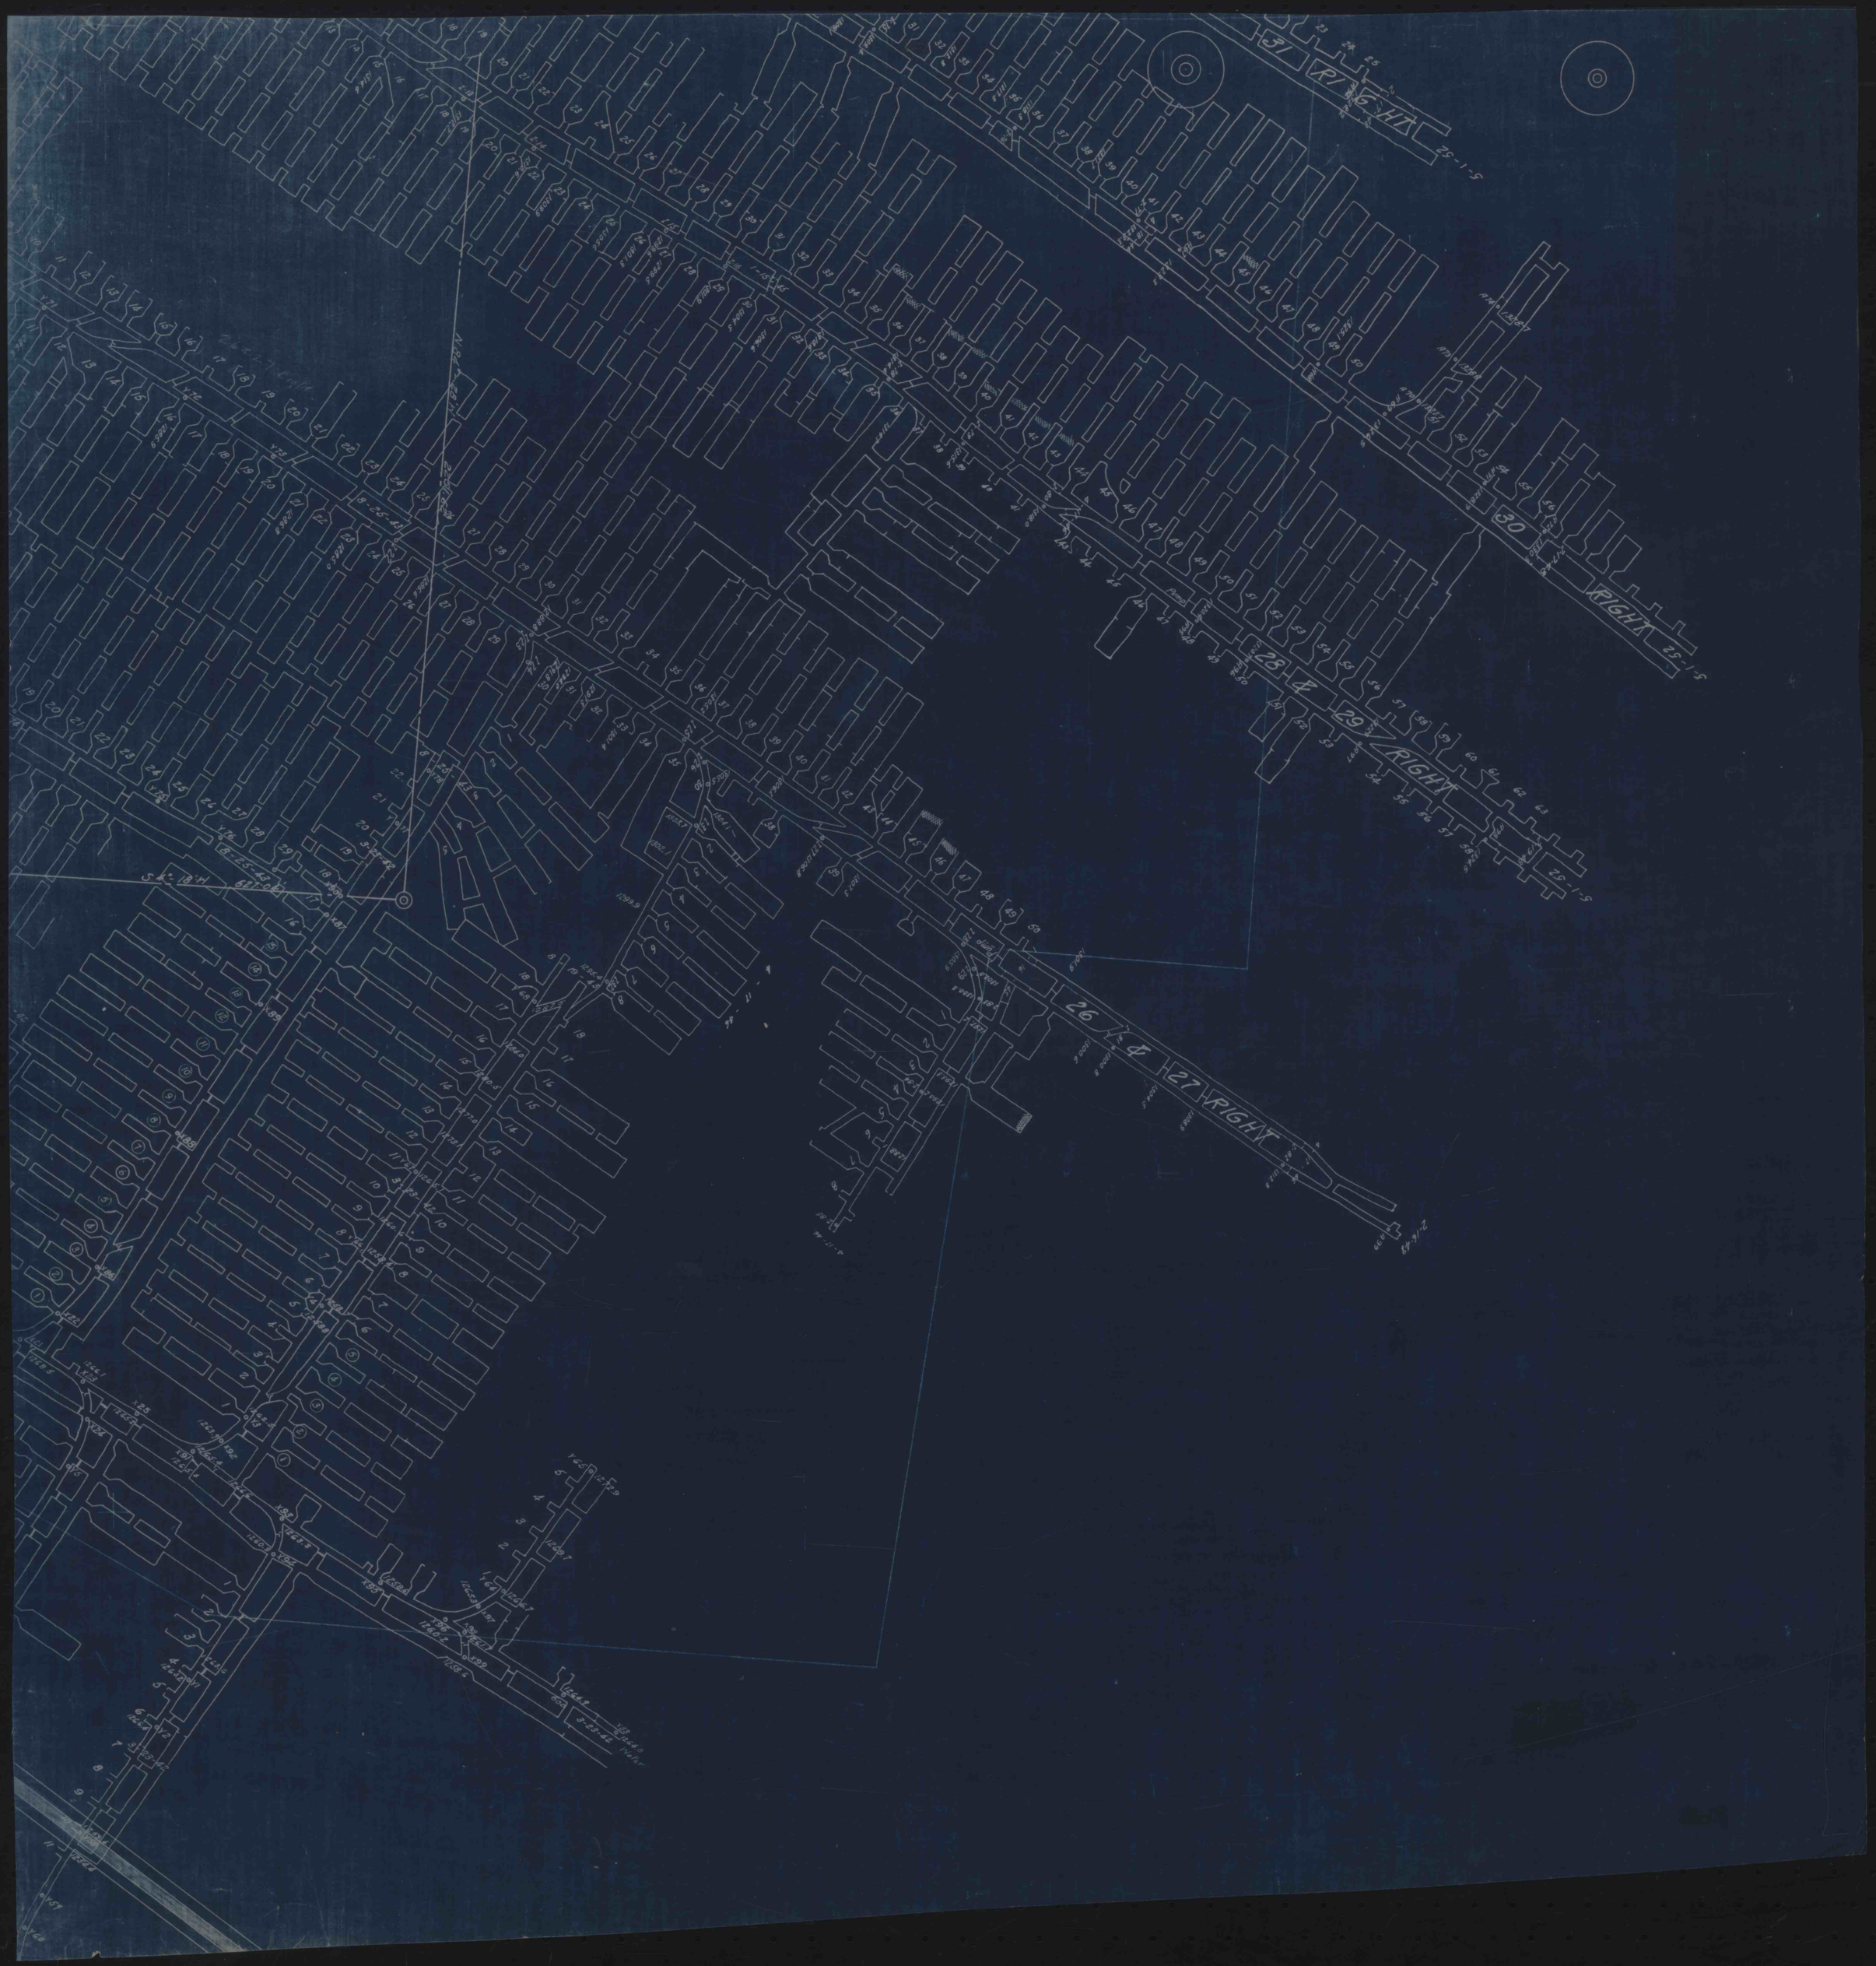
37
RIGHT
25-1-5
30
RIGHT
25-1-5
28
29
RIGHT
25-1-5
26
27
RIGHT