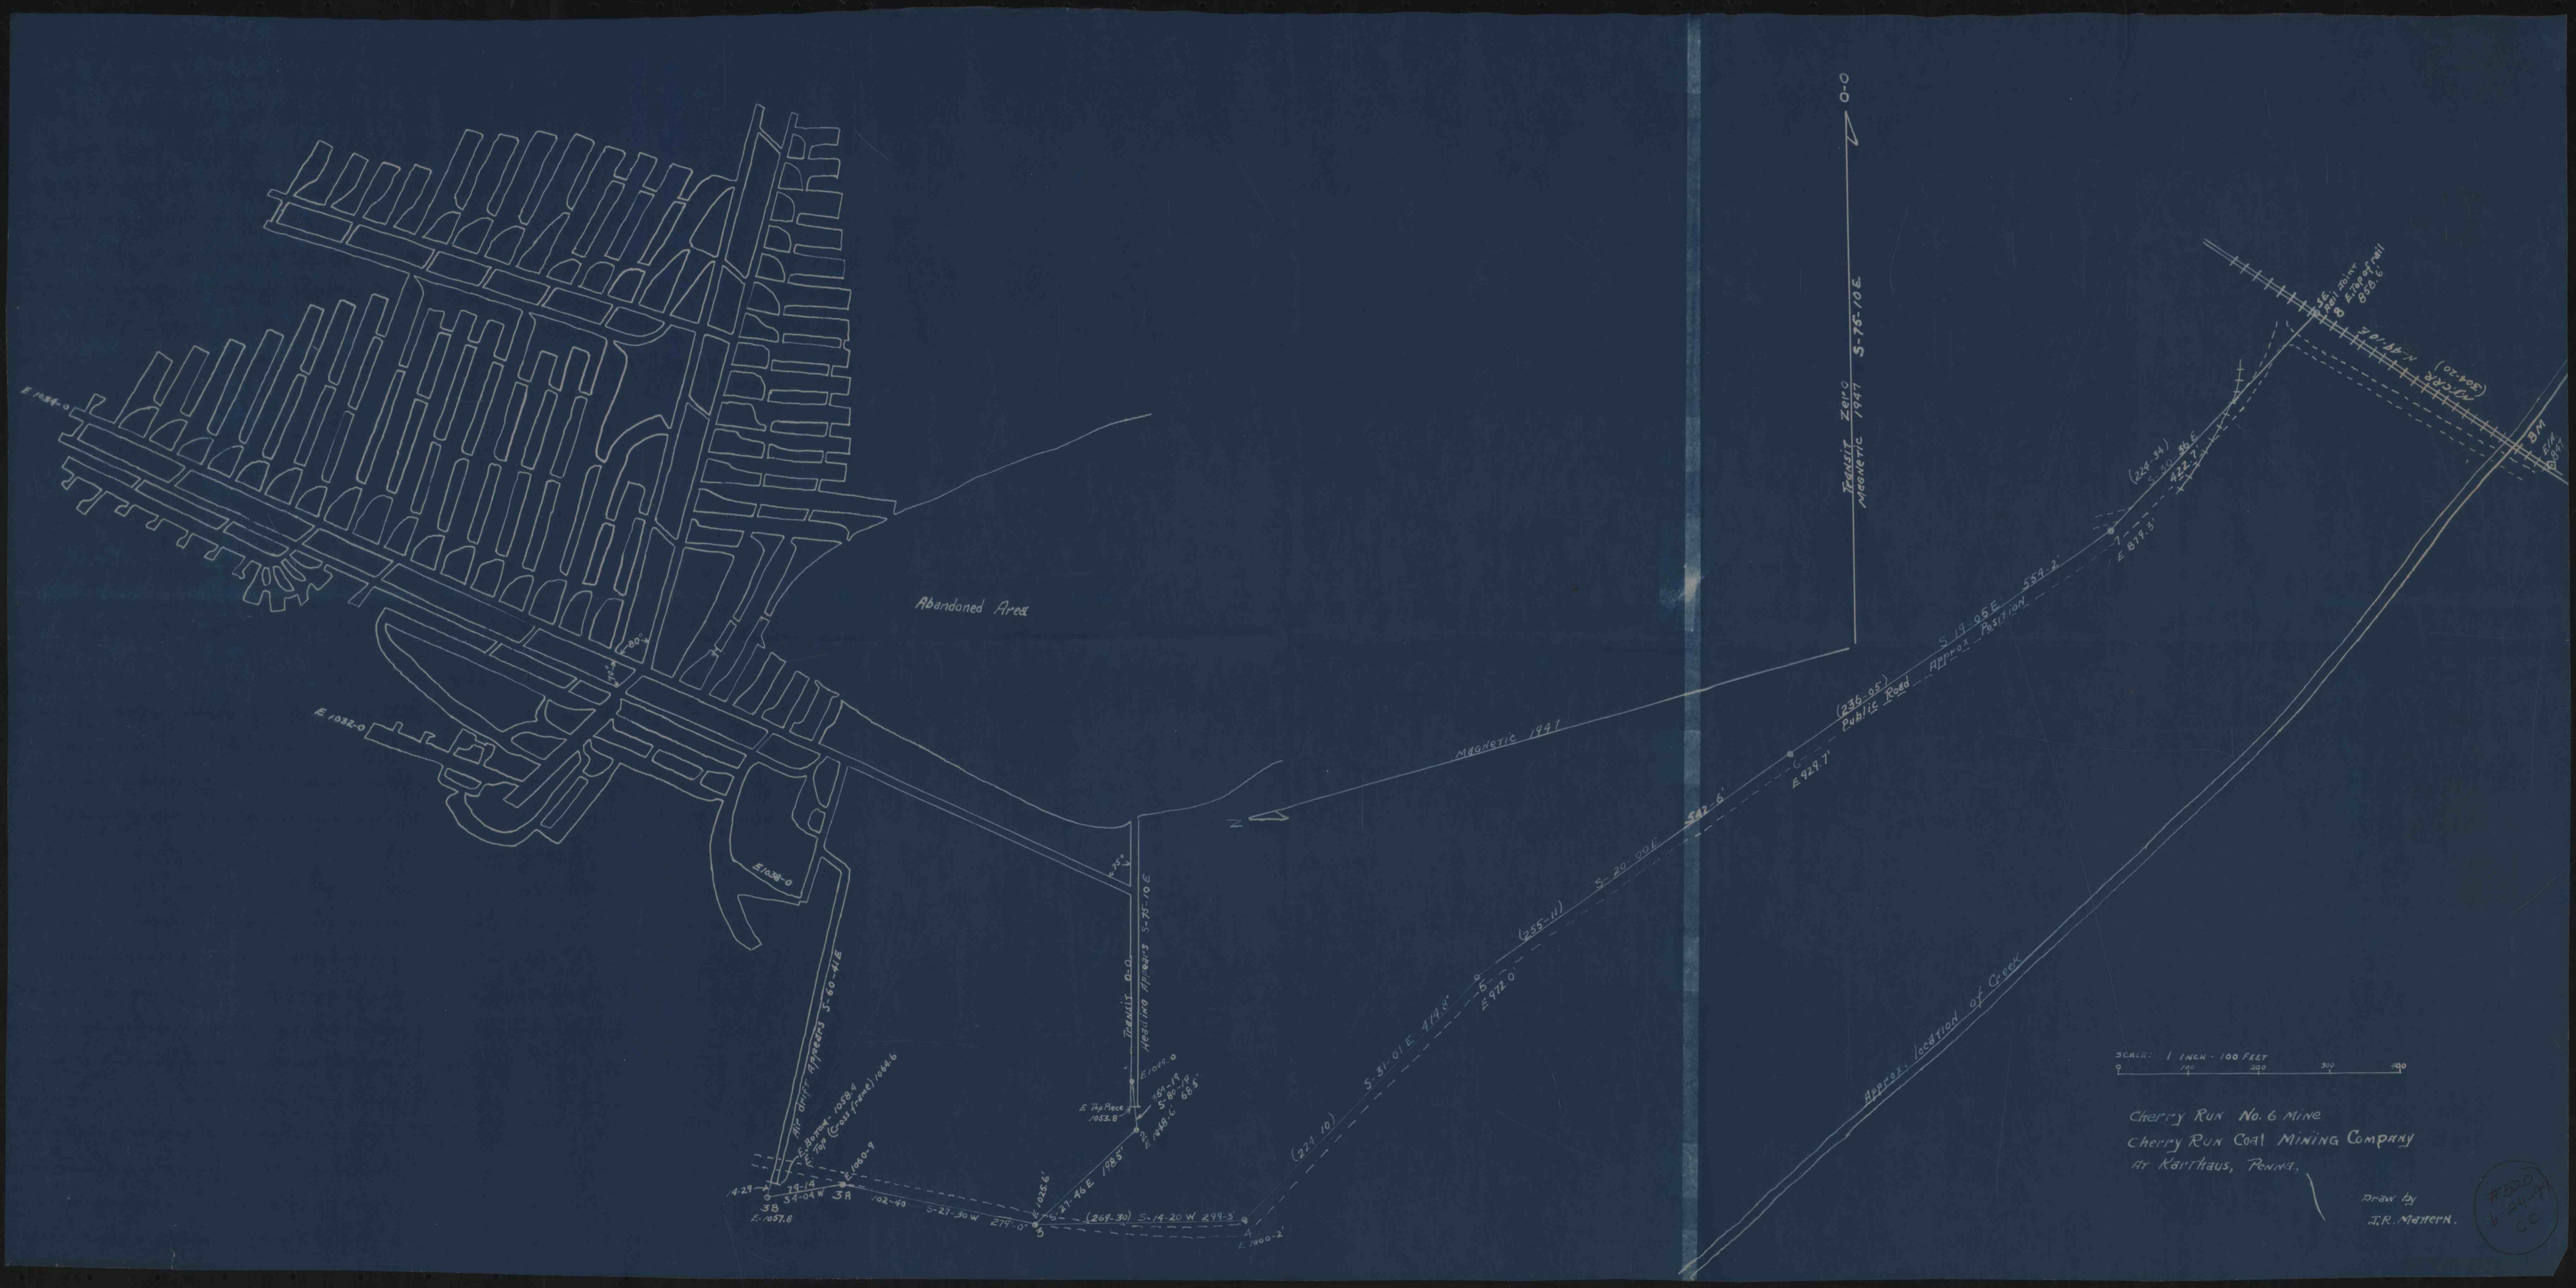

Cherry Run No. 6 Mine
Cherry Run Coal Mining Company
at Karthaus, Penna.

Draw by
J.R. Mattern.