


ANDREW SNOW BAYARD TRACT

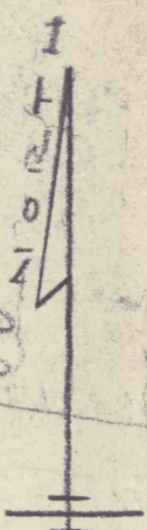

N 88° W

N 17° 30' E

N 28° 30' E



Final operation by Jacob Friedmann Cherry Run #8

MIDLAND MINING CO.
LEHIGH VALLEY COAL CO.

COAL COMPANY OLD WORKINGS

Permanent Abandonment

MAP of
CLARENCE COAL MINING CO.
CHERRY RUN NO. 8 MINE
AS OF FEBRUARY 1, 1956
SURV. & MAP - FRANCIS A. E. KOSKI
SCALE 1" = 100 FT. 2-20-1956

BITUMINOUS COAL - LOWER "A" SEAM
FINAL OPERATION - N.E. of OPENINGS BY:
JACOB FRIEDMAN - BELLEFONTE, PA.

#523
6-24-97
C.C.