


MAP  
SHOWING  
D SEAM WORKINGS  
OF  
CHILCOTE COAL CO. MINE #1  
READE TWP., CAMBRIA CO., PA.  
SCALE 1"=100' 8-11-56  
J.L. BANFIELD REG. ENG.

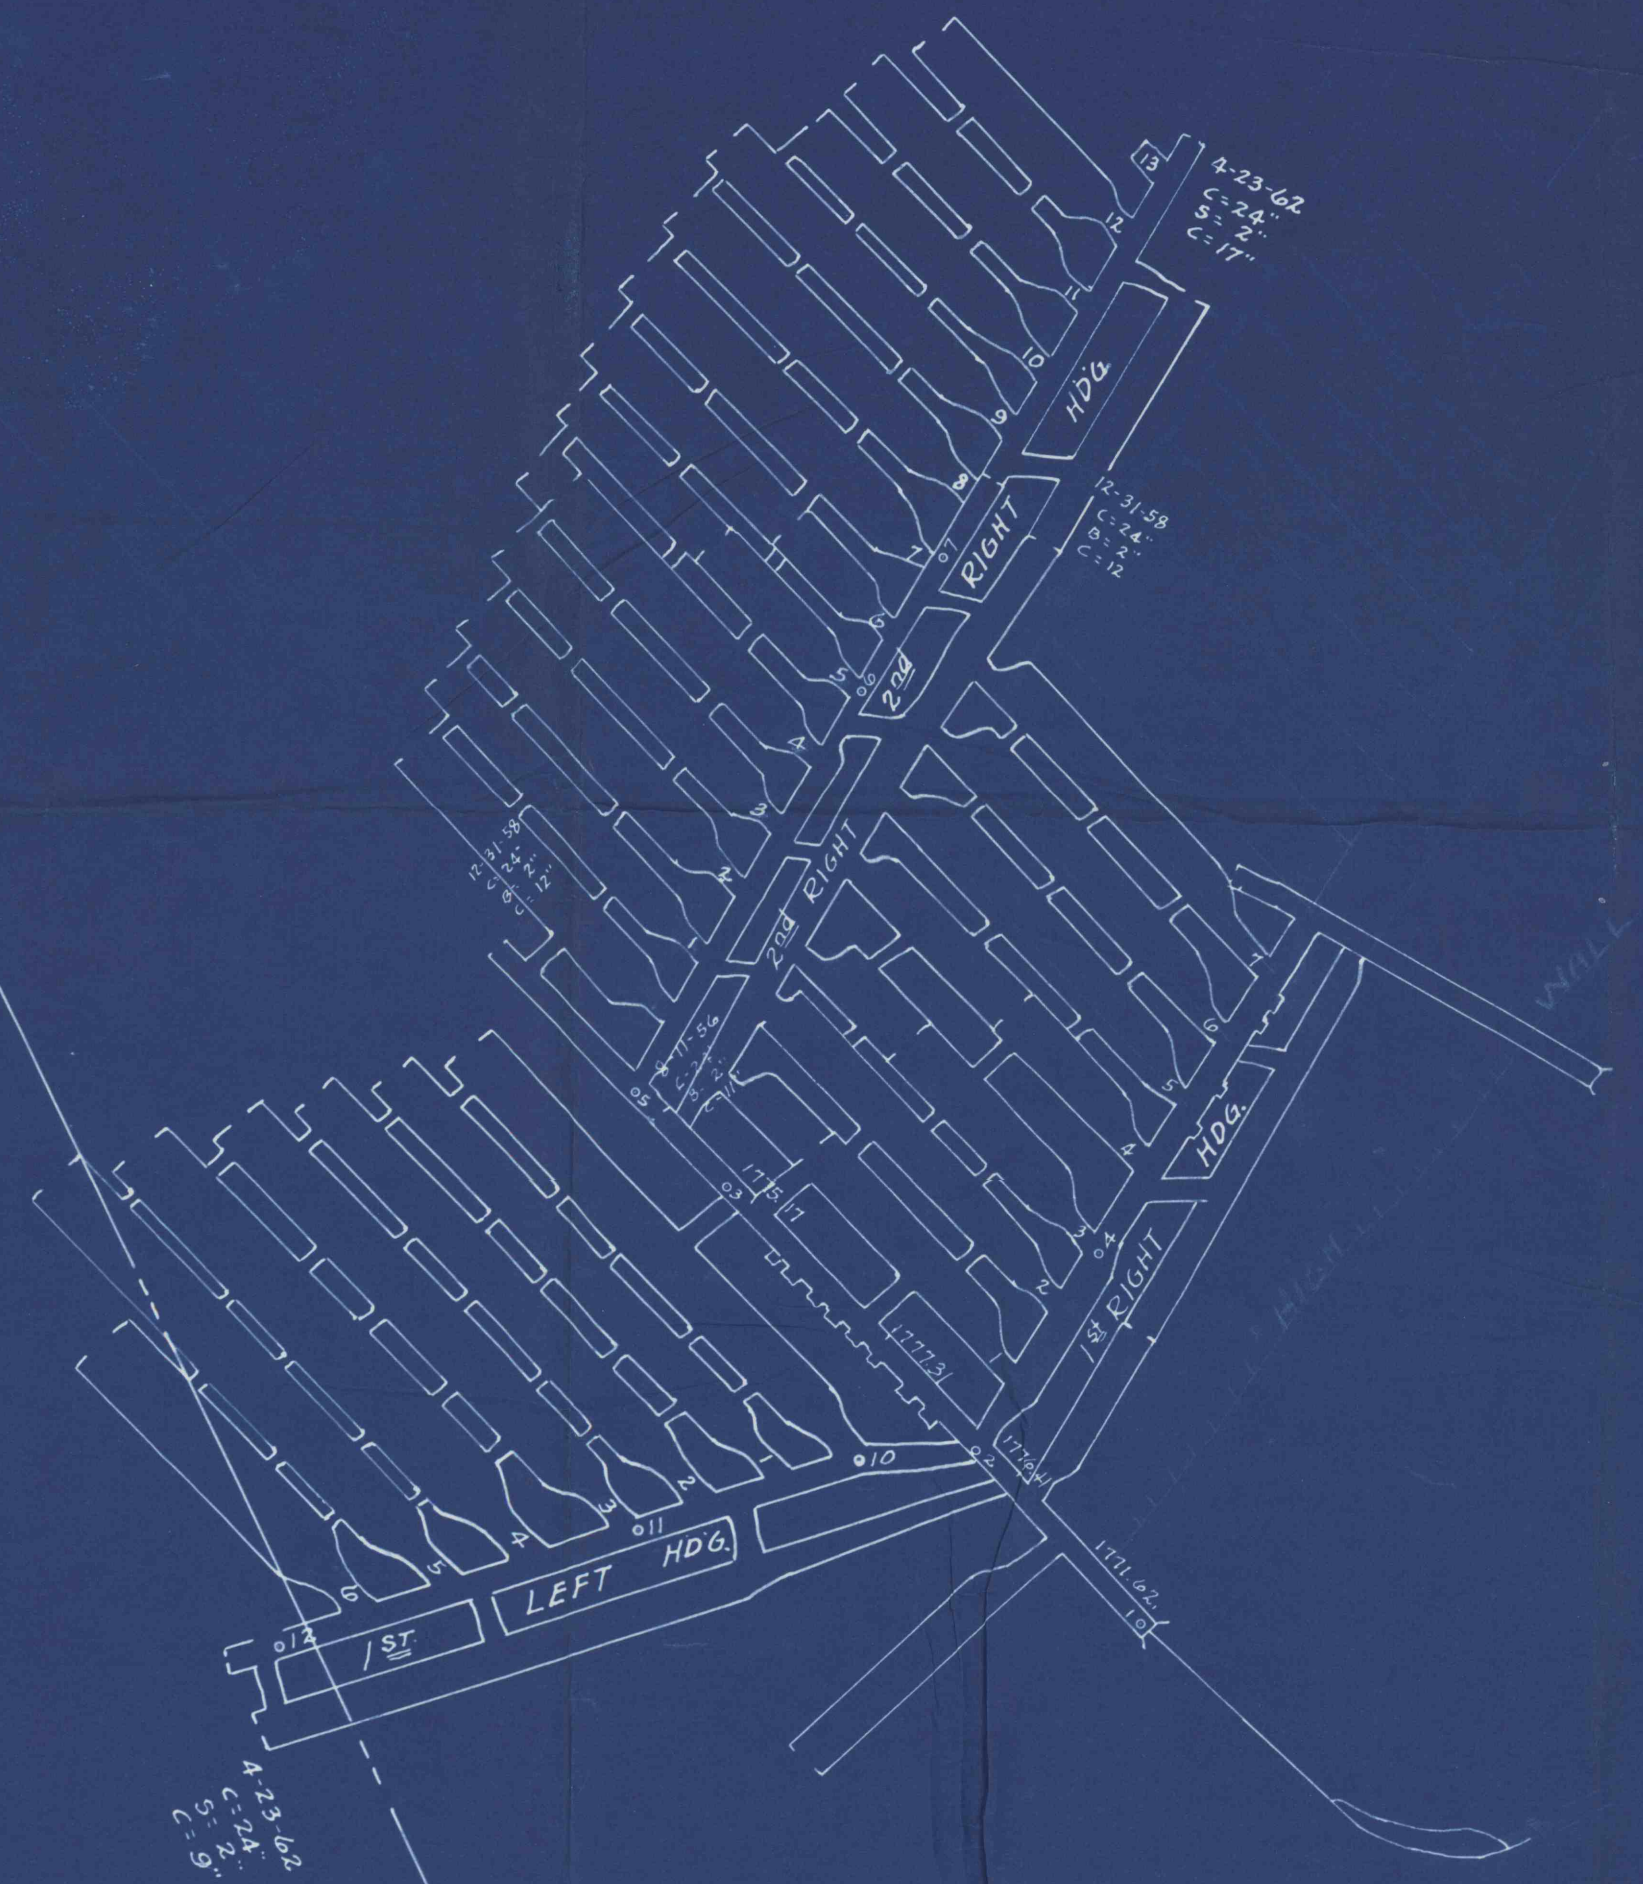

#533  
6-24-99  
CC