


MARTHA E. SNYDER ESTATE
(OLD OGLE NO. 1 WORKINGS. PILLARS DRAWN)

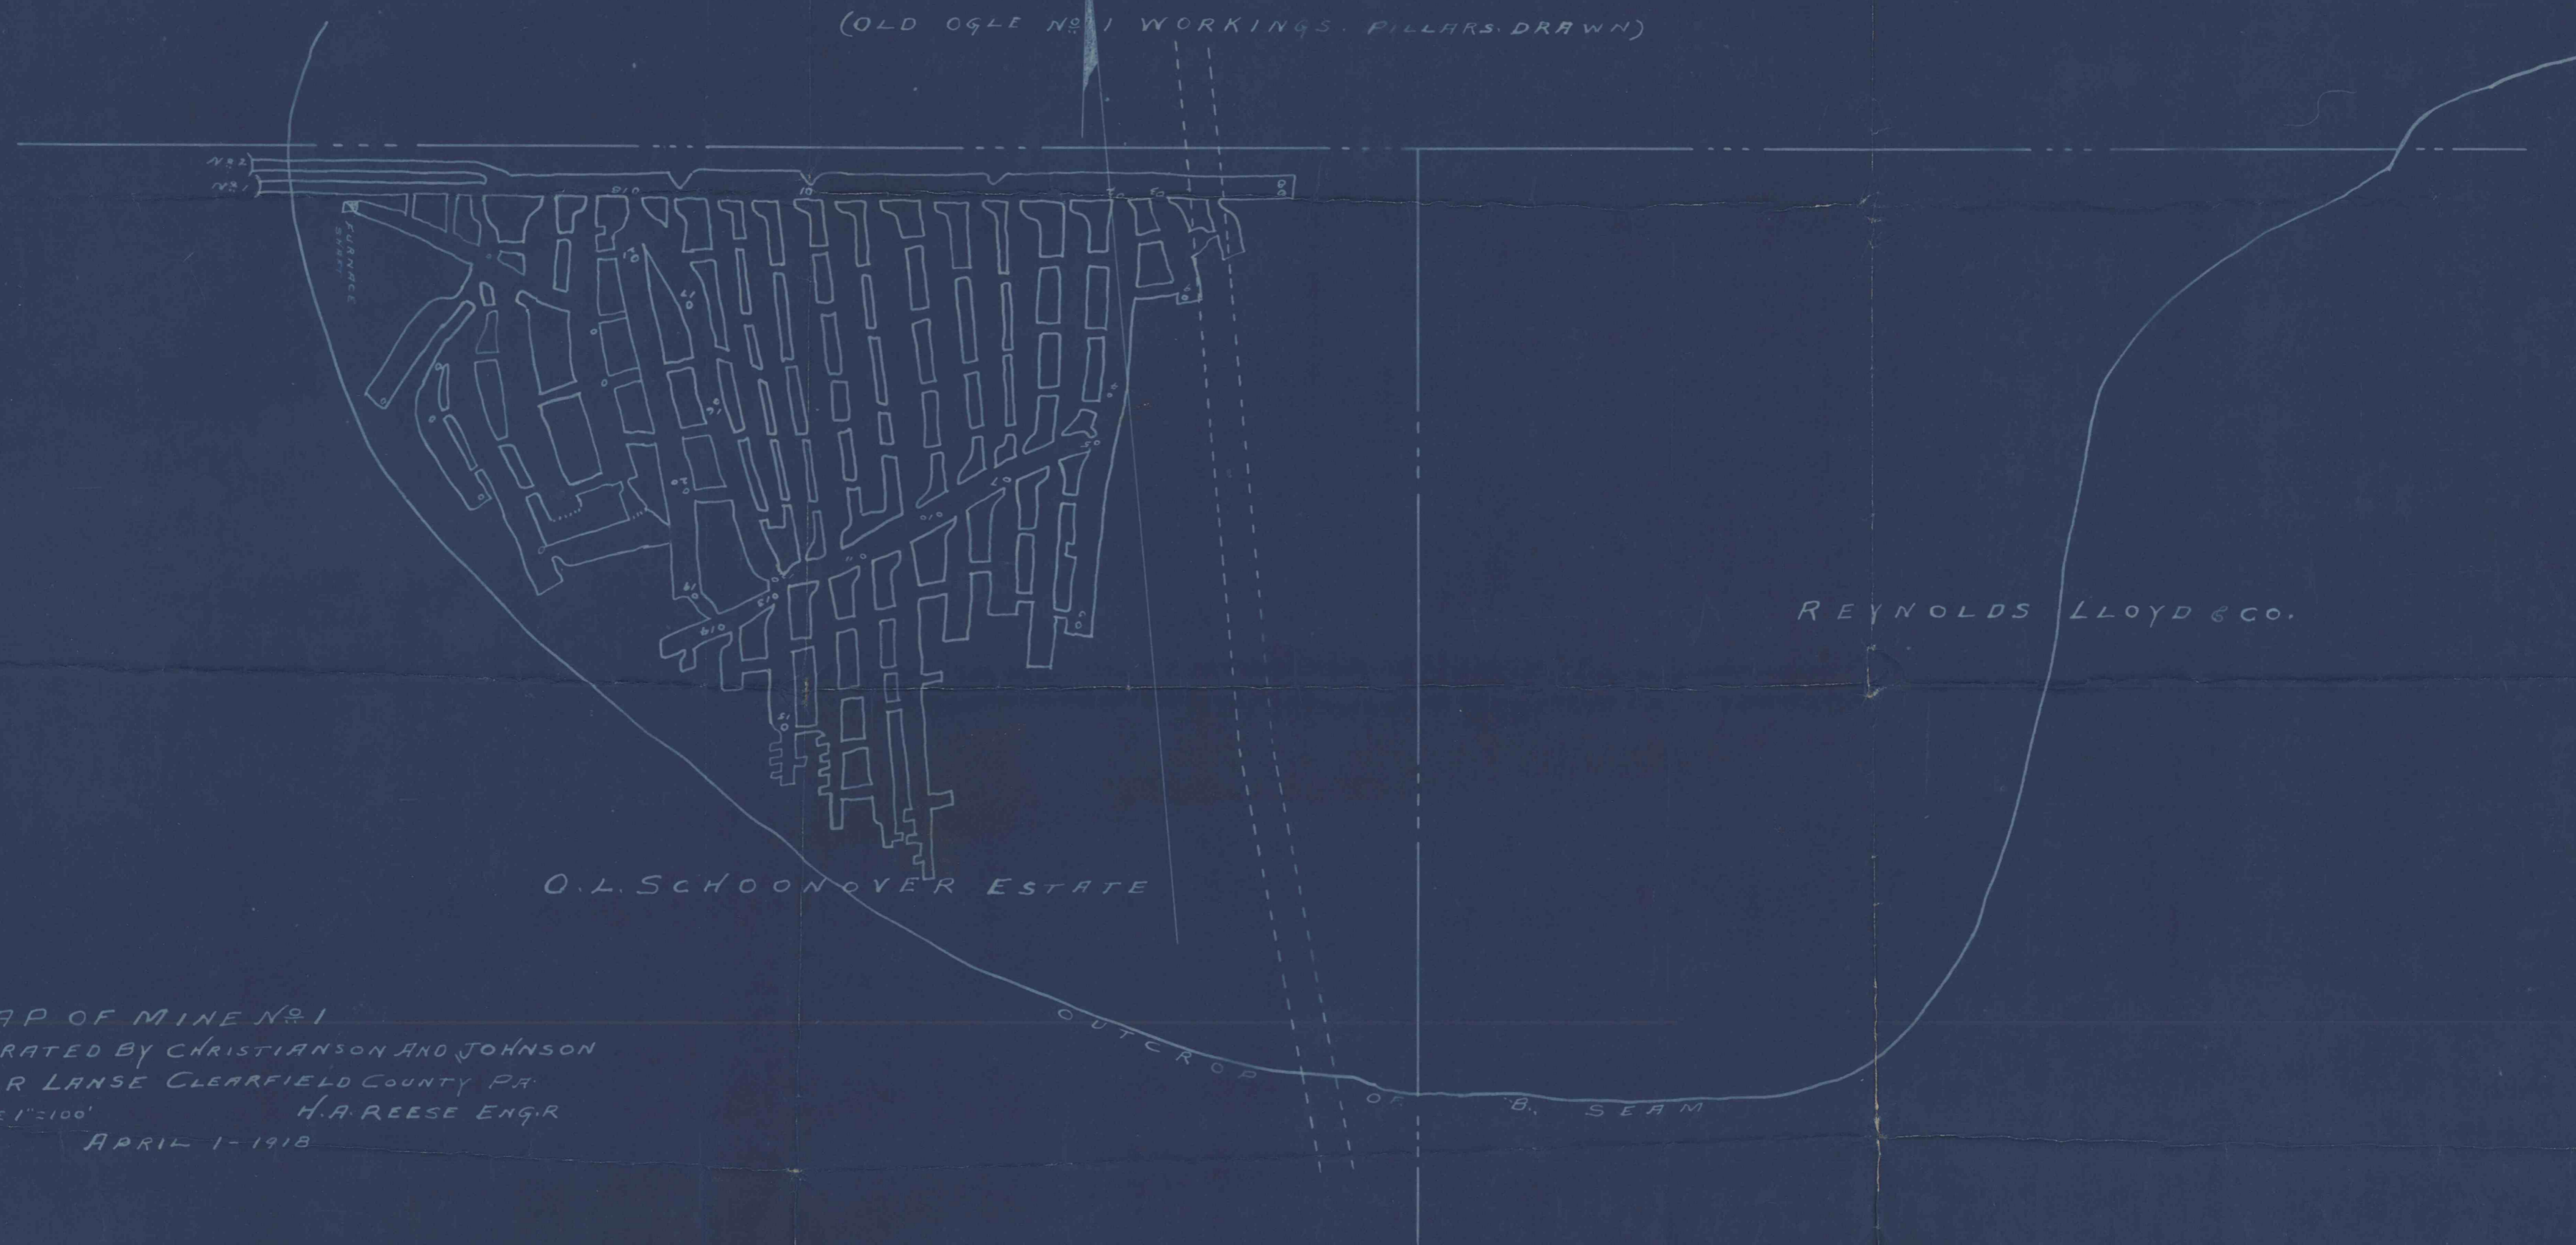

MAP OF MINE NO. 1
OPERATED BY CHRISTIANSON AND JOHNSON
NEAR LANSE CLEARFIELD COUNTY PA.
SCALE 1"=100' H.A. REESE ENGR.
APRIL 1-1918

MAR 24 1918
H.A. REESE
ENGR.