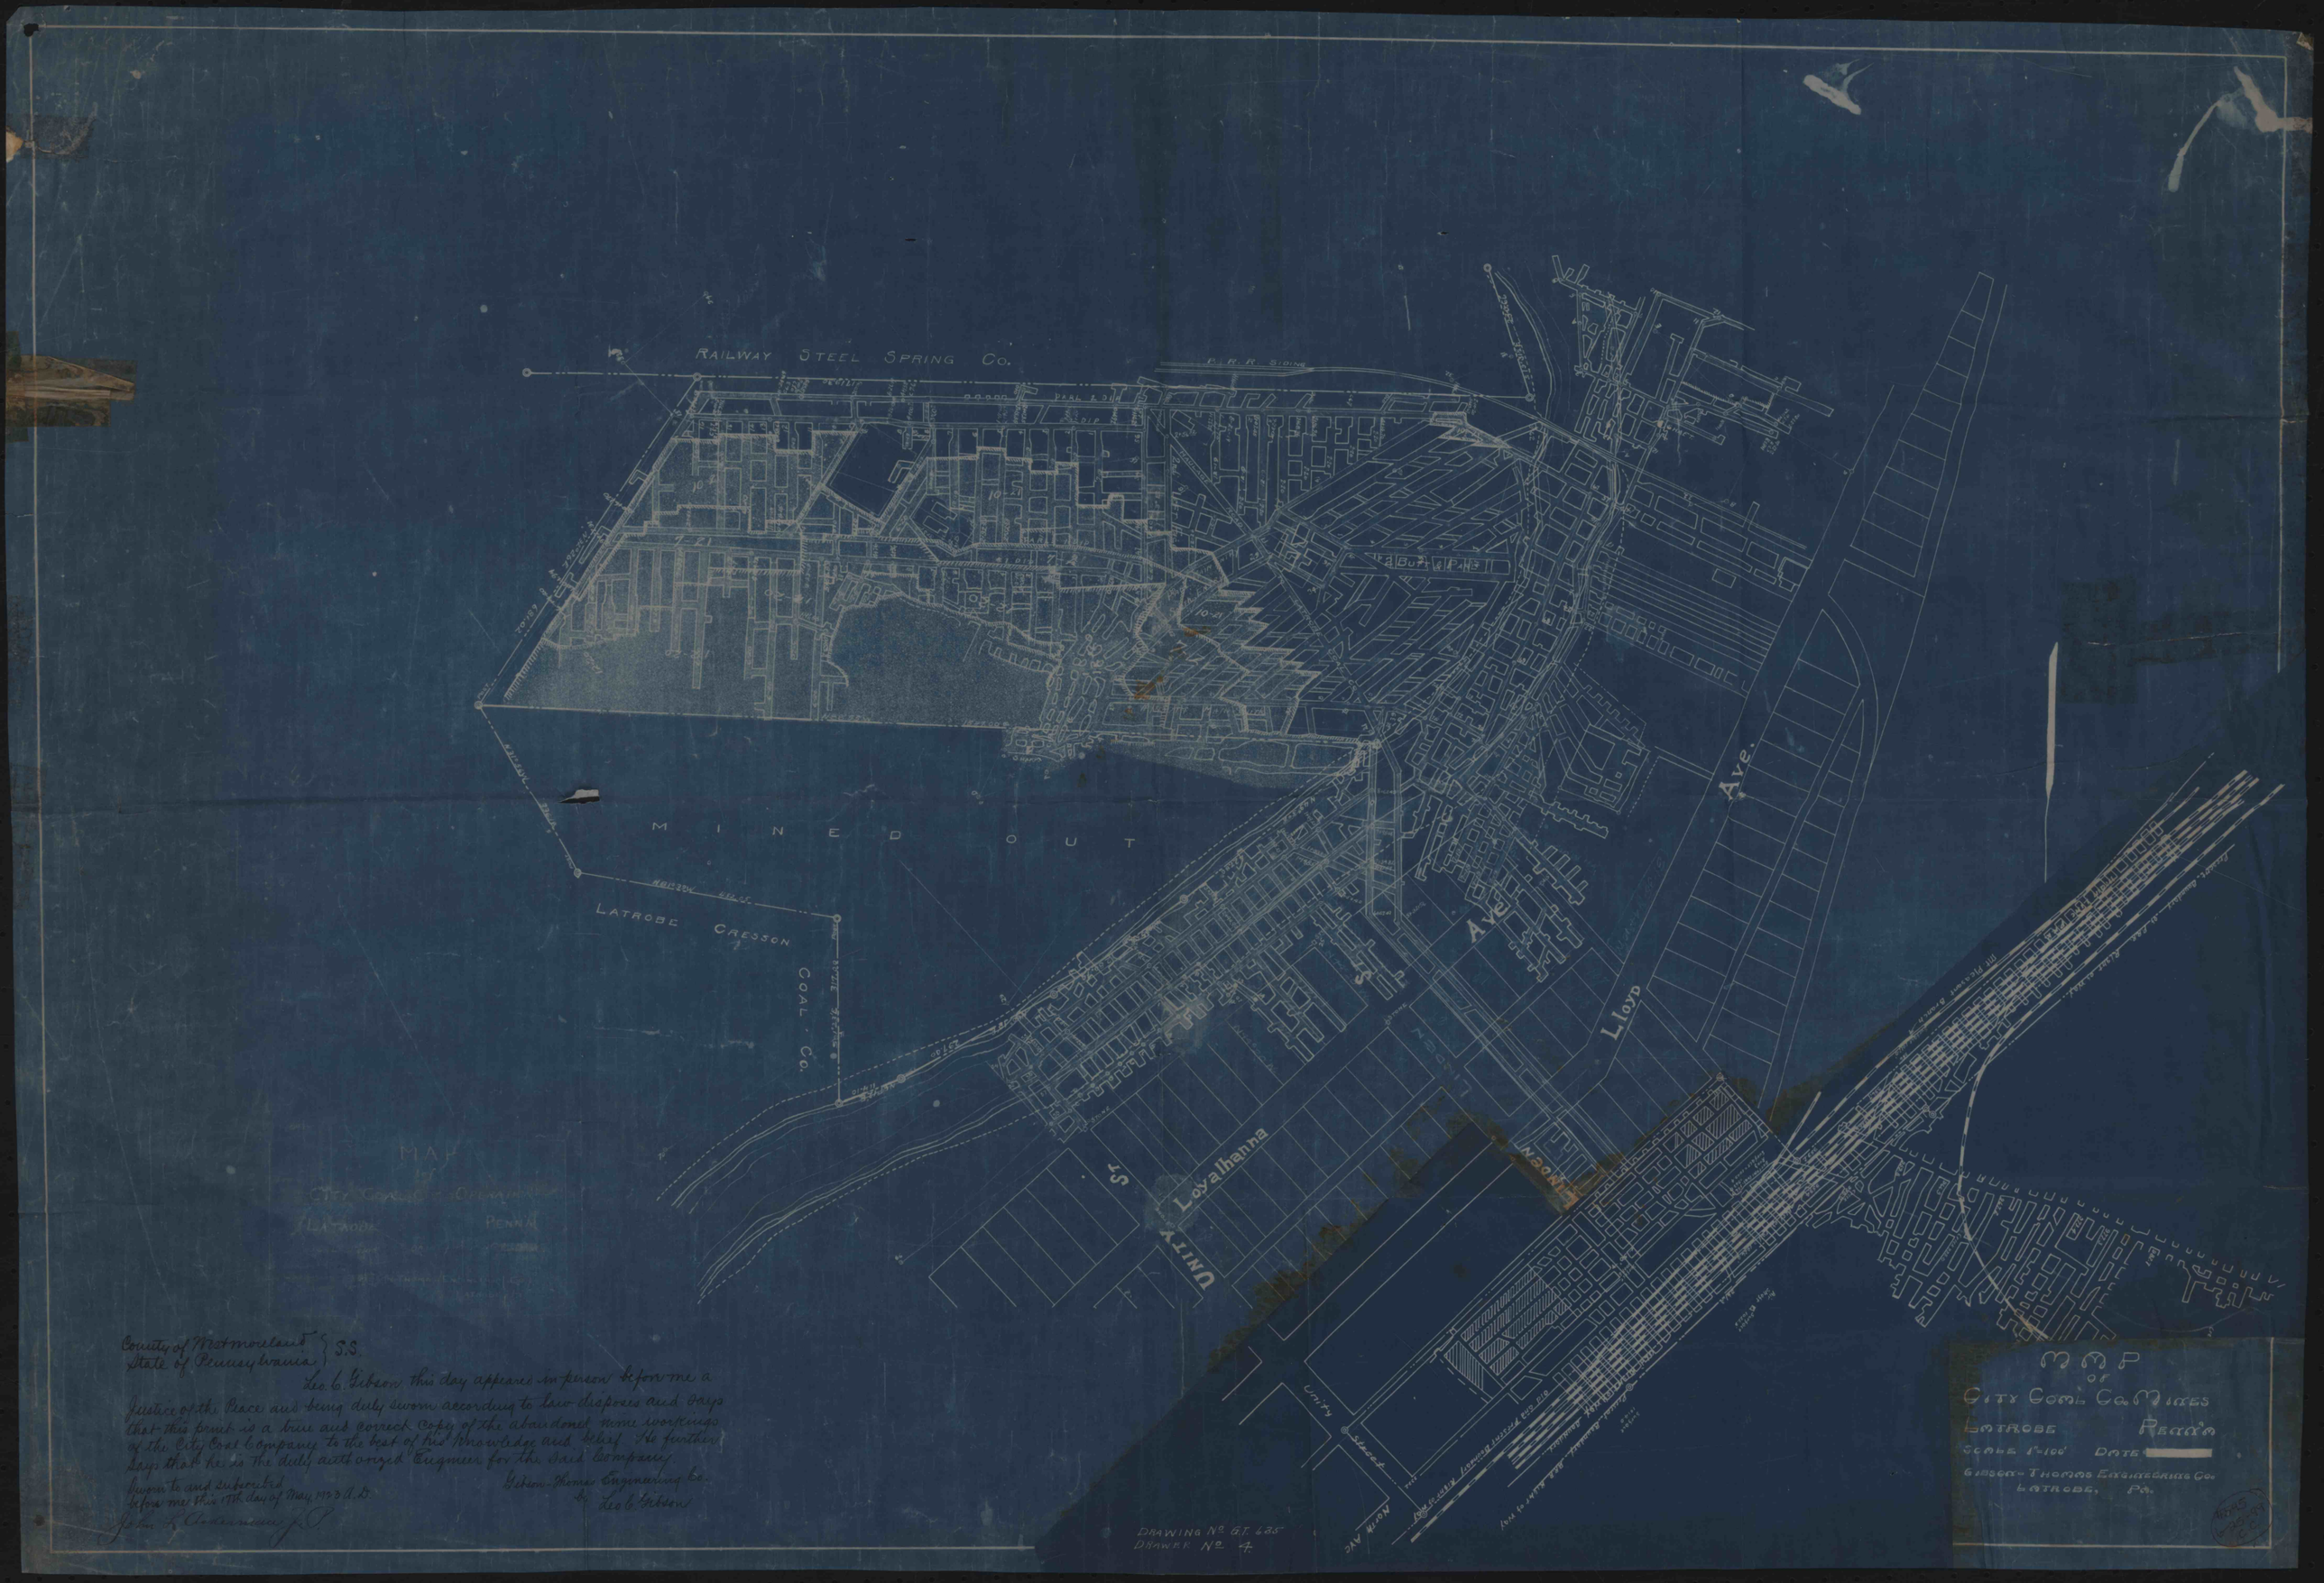
RAILWAY STEEL SPRING CO.
P. R. R. SIDING
MINED OUT
LATROBE CRESSON COAL CO.
Ave.
Lloyd
Loyalhanna
UNITY ST
Unity Street
North Ave
MAP OF CITY COAL CO. MINES
LATROBE PENN'A
SCALE 1"=100' DATE
GIBSON-THOMAS ENGINEERING CO.
LATROBE, PA.
County of Westmoreland } S.S.
State of Pennsylvania }
Leo C. Gibson this day appeared in person before me a Justice of the Peace and being duly sworn according to law disposes and says that this print is a true and correct copy of the abandoned mine workings of the City Coal Company to the best of his knowledge and belief. He further says that he is the duly authorized Engineer for the said Company.
Sworn to and subscribed before me this 17th day of May, 1923 A.D.
John L. Ackerman J.P.
Gibson-Thomas Engineering Co.
by Leo C. Gibson
DRAWING No. G.T. 635
DRAWER No. 4