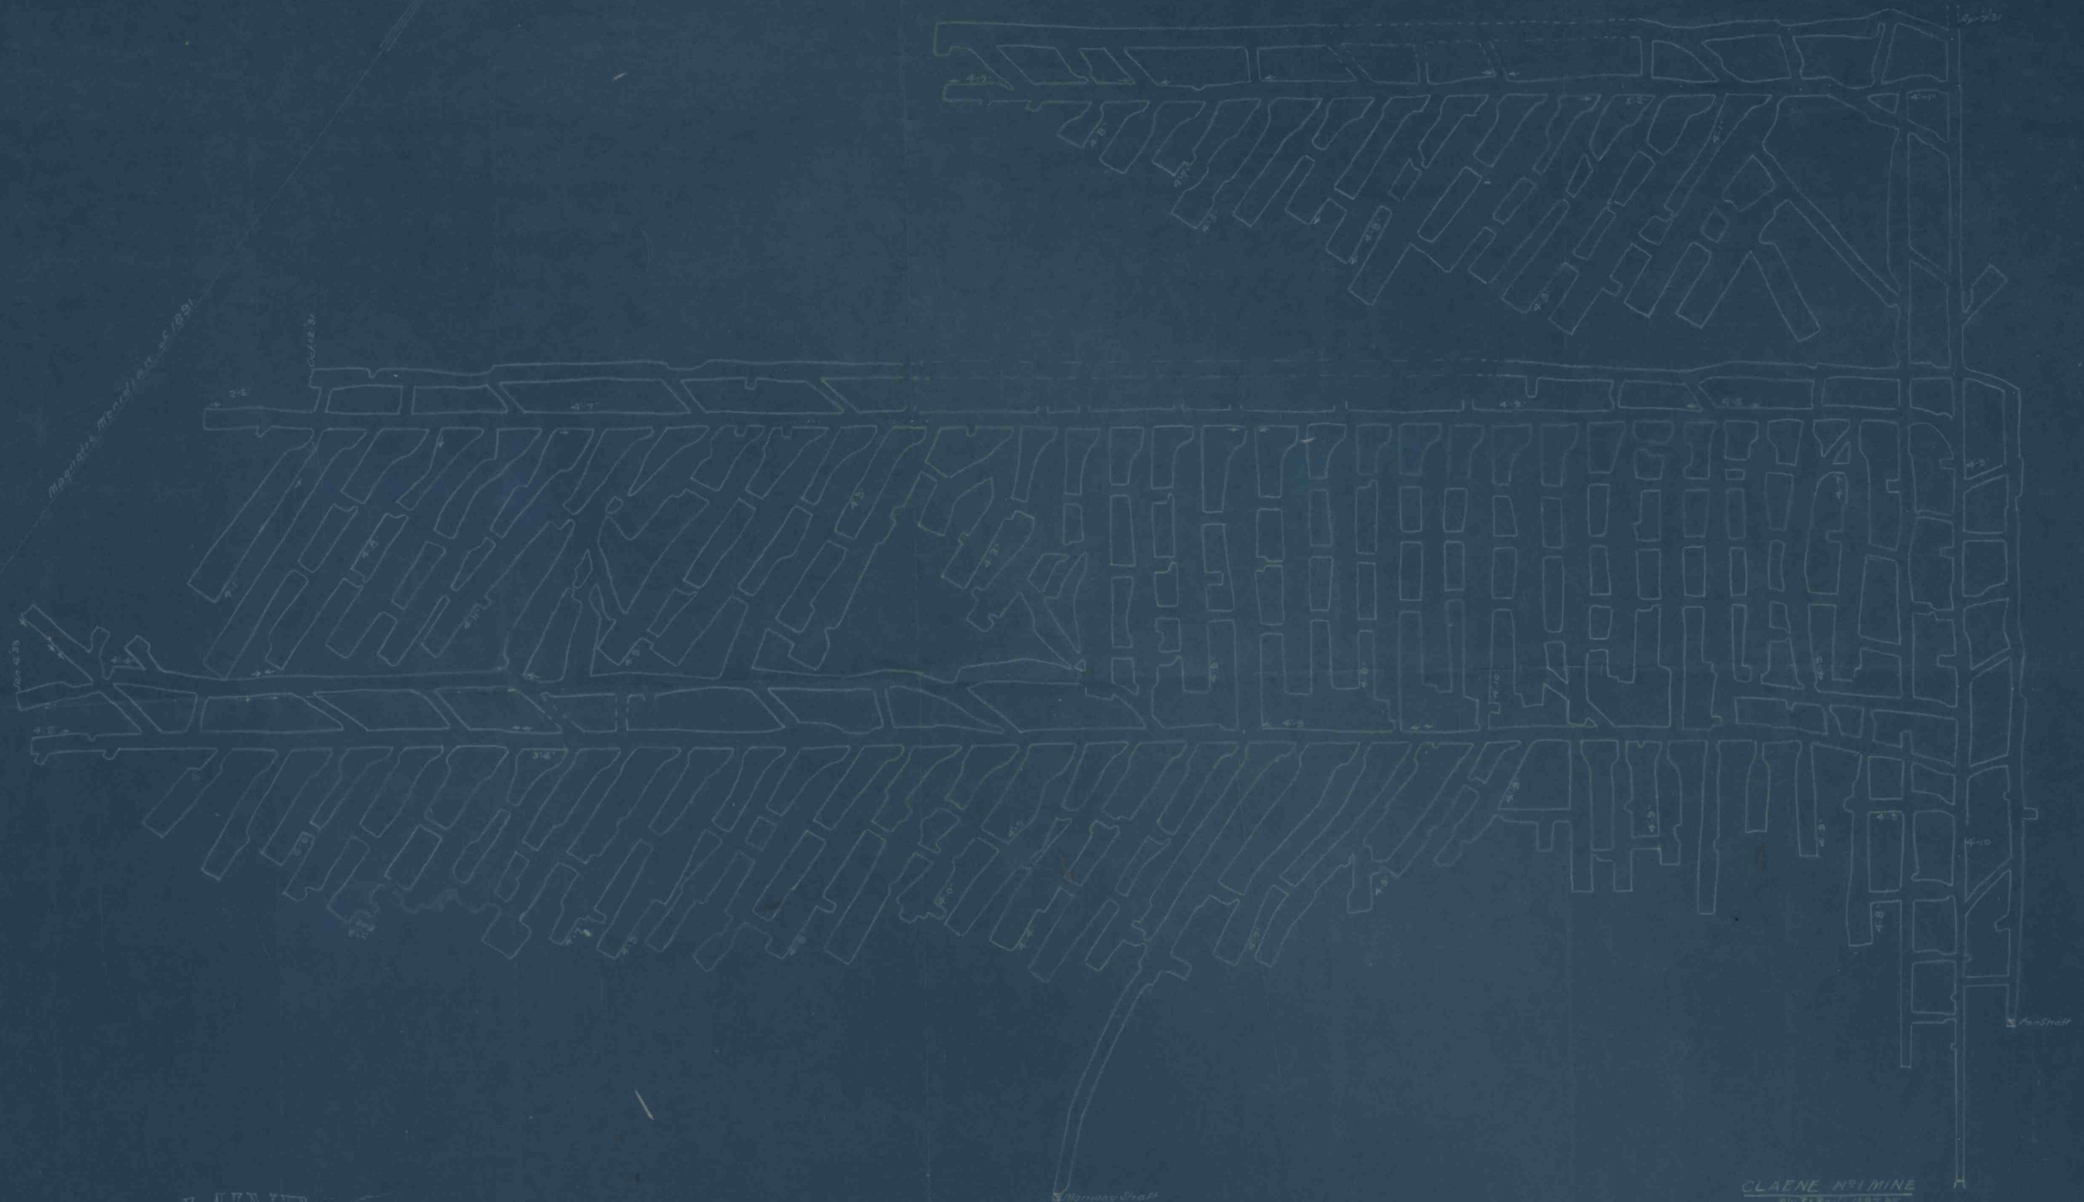


# MAP OF CLAENE No. 1 MINE

OPERATED BY

GEO. W. MINDS

in Gulich Twp., Clearfield Co., Penna.

Scale: 1"=100

H. S Shillingford,
Mining Engineer

2/19/32

#5446
6-25-99
C.C.