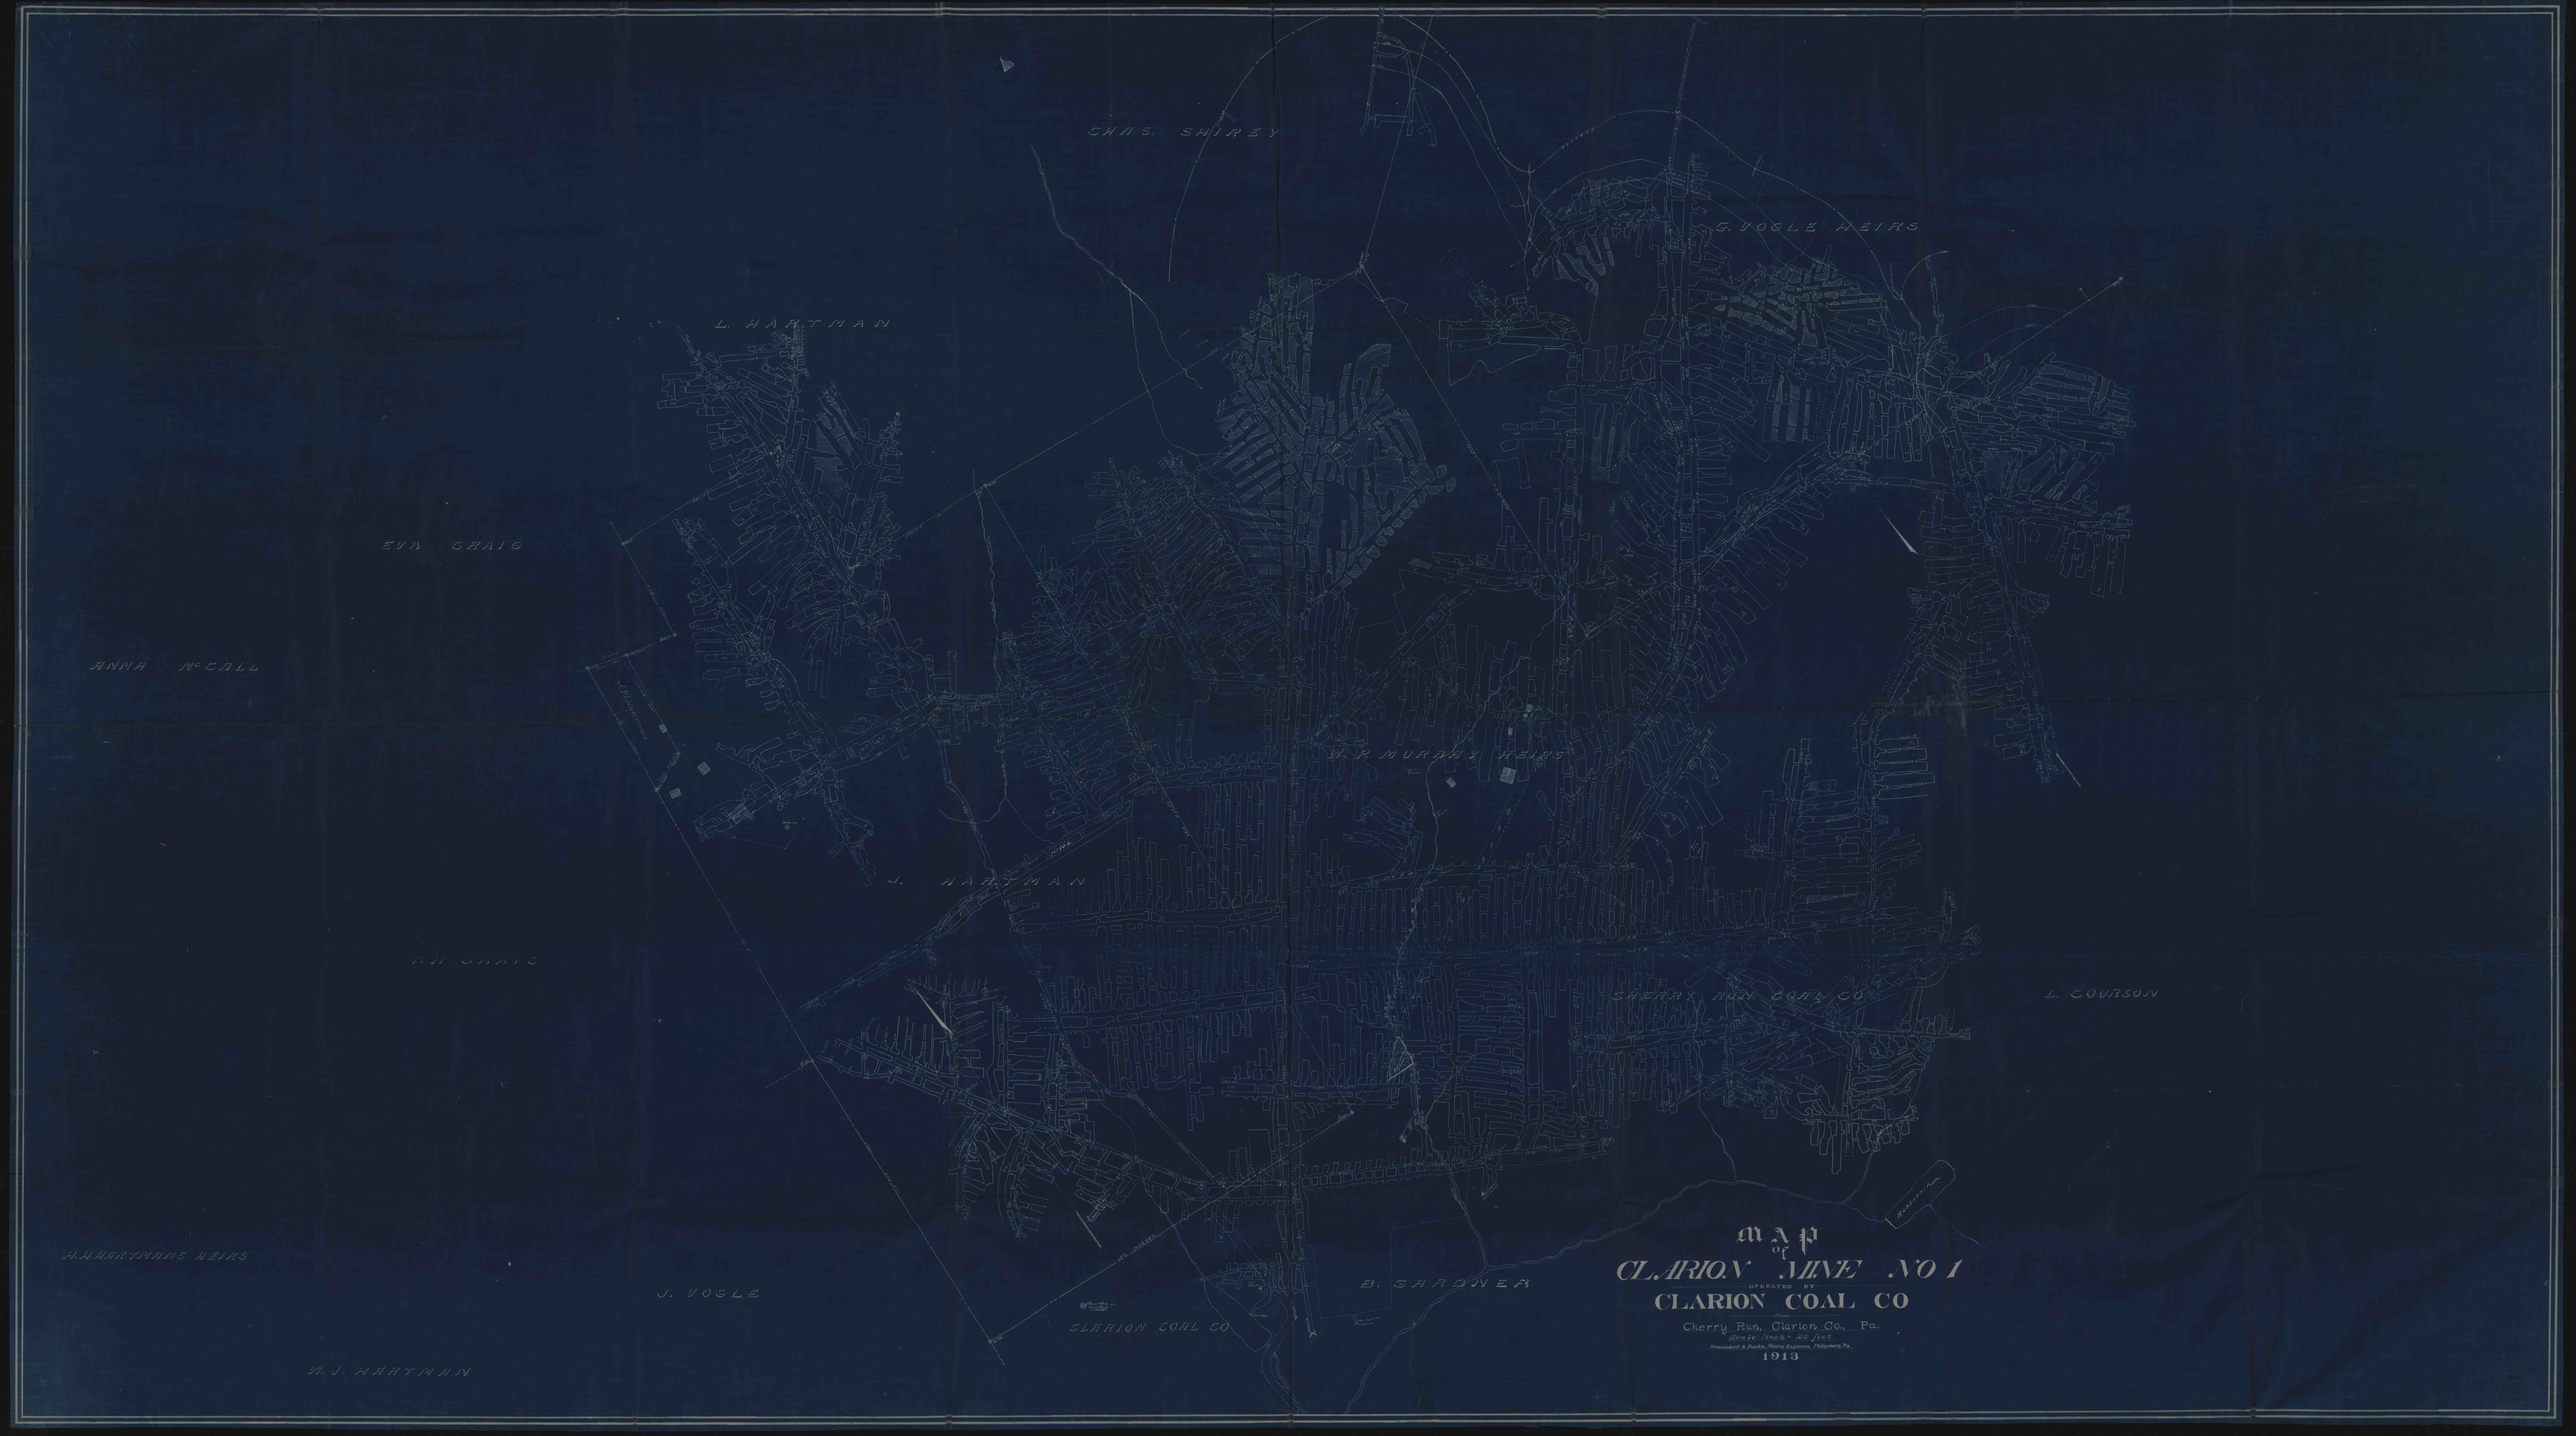
CHAS. SHIREY
G. VOGLE HEIRS
L. HARTMAN
EVA CRAIG
ANNA Mc CALL
W.P. MURRAY HEIRS
J. HARTMAN
H.H. CRAIG
CHERRY RUN COAL CO.
L. COURSON
M.M.HARTMANS HEIRS
J. VOGLE
CLARION COAL CO
B. GARDNER
M.J. HARTMAN
MAP
of
CLARION MINE NO 1
OPERATED BY
CLARION COAL CO
Cherry Run, Clarion Co., Pa.
One inch = 100 feet
Wooddell & Dunkle, Mining Engineers, Philipsburg Pa.
1913