

Rail Road Ave.

Broad Street

Chestnut

street


Rockhill Coal Co.

Map Showing Mine Workings Under I.O.O.F. Cemetery in Broad Top Borough, Huntingdon County, Pa. Owned And Operated By Ralph Clark

Huntingdon County  
Borough, Huntingdon, Penna.  
1" = 100' Scale

Dist. 18

1851  
1899  
1898  
1897

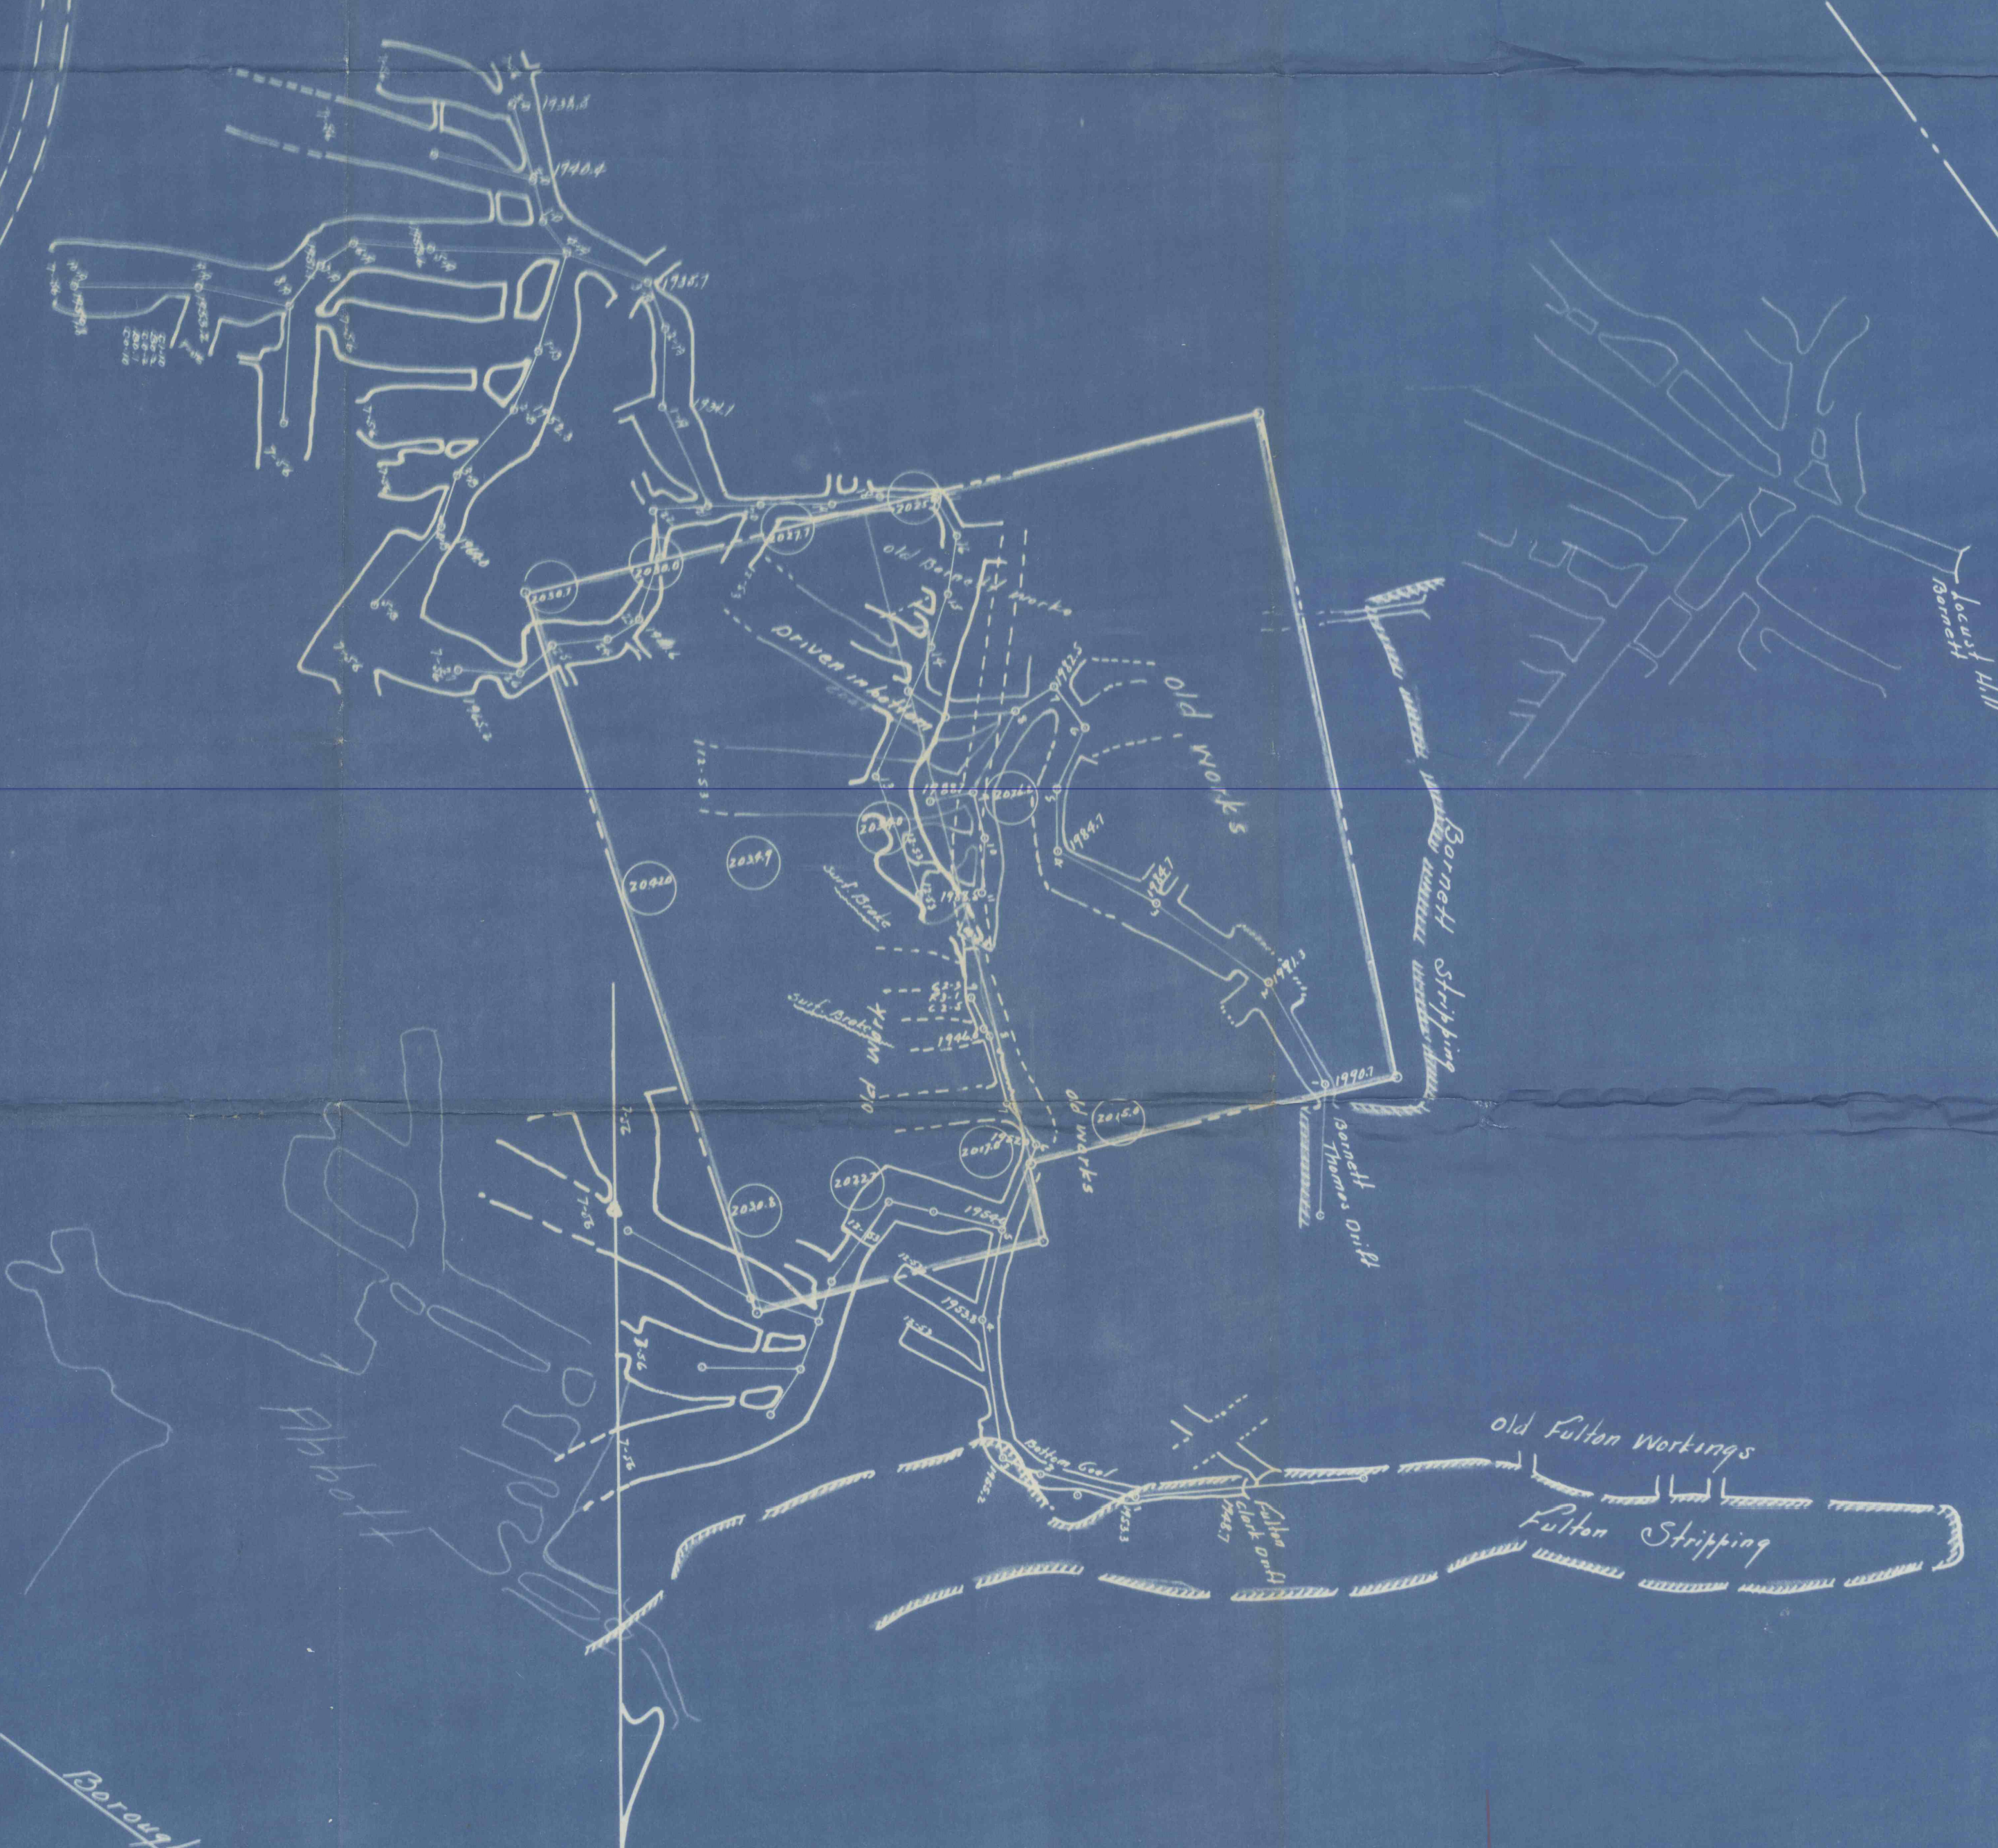

Borough Line  
B. Abbott

Old Follen Workings  
Follen Stripping