


Survey Letter	Date of Survey
A	Jan. 1, 1927.
B	July 25, 1927.
C	Aug. 24, 1927.
D	March 5, 1936.
E	April 23, 1936.
F	May 26, 1936.
G	June 23, 1936.
H	Aug. 4, 1936.
I	Nov. 27, 1936.
J	Sept. 29, 1936.
K	Oct. 29, 1936.
L	March 9, 1937.
M	Nov. 18, 1937.
N	Dec. 30, 1937.
P	Feb. 9, 1938.

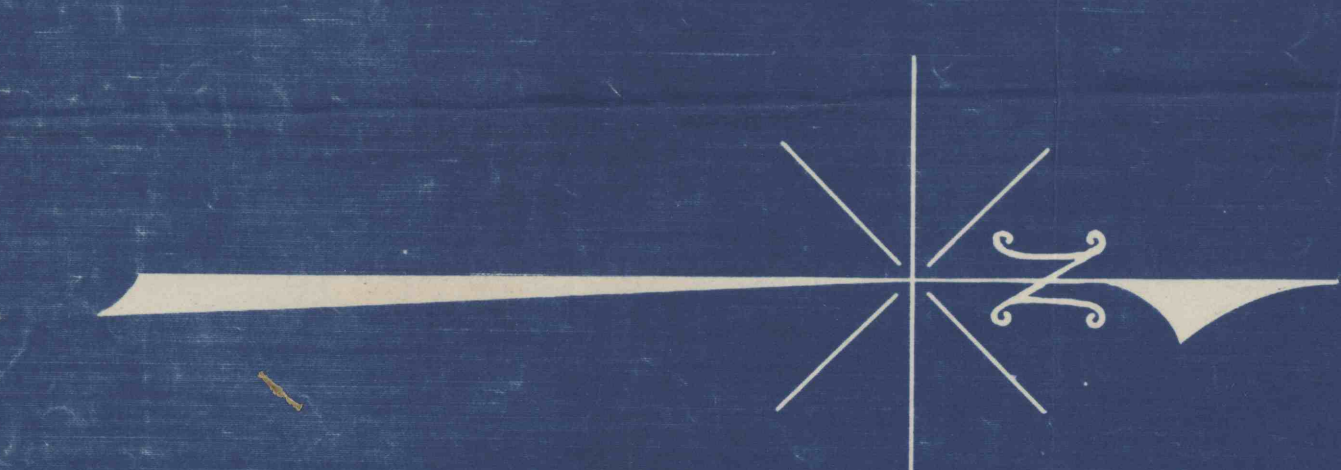

Note "C.R." — Mine Workings Of Chas. Renstrom, Lessee Of A Portion Of Clipper Mine.
 Note "R.F." — 1/2 Acre Of Pittsburgh Coal Vein Reserved To Robert Farquhar Heirs.
 Note "O.W." — Approximate Location Of Old Workings Of Clipper Mine Shown By Light Dotted Lines.

APPENDIX

STATE OF PENNSYLVANIA)
 COUNTY OF WASHINGTON) ss:
 Personally appeared before me, the subscriber, a Notary Public, in and for the said County and State, E. C. Fitz Simons, who being duly sworn according to law, deposes and says that he is a Registered Professional Engineer of the Pittsburgh Steel Company and that the attached drawing marked "Monessen Coal and Coke Company, Drawing No. 727-6", is a true and correct map showing the coal mined out of Clipper Mine, Borough of Alleensport, Washington County, Pennsylvania; by Charles Renstrom, Lessee and later by Sarah Renstrom, Lessee; as of February 10th, 1938.

E. C. Fitz Simons

Shown and subscribed to before me, this 11th day of February, 1938.

[Signature]
 NOTARY PUBLIC
 My Commission Expires Feb. 23, 1941.

MONESSEN COAL AND COKE CO.
 ALICIA, PA.

SUBJECT MINE MAP,
 PITTSBURGH COAL VEIN,
 CHAS. RENSTROM, LESSEE.

FOR CLIPPER MINE,
 BOROUGH OF ALLEENSPORT,
 WASHINGTON COUNTY, PA.

SCALE 1" = 100'
 DRAWN BY p.s. DATE Feb. 18, 1938.
 CHECKED BY " " " "
 REVISED " " " "

DATE PRINTED DRAWING NUMBER
 2-11-38. 7276.

E. C. Fitz Simons