


Nowak Coal Co  
1913

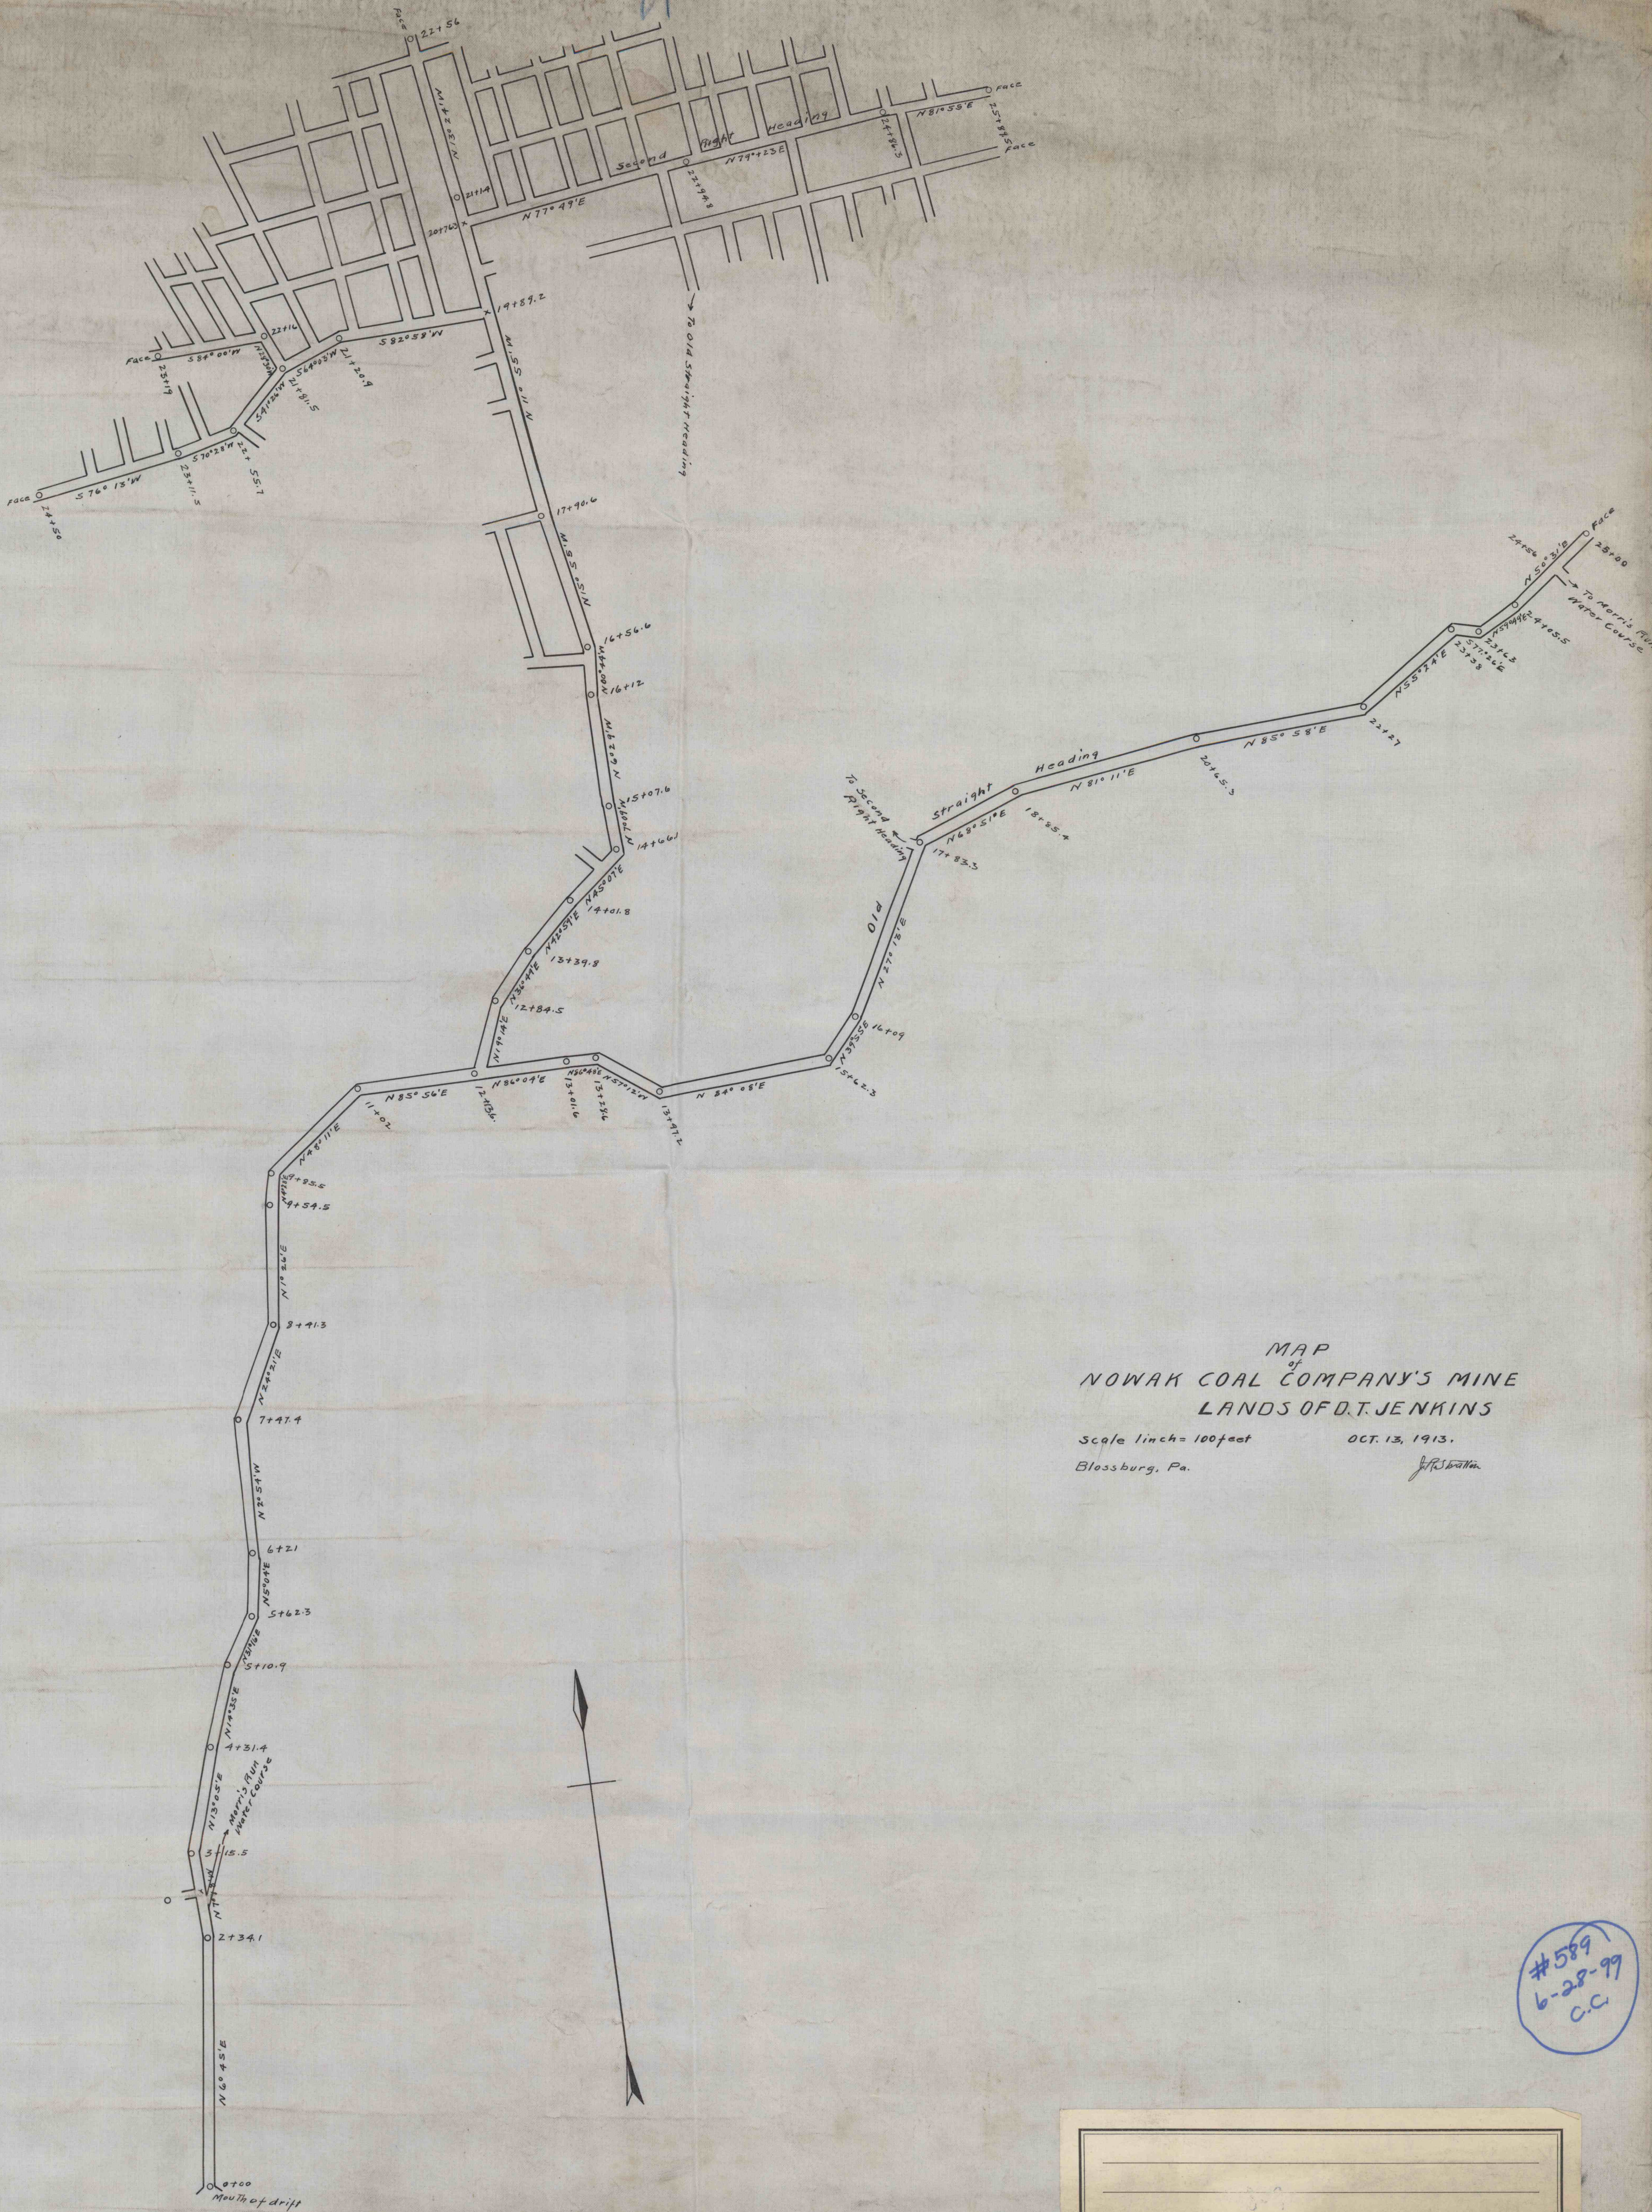

MAP  
 OF  
 NOWAK COAL COMPANY'S MINE  
 LANDS OF D. T. JENKINS  
 Scale 1 inch = 100 feet  
 Blossburg, Pa.  
 OCT. 13, 1913.  
 J. R. Swann

#589  
 6-28-99  
 C.C.

COMMONWEALTH OF PENNSYLVANIA  
 DEPARTMENT OF MINES  
 HARRISBURG

To Nowak Coal Company  
 LANDS OF D. T. JENKINS

DMAD-2