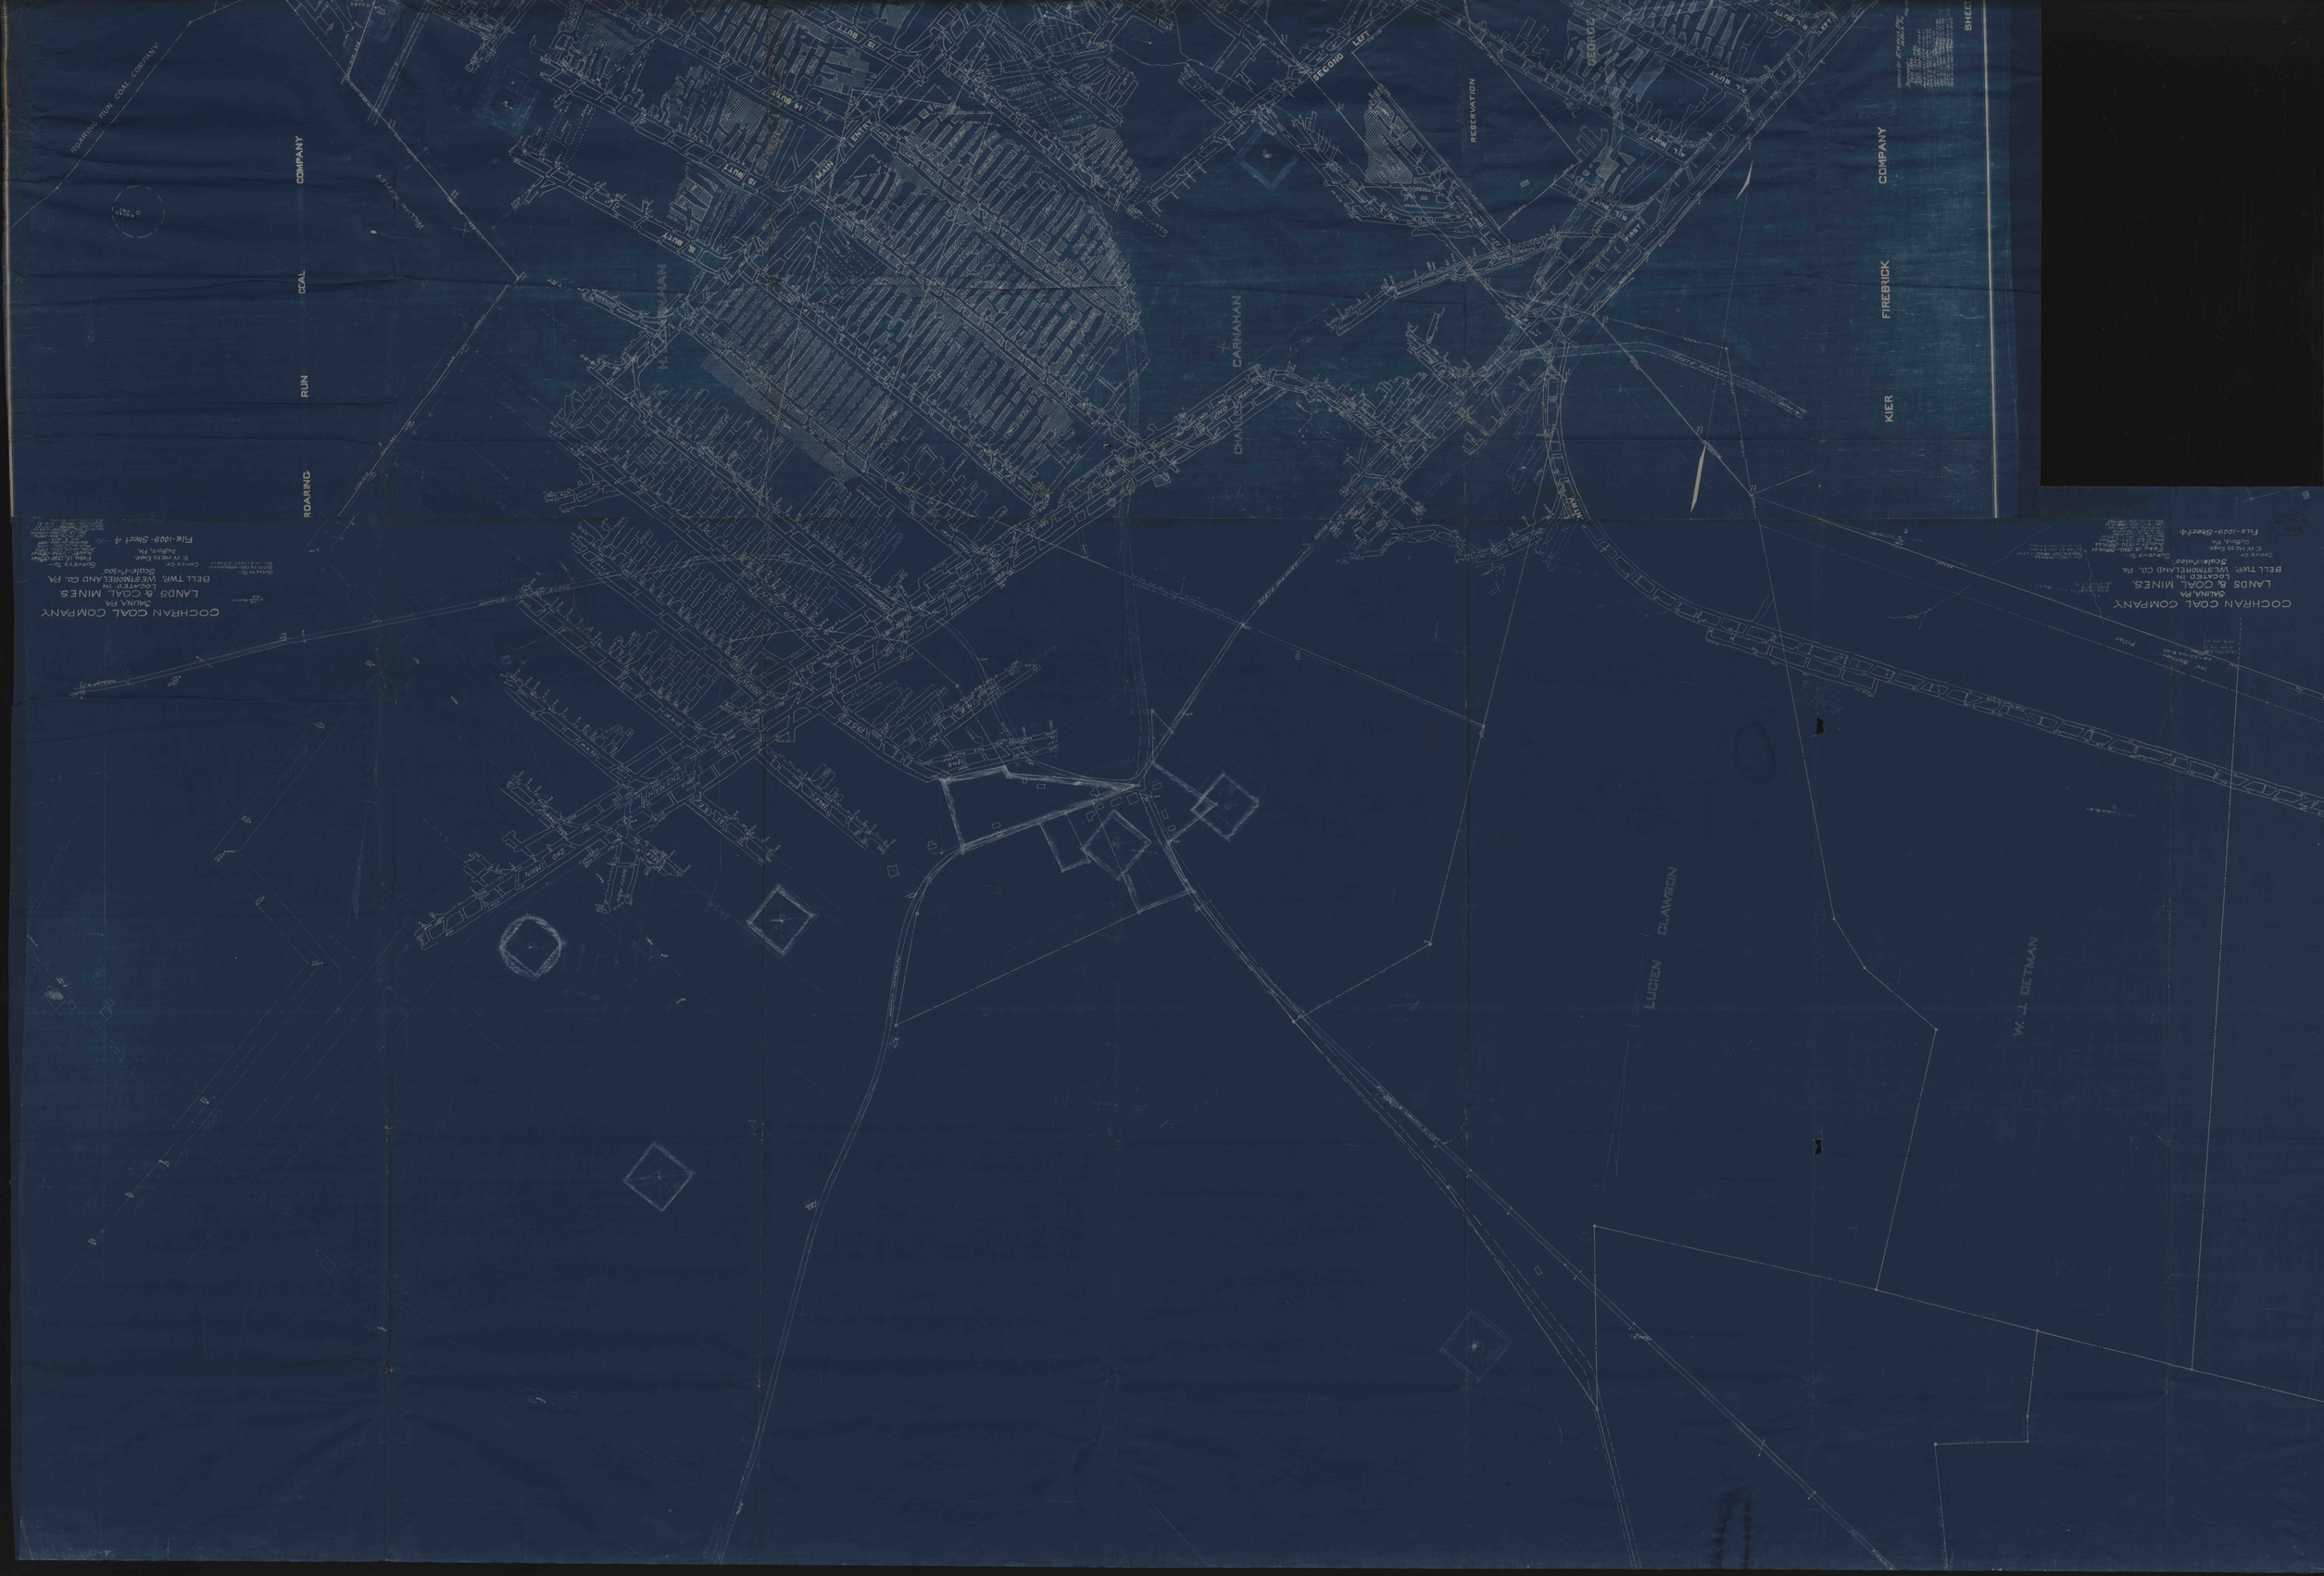
ROARING RUN COAL COMPANY
ROARING RUN COAL COMPANY
CARNAHAN
CHARLES
RESERVATION
SECOND LEFT
KIER FIREBRICK COMPANY
LUCIEN CLAWSON
W. J. DETMAN
COCHRAN COAL COMPANY
SALINA, PA.
LANDS & COAL MINES.
LOCATED IN
BELL TWP., WESTMORELAND CO., PA.
Scale: 1"=100'
Survey To:-
Feet is 1930-Annual
Orrice of
E.W. Hess Engr.
DuBois, PA.
File-1009-Sheet 4