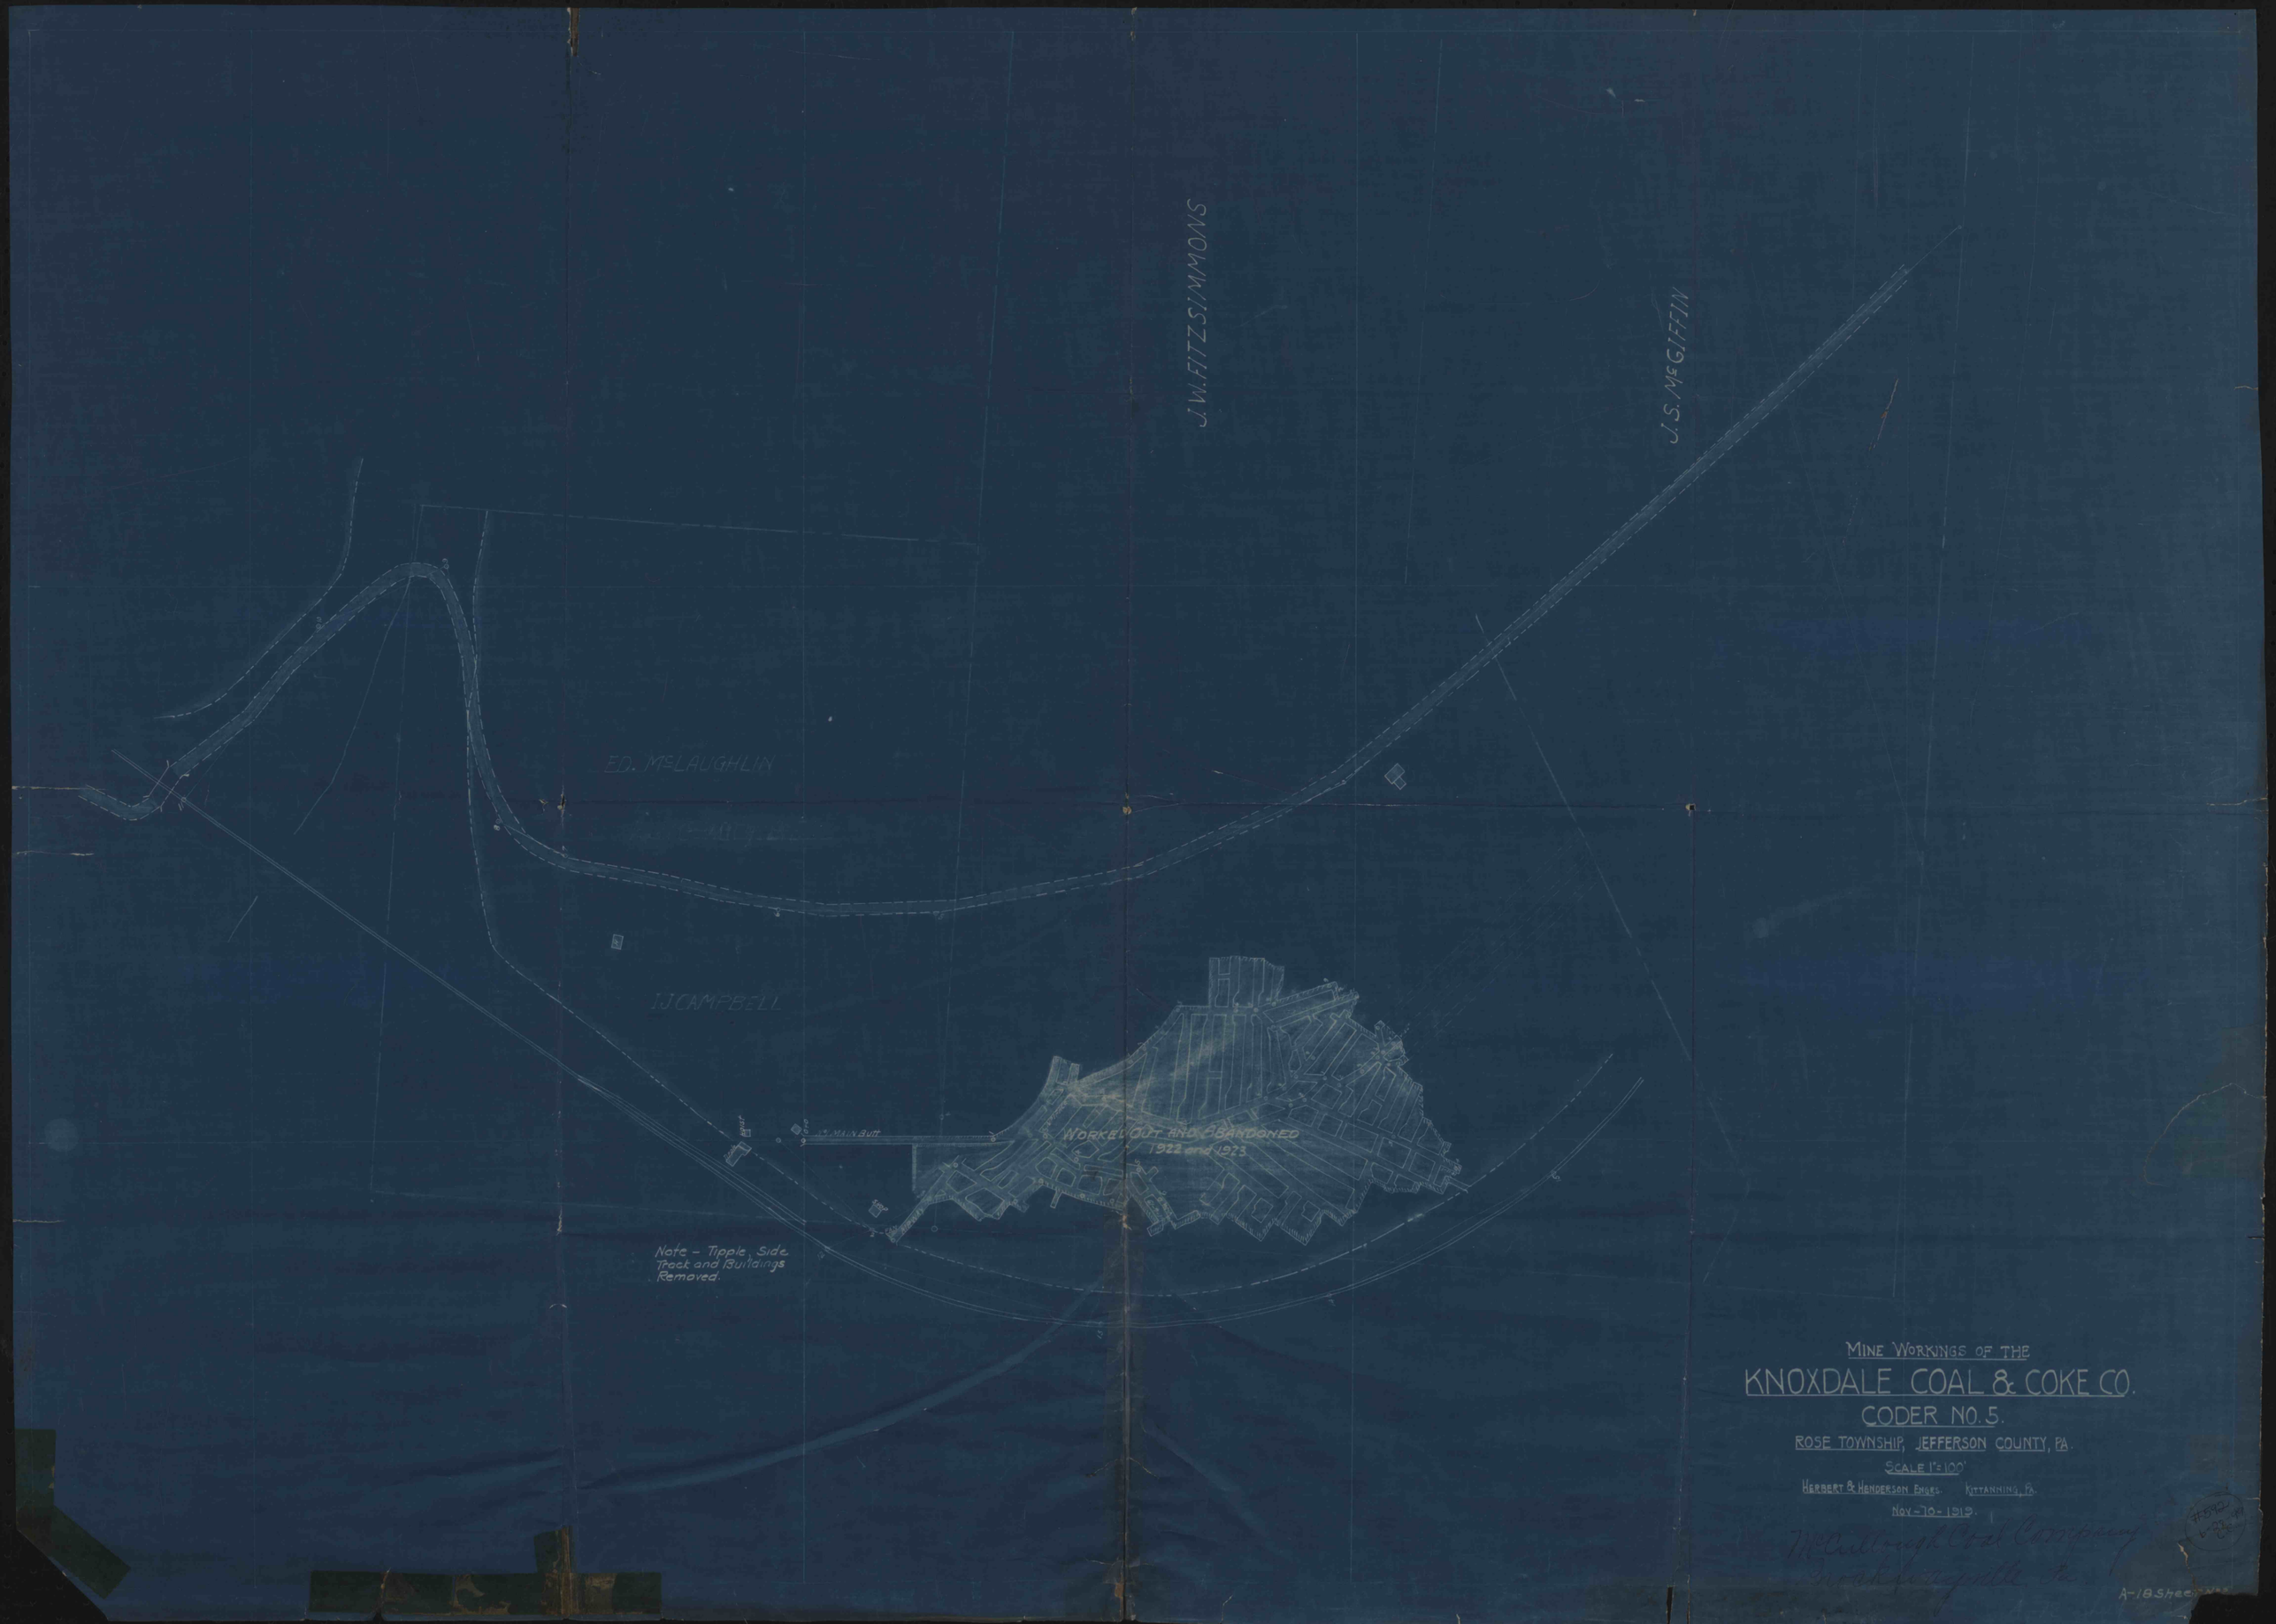
J.W. FITZSIMMONS
J.S. McGIFFIN
ED. McLAUGHLIN
I.J. CAMPBELL
MAIN BUTT
WORKED OUT AND ABANDONED
1922 and 1923
Note - Tipple, Side Track and Buildings Removed.
MINE WORKINGS OF THE
KNOXDALE COAL & COKE CO.
CODER NO. 5.
ROSE TOWNSHIP, JEFFERSON COUNTY, PA.
SCALE 1" = 100'
HERBERT & HENDERSON ENGRS. KITTANNING, PA.
NOV-10-1919.
McCullough Coal Company
Brookwayville Pa.
A-18 Sheet No.