


WASHINGTON COAL & COKE CO.

1202A

BOUNDARY

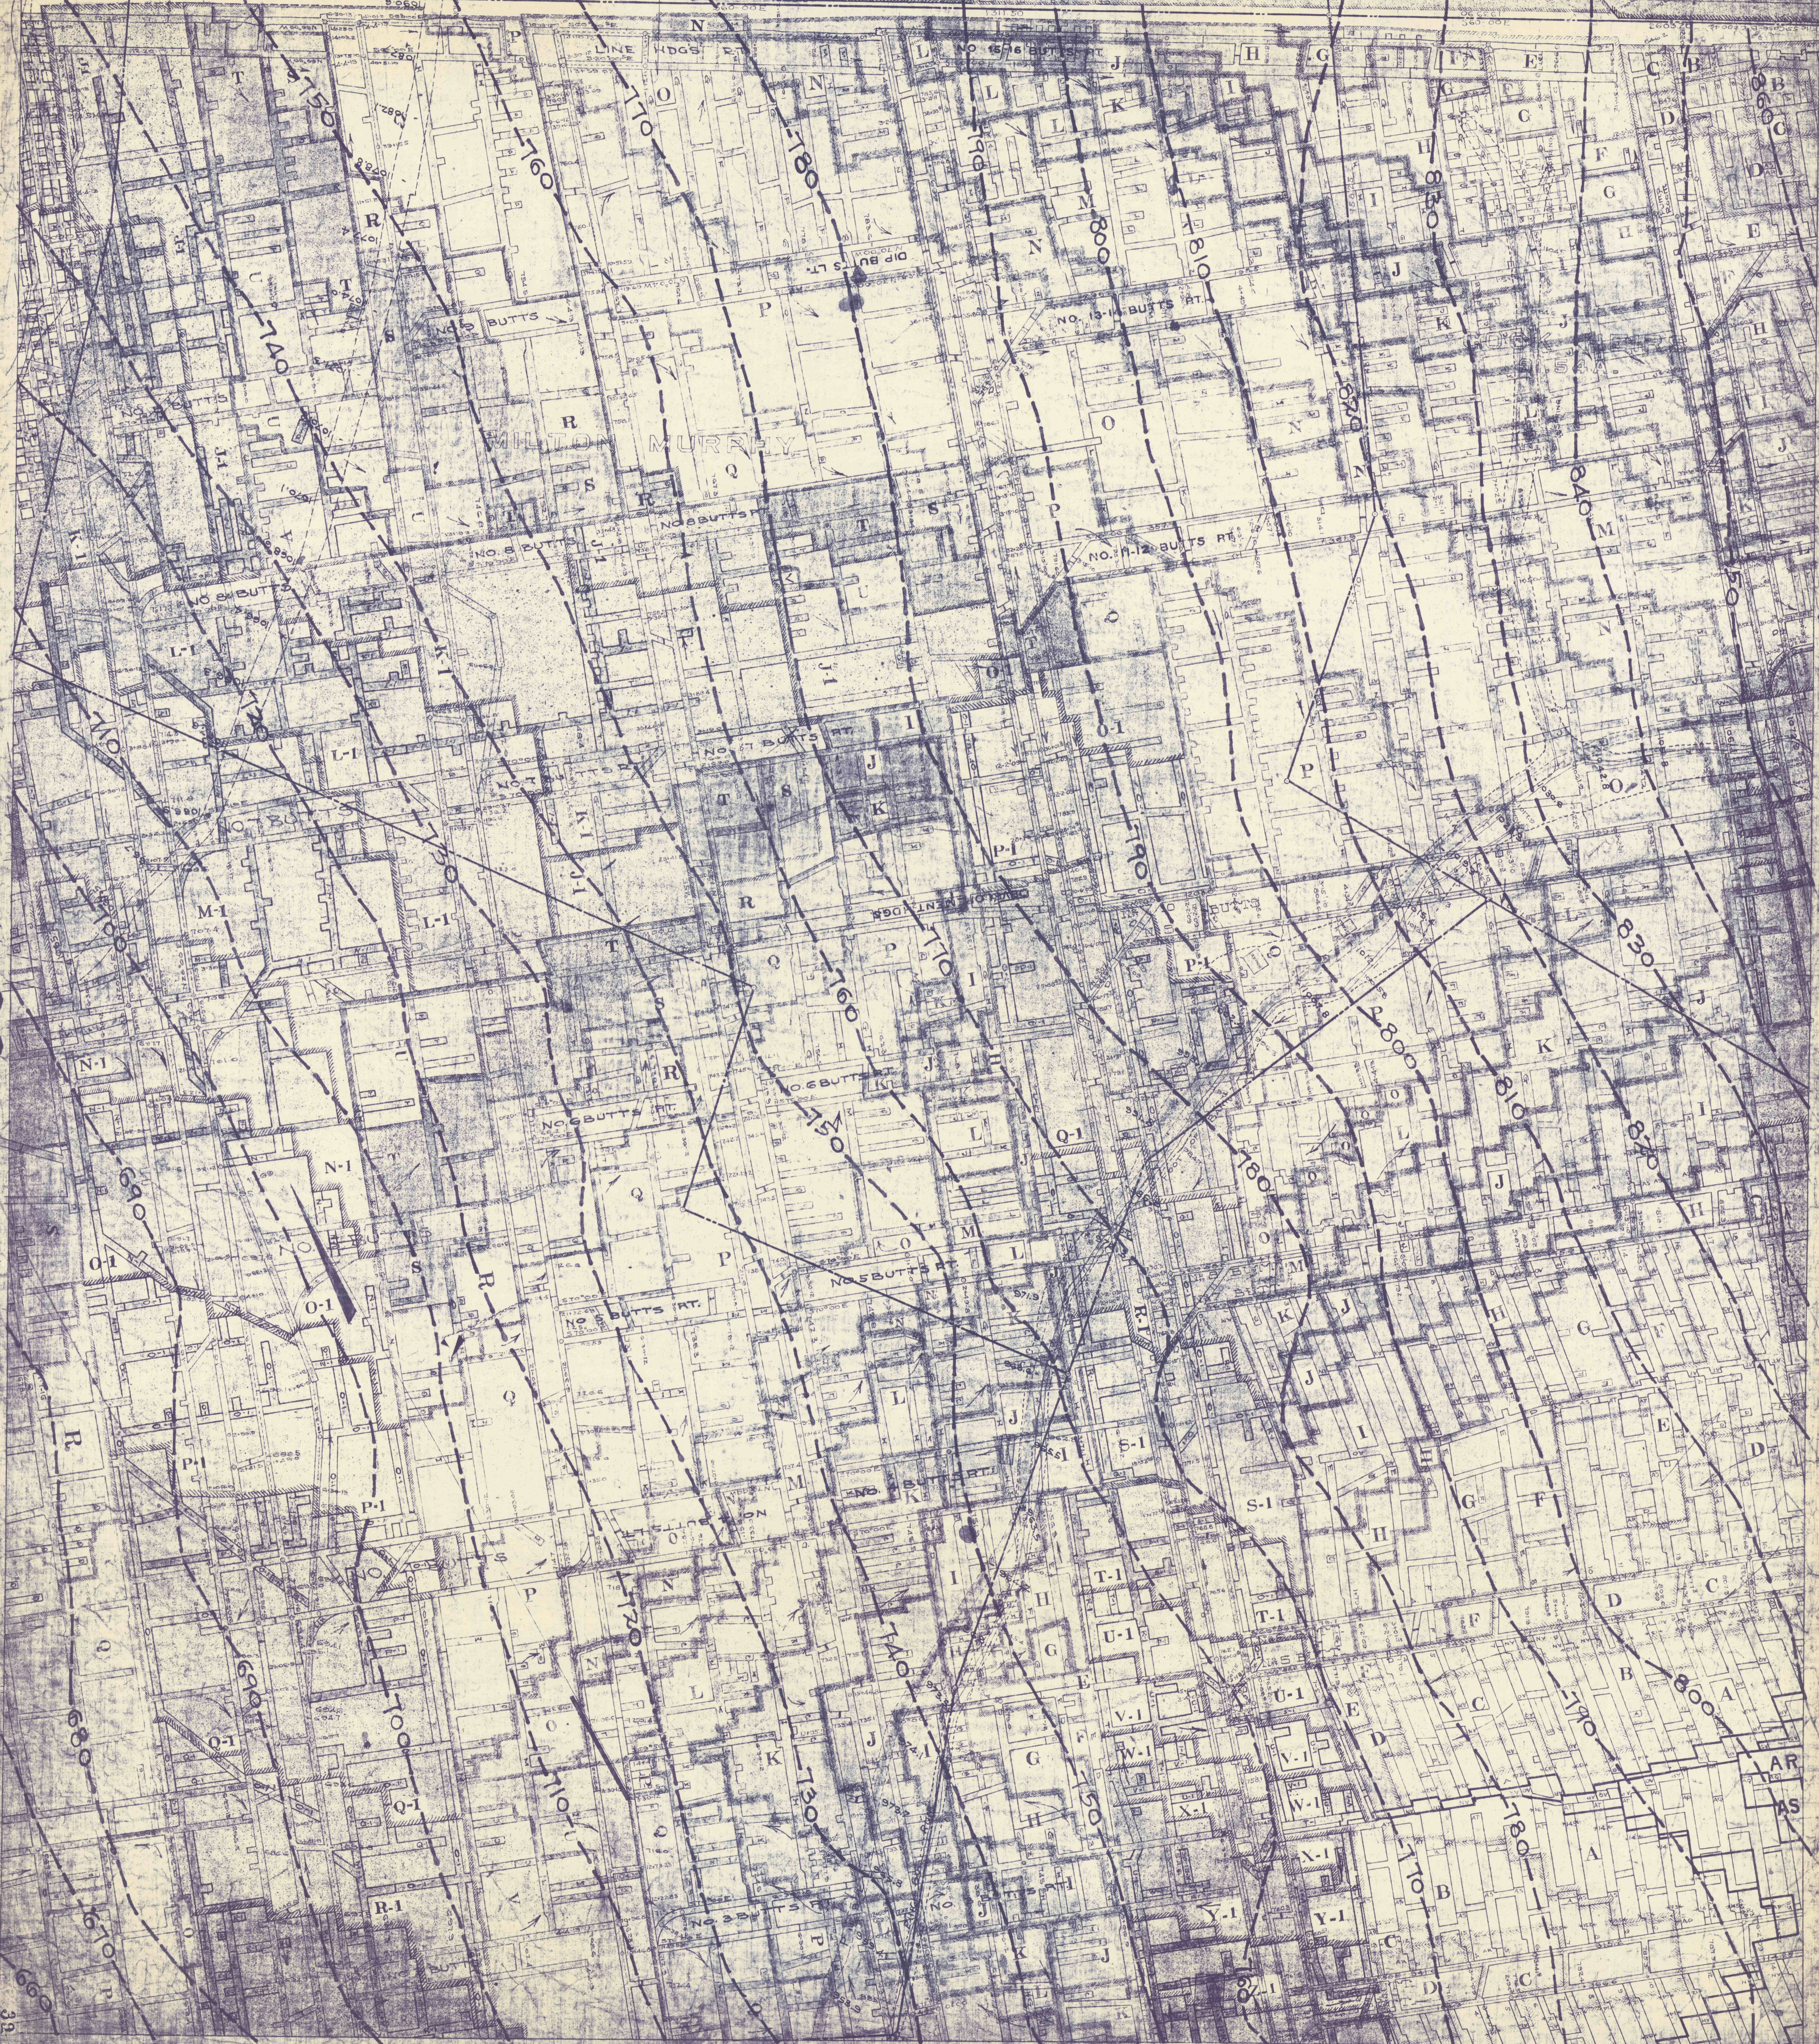

File to 38 38

File to 40 40