





26

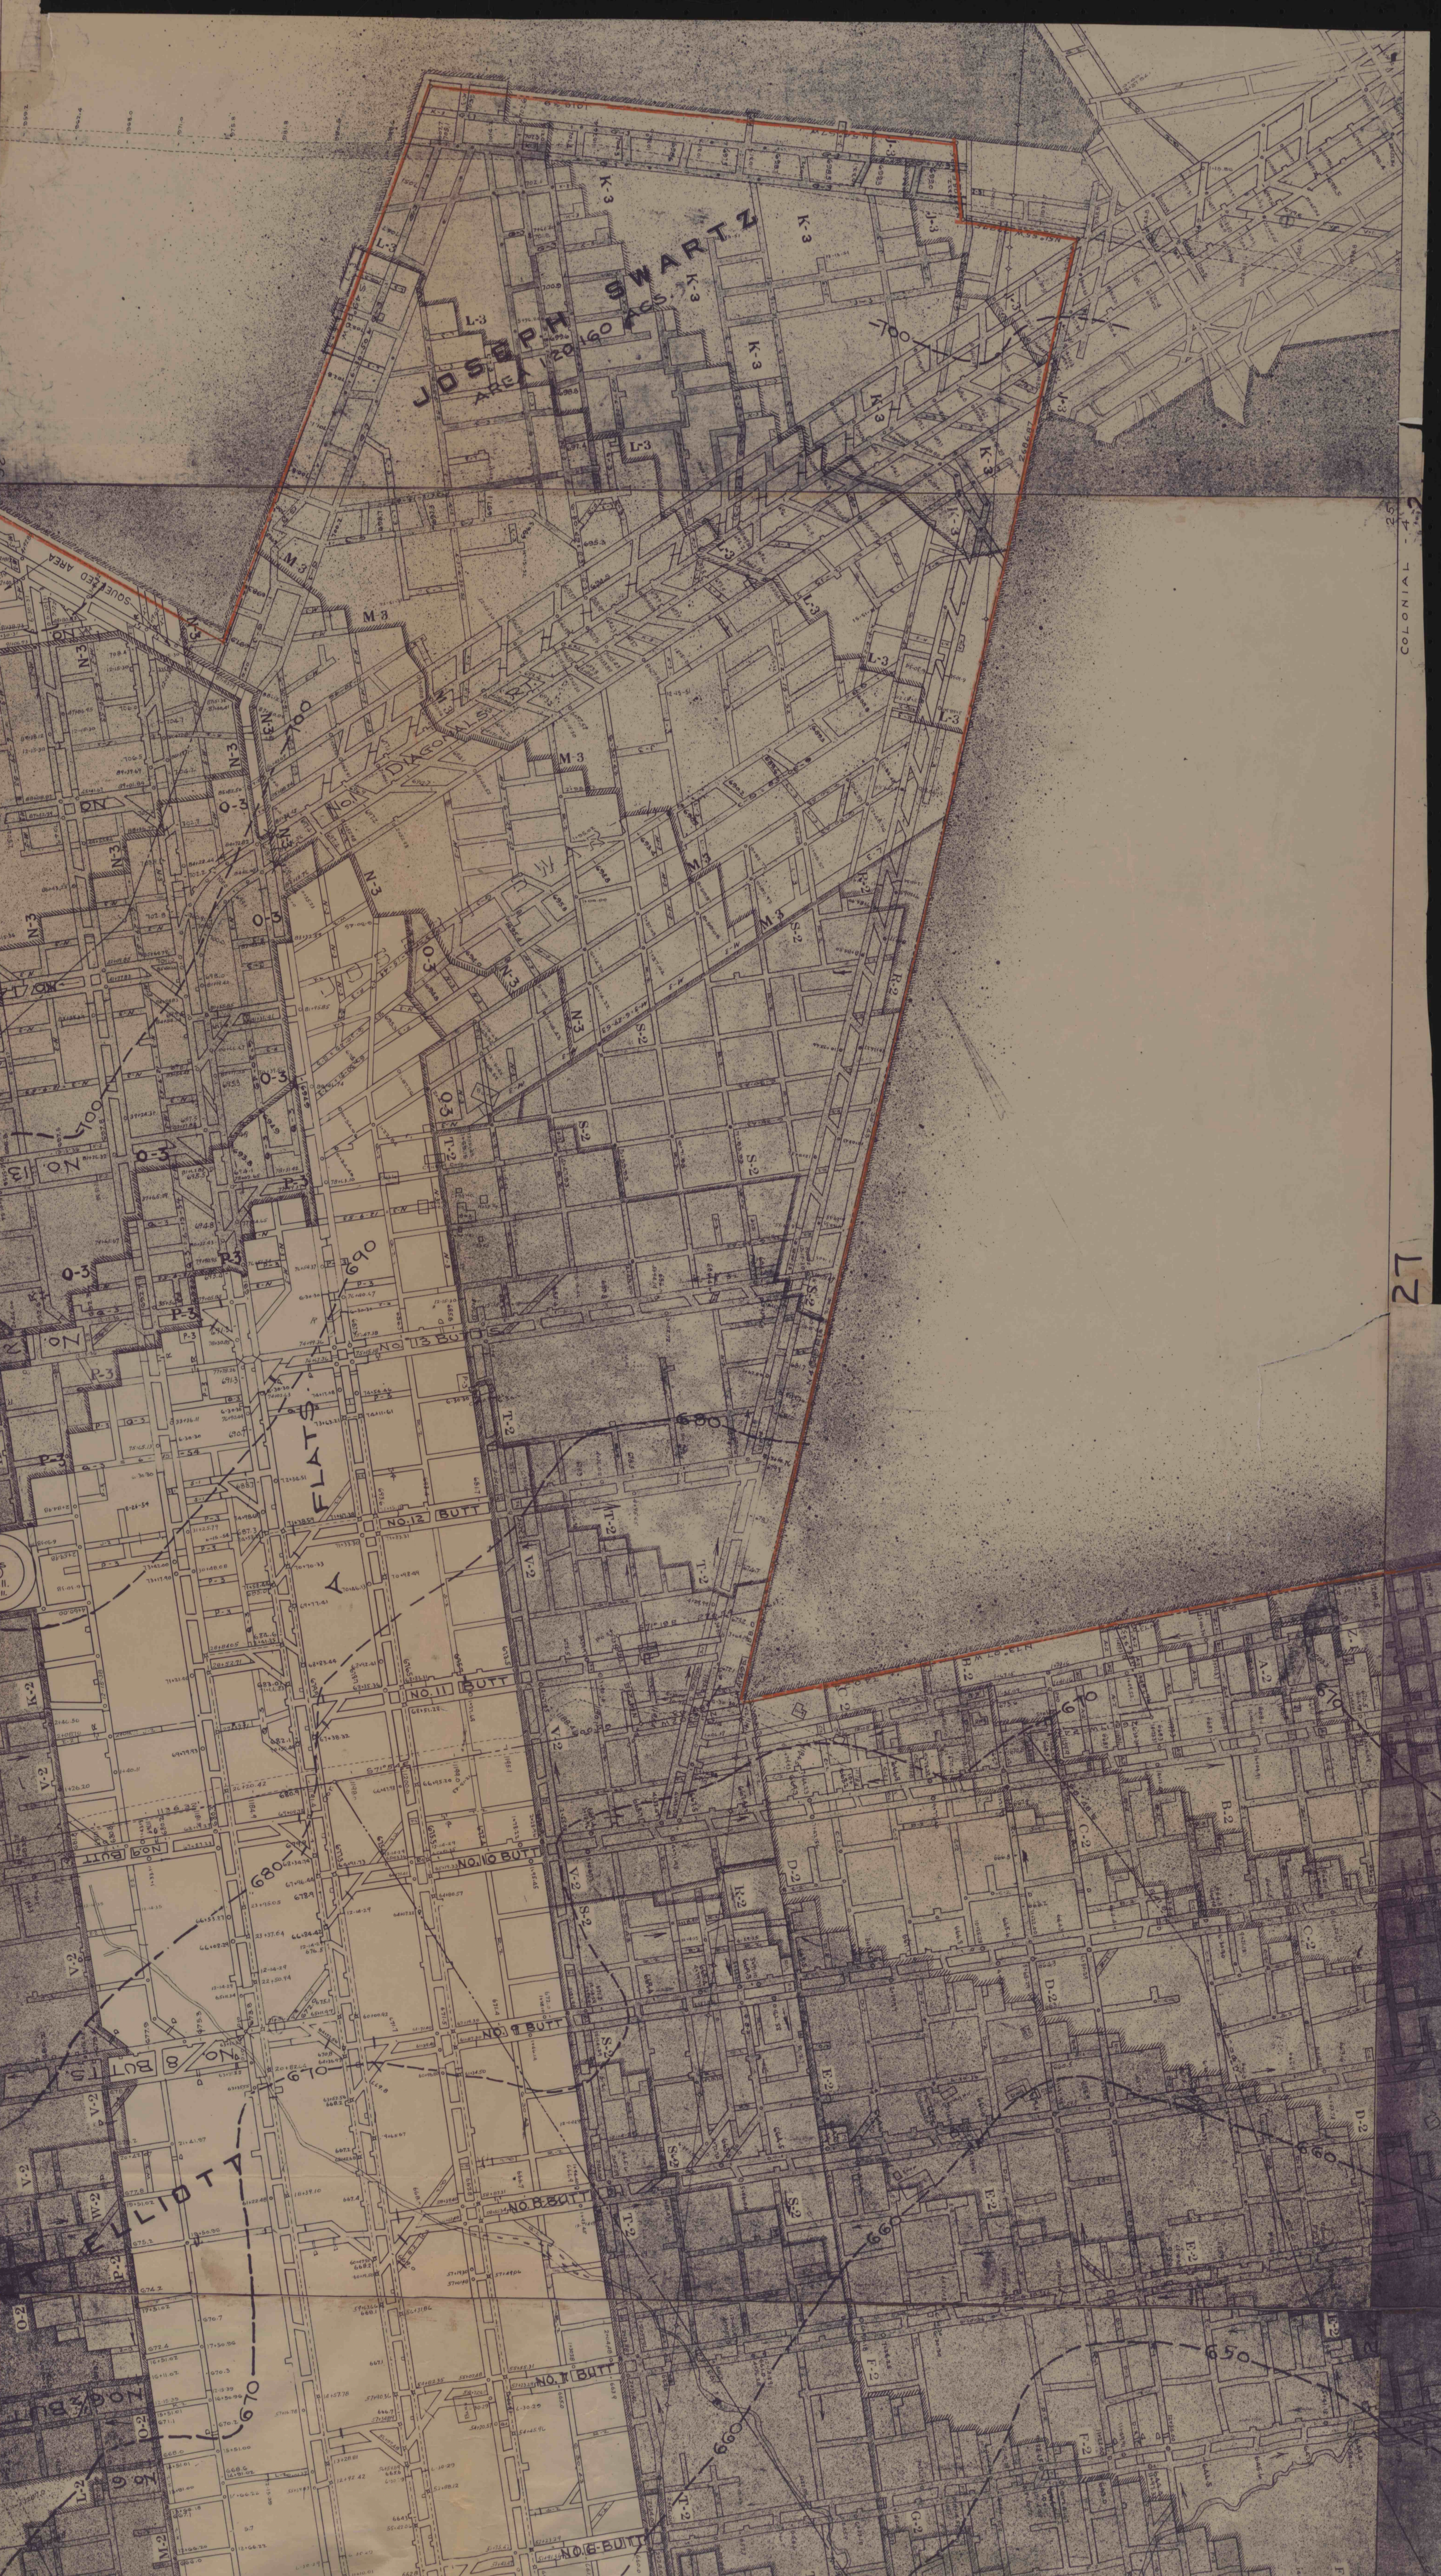

27

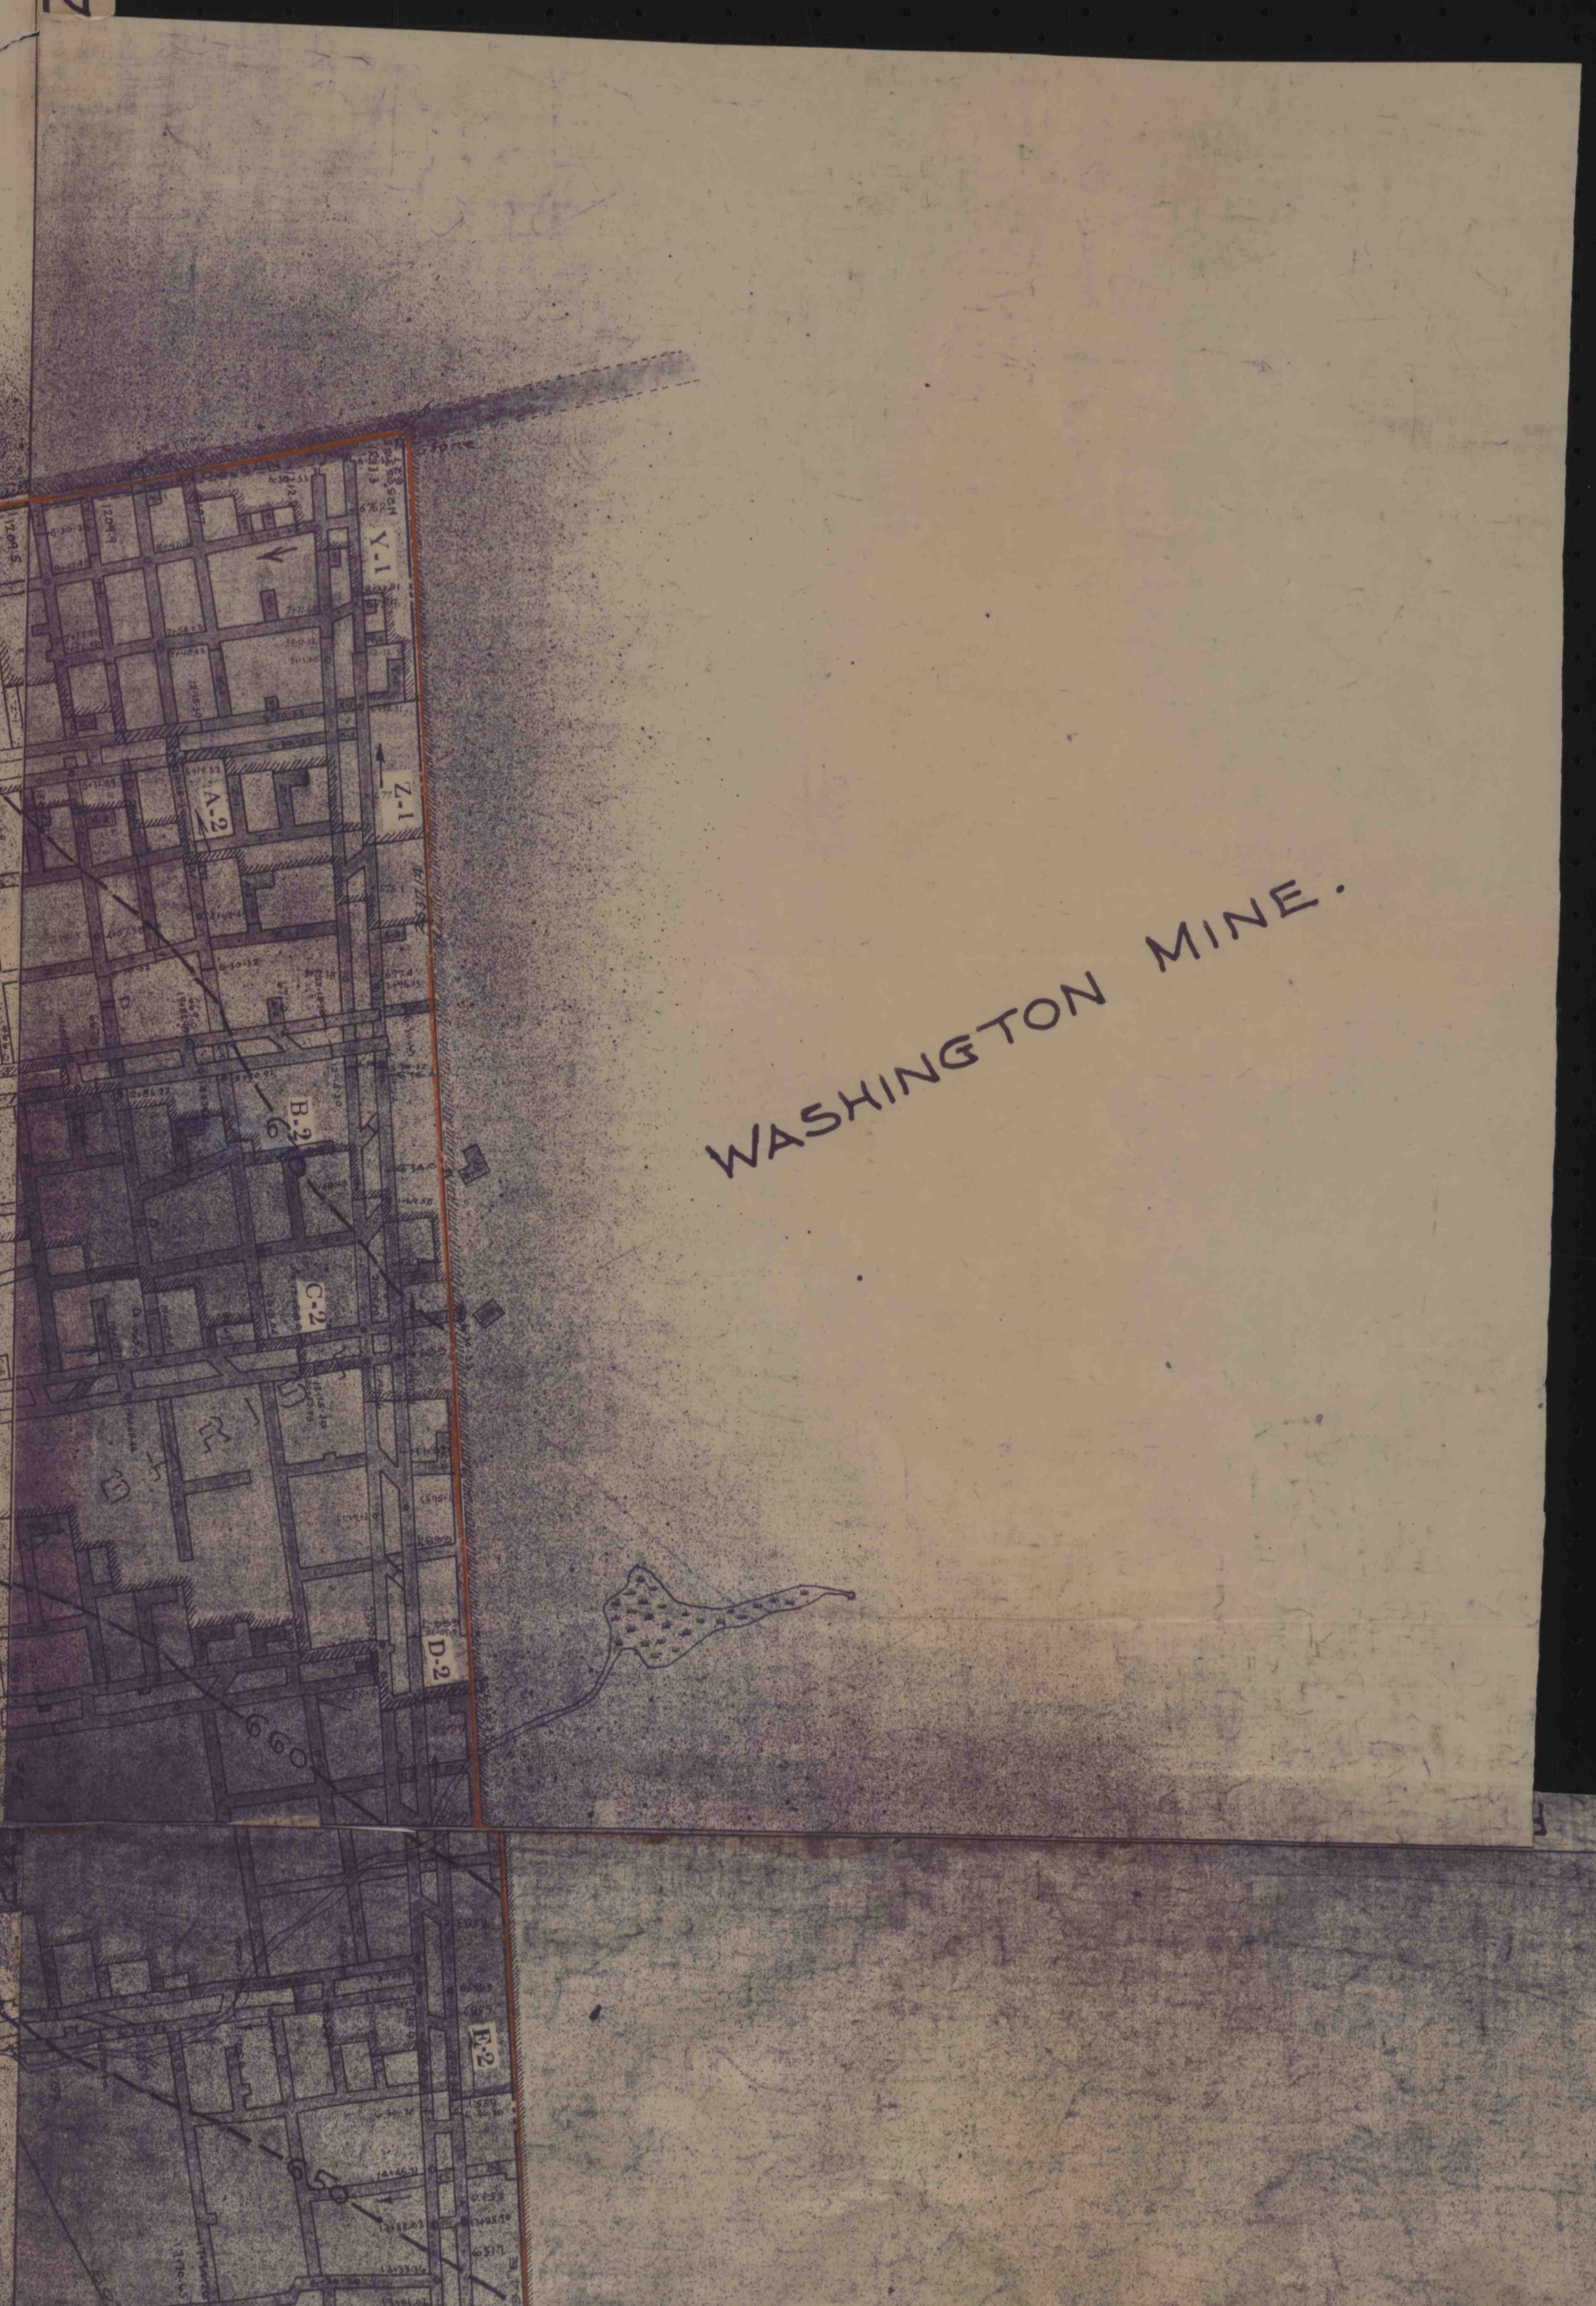

28