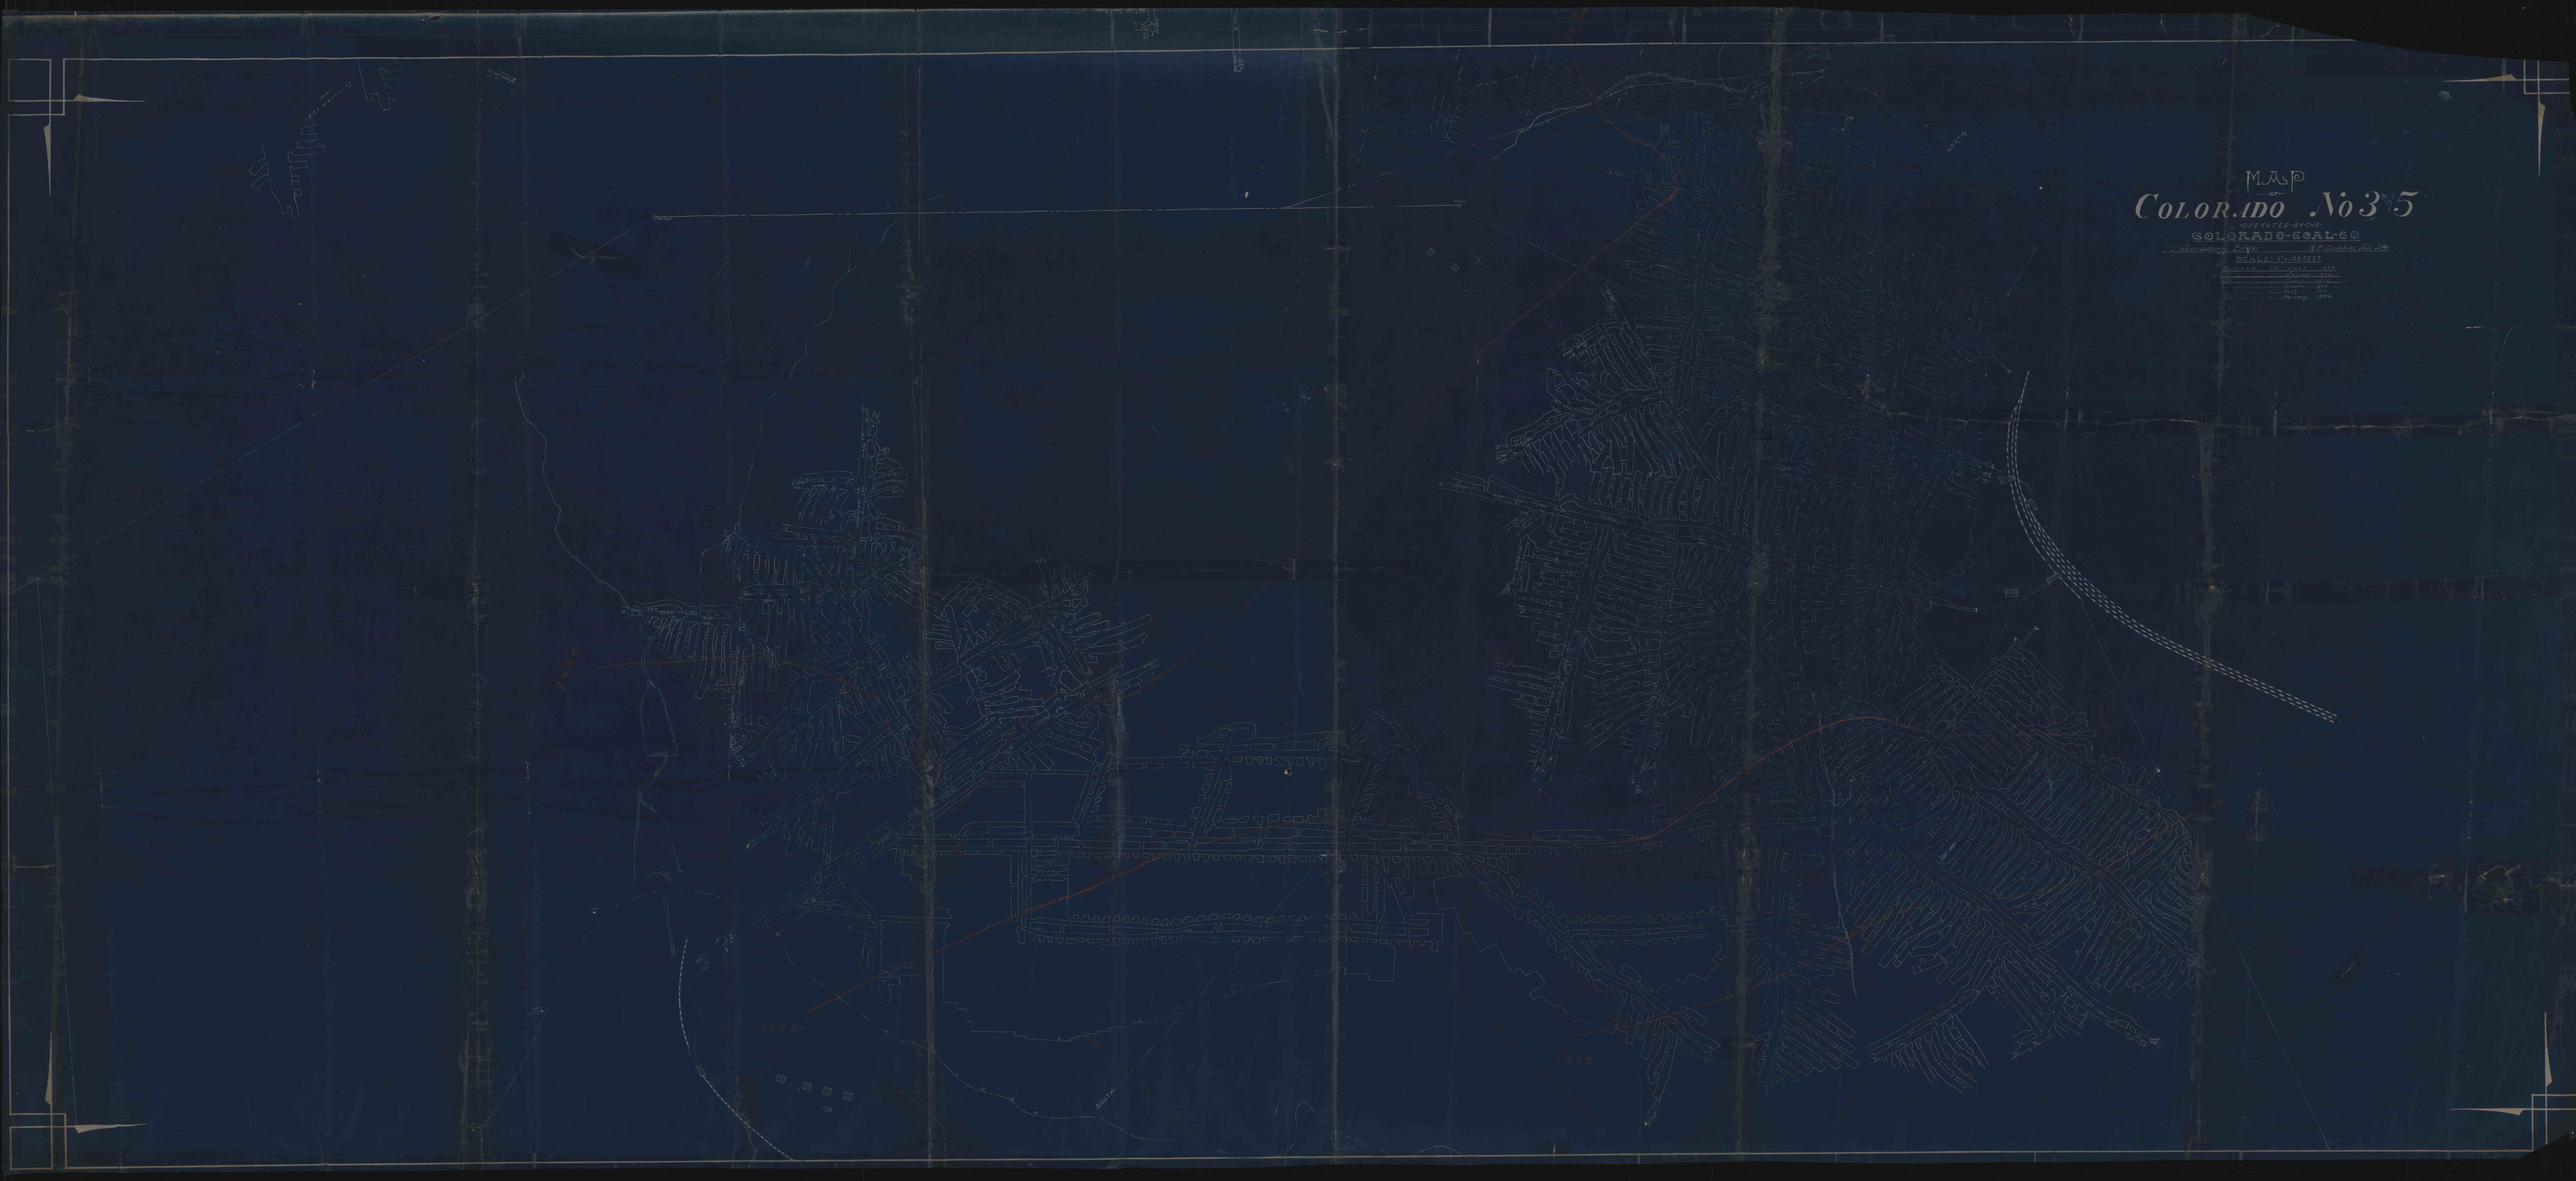
Map
of
Colorado No 3 5
Operated by the
Colorado Coal Co
Scale 1 Inch = 100 Feet