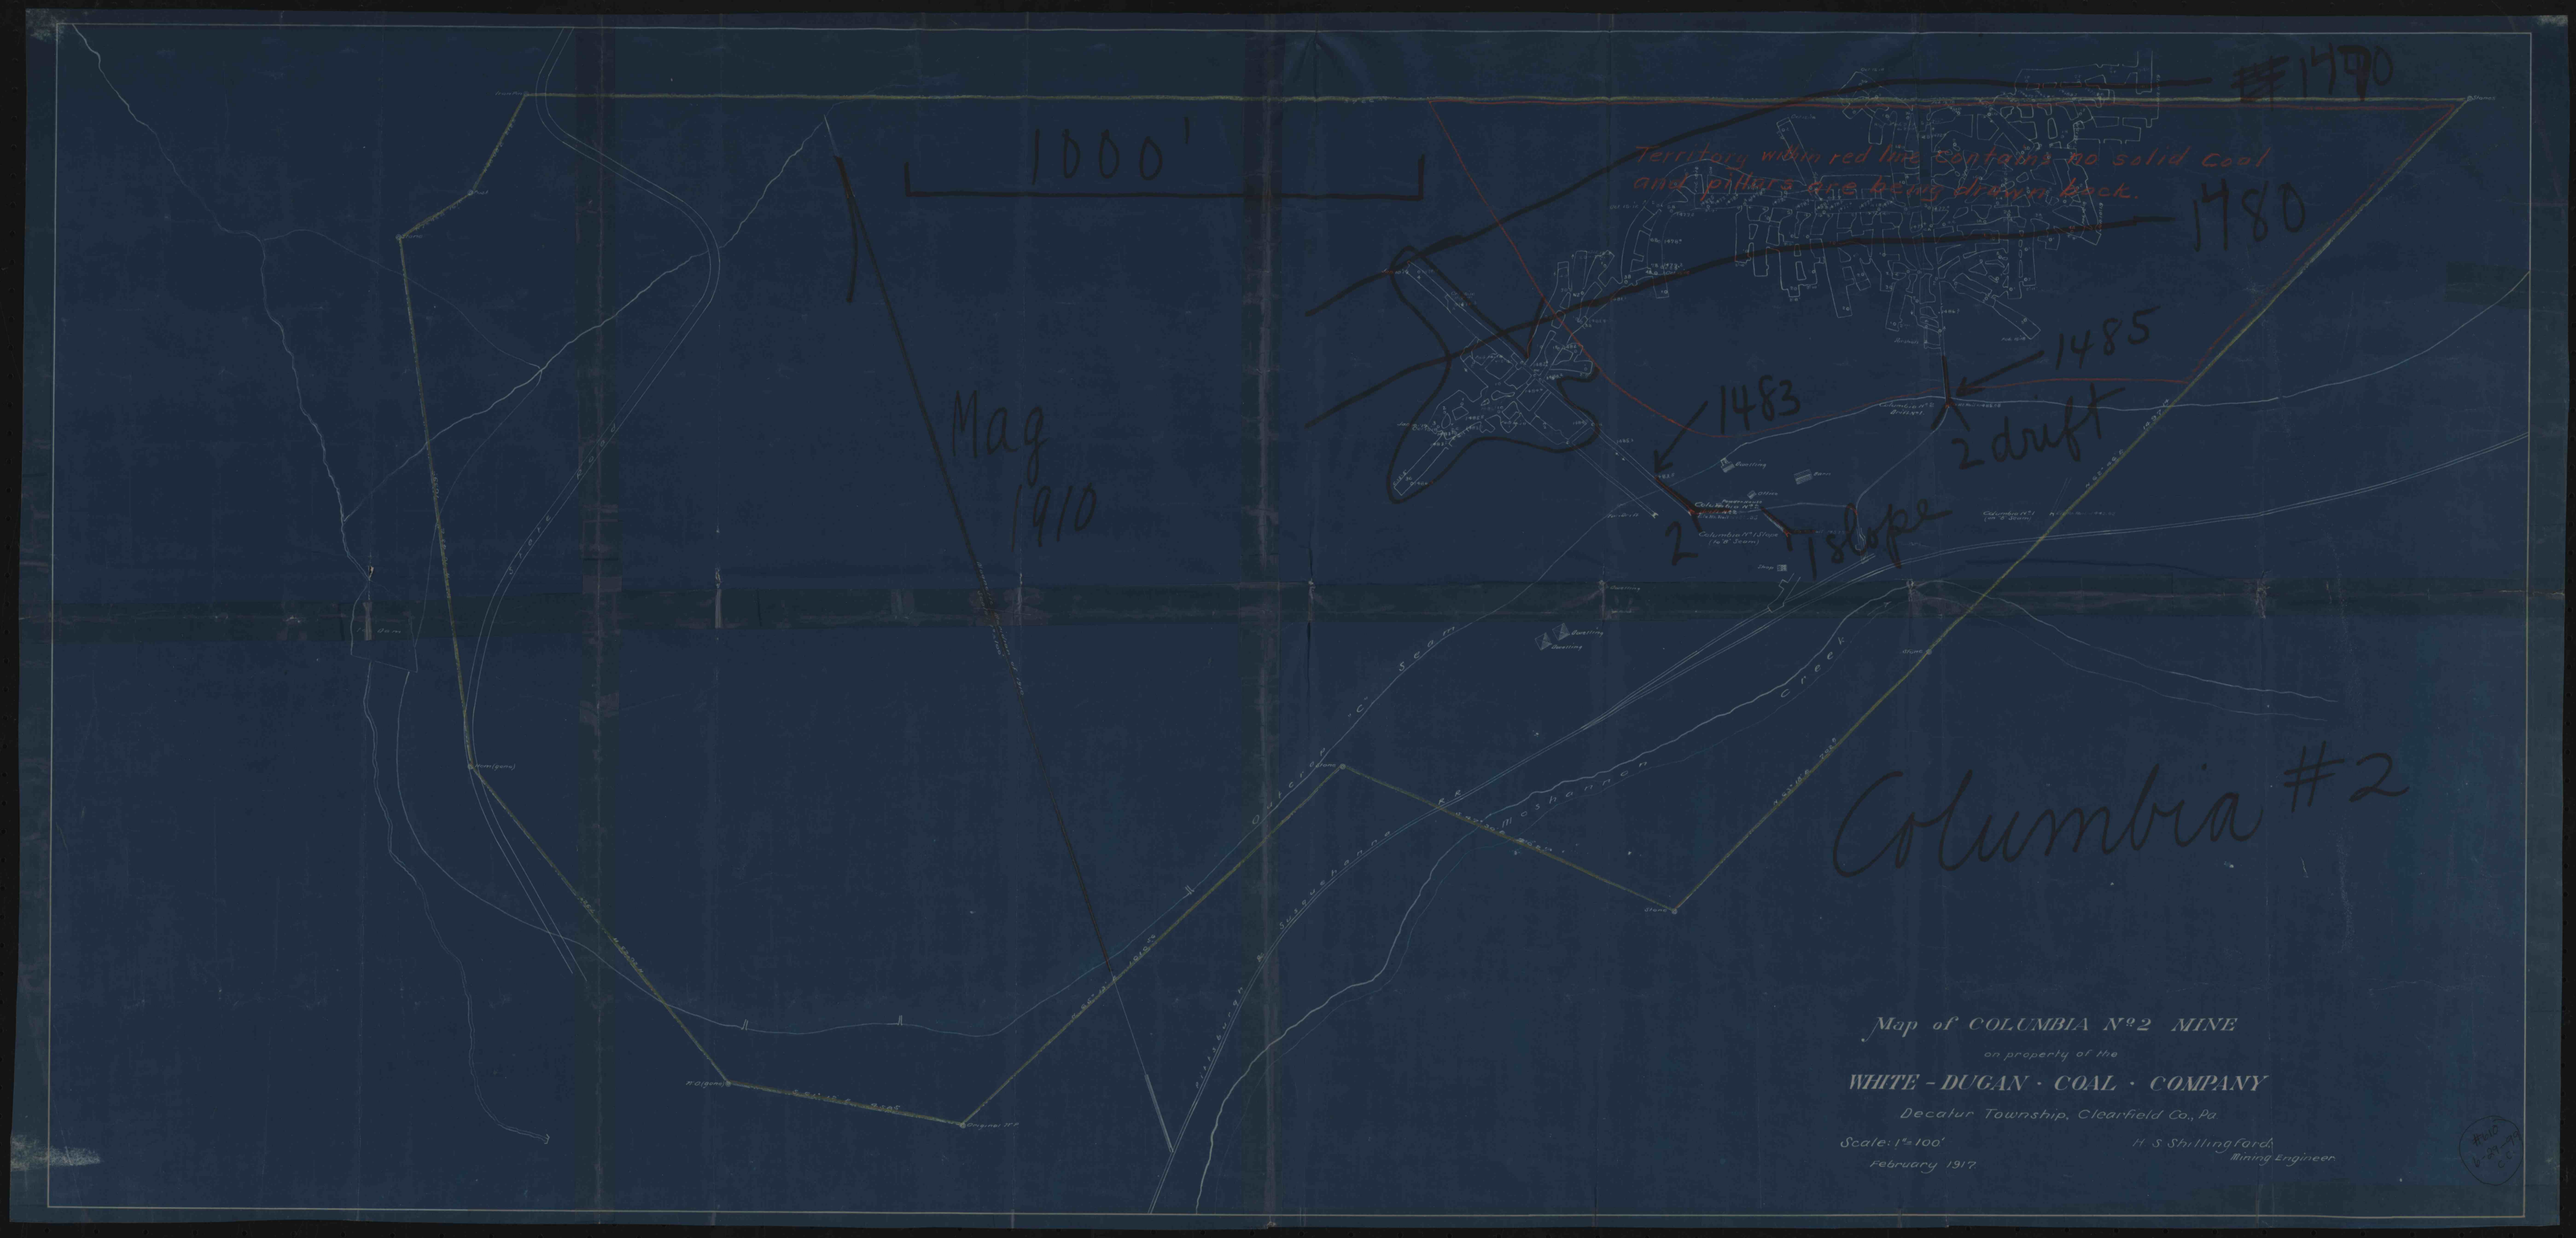

1000'
Mag
1910
Territory within red line contains no solid coal
and pillars are being drawn back.
1490
1480
1485
1483
2 drift
2
1 slope
Columbia #2
Map of COLUMBIA No 2 MINE
on property of the
WHITE - DUGAN · COAL · COMPANY
Decatur Township, Clearfield Co., Pa.
Scale: 1" = 100'
February 1917
H. S. Shillingford,
Mining Engineer