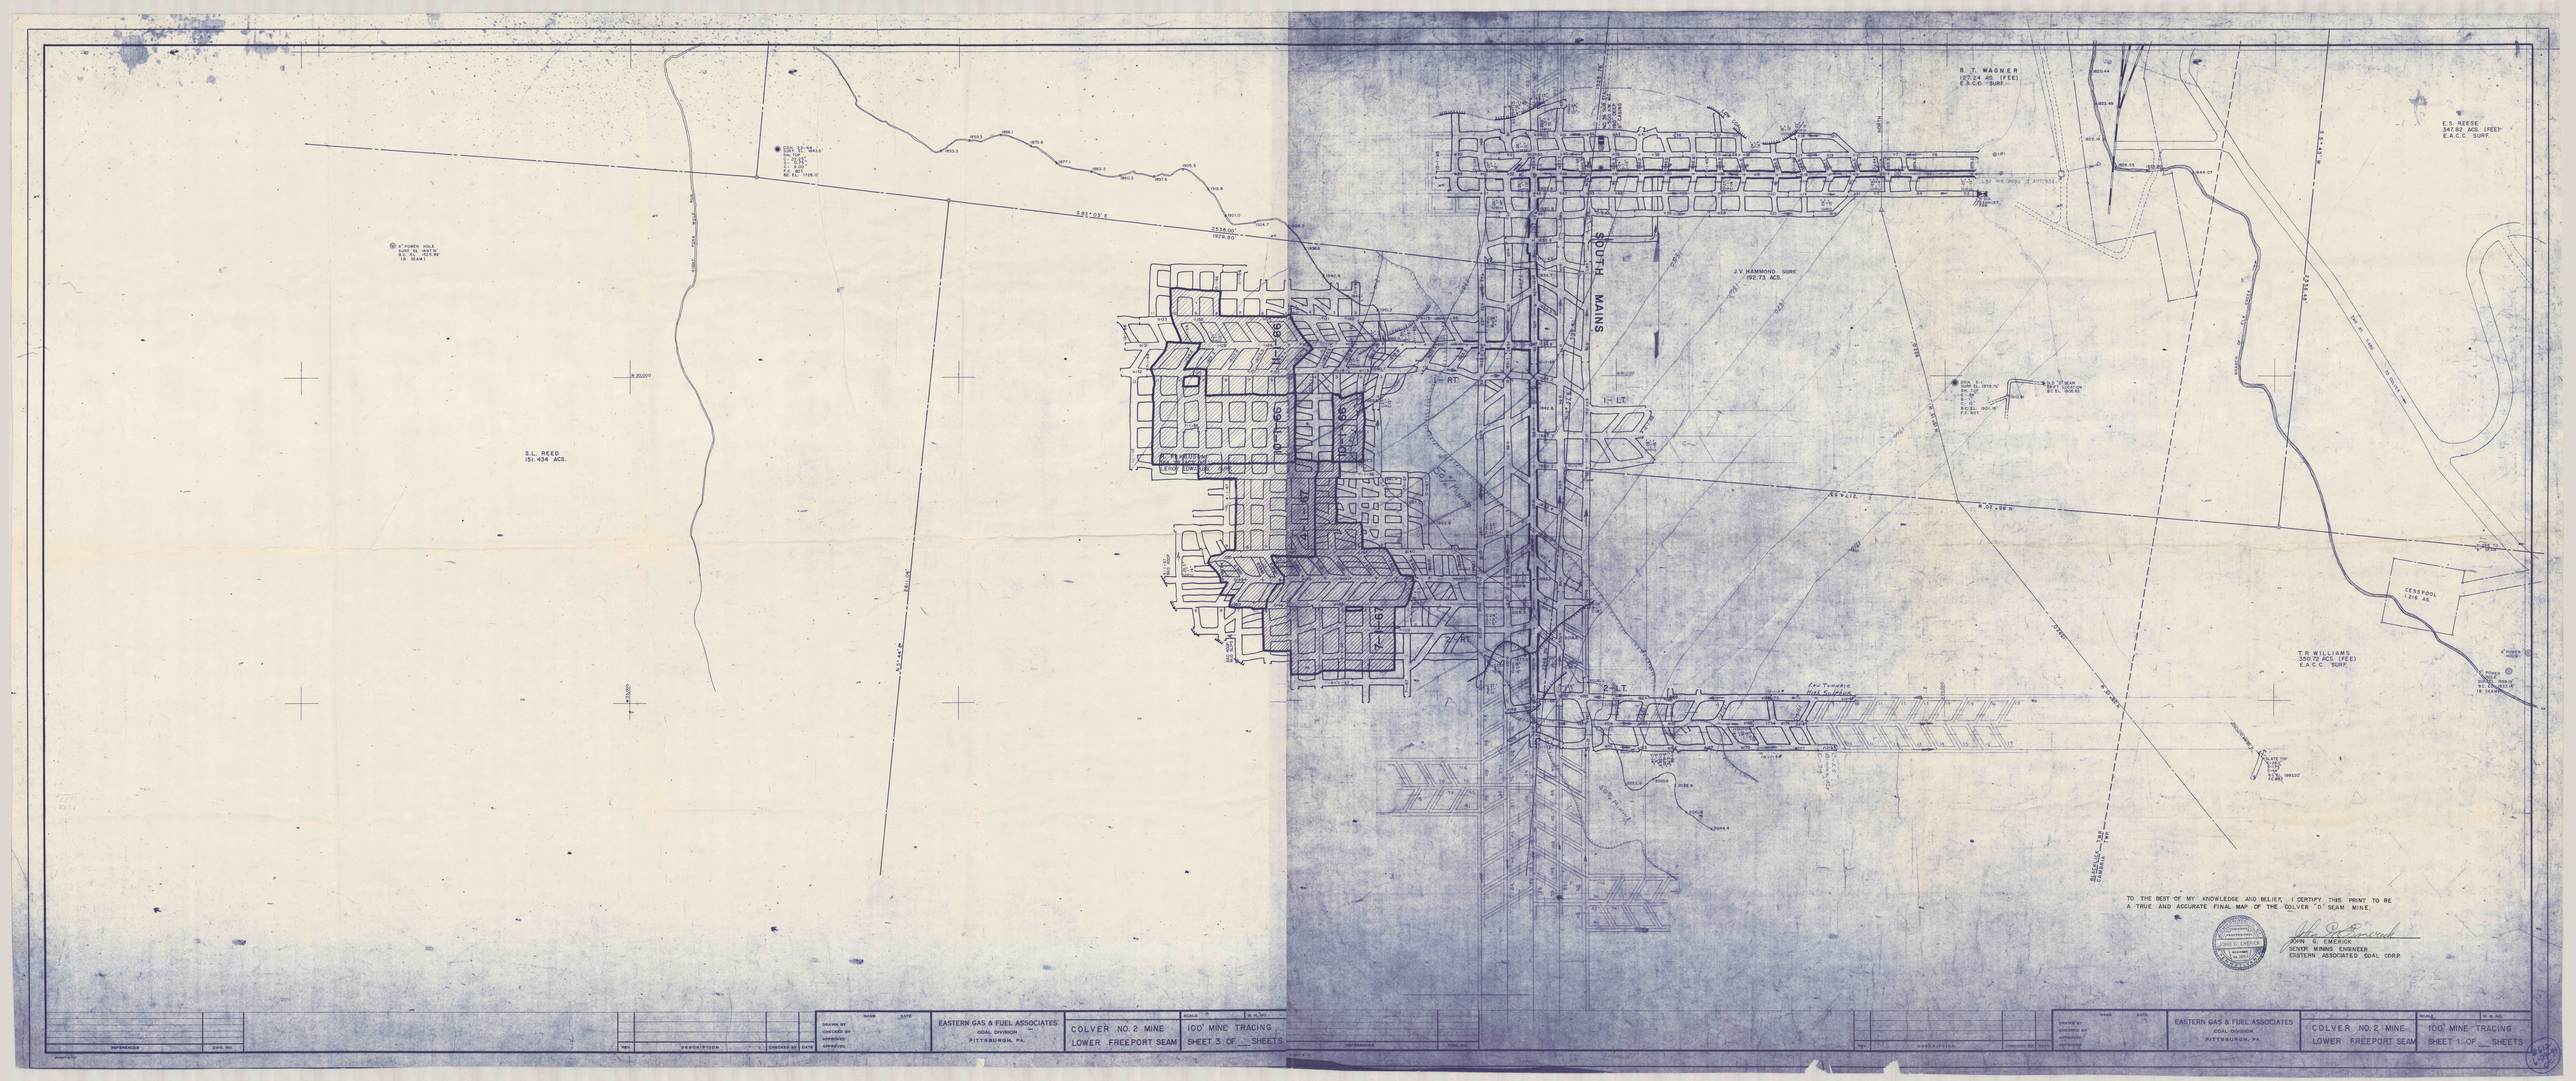
S.L. REED
151.434 ACS.
J.V. HAMMOND SURF.
192.73 ACS.
B. T. WAGNER
127.24 AS. (FEE)
E.A.C.C. SURF.
E.S. REESE
347.82 ACS. (FEE)
E.A.C.C. SURF.
T.R. WILLIAMS
350.72 ACS. (FEE)
E.A.C.C. SURF.
SOUTH MAINS
NORTH
CESSPOOL
LINE 46
TO THE BEST OF MY KNOWLEDGE AND BELIEF, I CERTIFY THIS PRINT TO BE
A TRUE AND ACCURATE FINAL MAP OF THE COLVER "D" SEAM MINE.
JOHN G. EMERICK
SENIOR MINING ENGINEER
EASTERN ASSOCIATED COAL CORP.
EASTERN GAS & FUEL ASSOCIATES
COAL DIVISION
PITTSBURGH, PA.
COLVER NO. 2 MINE
LOWER FREEPORT SEAM
100' MINE TRACING
SHEET 3 OF __ SHEETS
EASTERN GAS & FUEL ASSOCIATES
COAL DIVISION
PITTSBURGH, PA.
COLVER NO. 2 MINE
LOWER FREEPORT SEAM
100' MINE TRACING
SHEET 1 OF __ SHEETS