


#687
b-29
CC.

CONEMAUGH VALLEY LIME & COAL CO
SHOWING
THE WORKINGS IN THE C SEAM OF COAL

SCALE 100 FT = 1 IN.

NO 2 MINE

AVERAGE HEIGHT OF SEAM 3 FT.

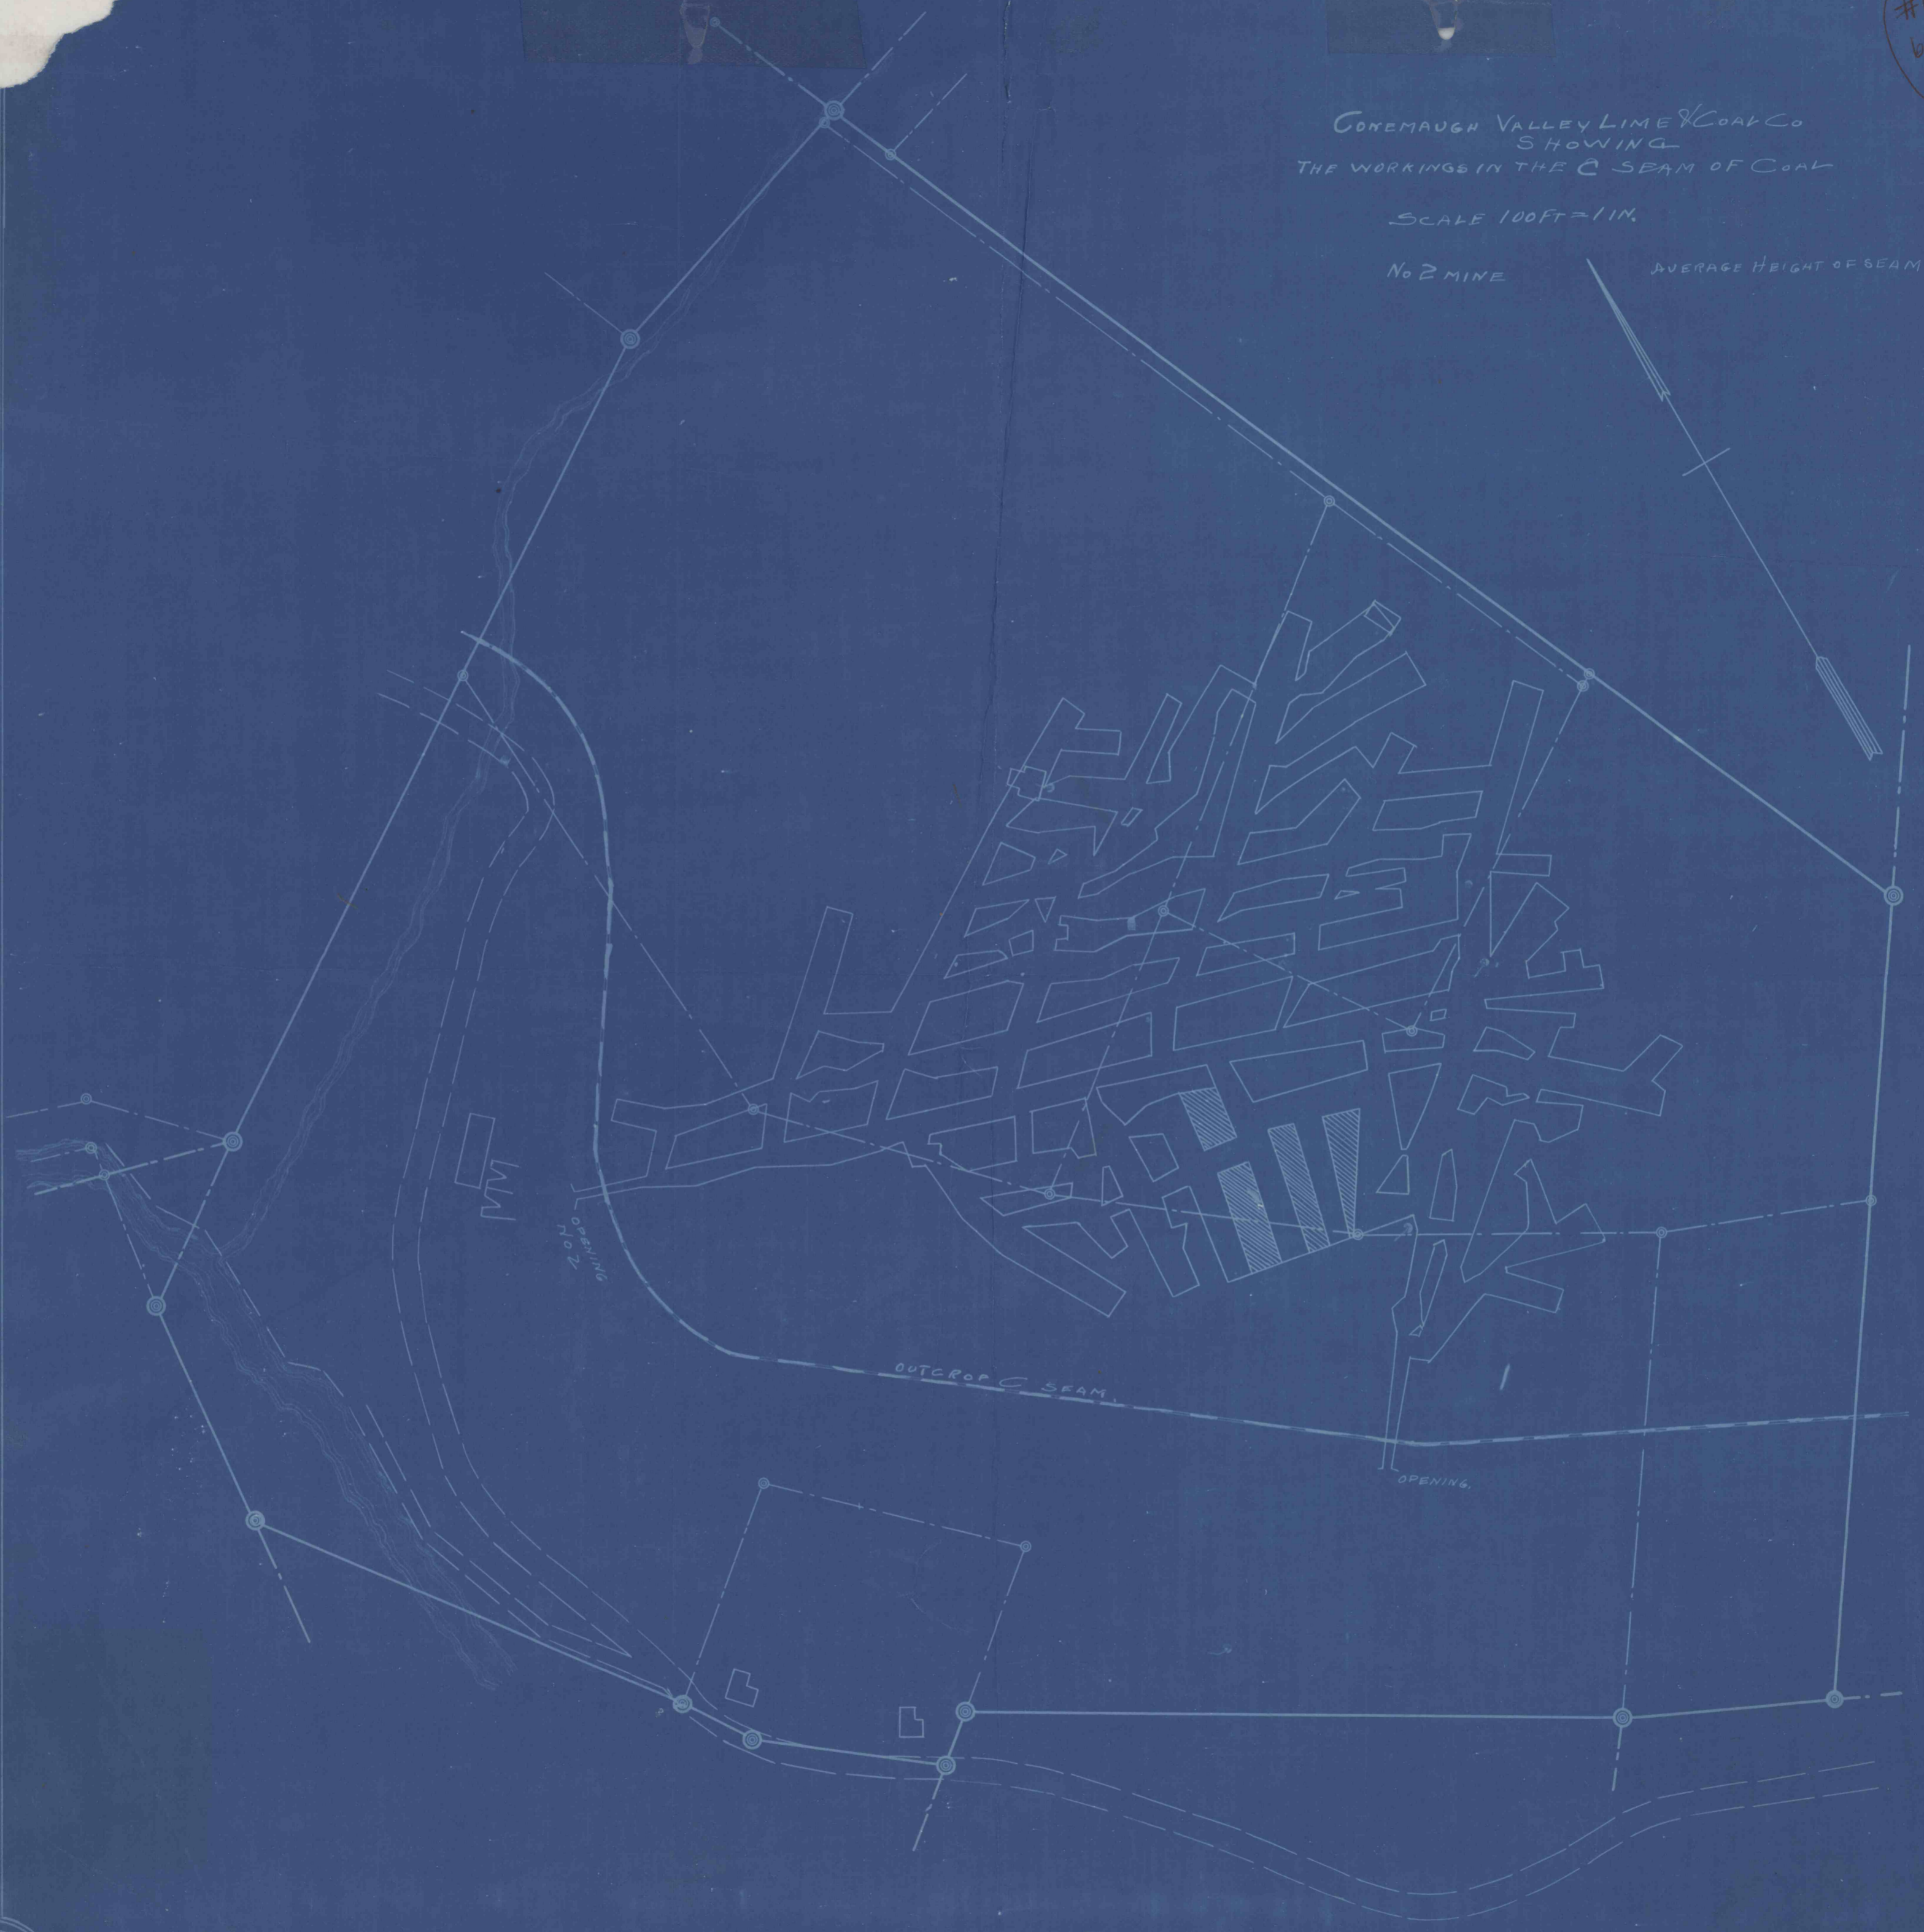

MM

20 FT
OPENING

OUTCROP C SEAM

OPENING