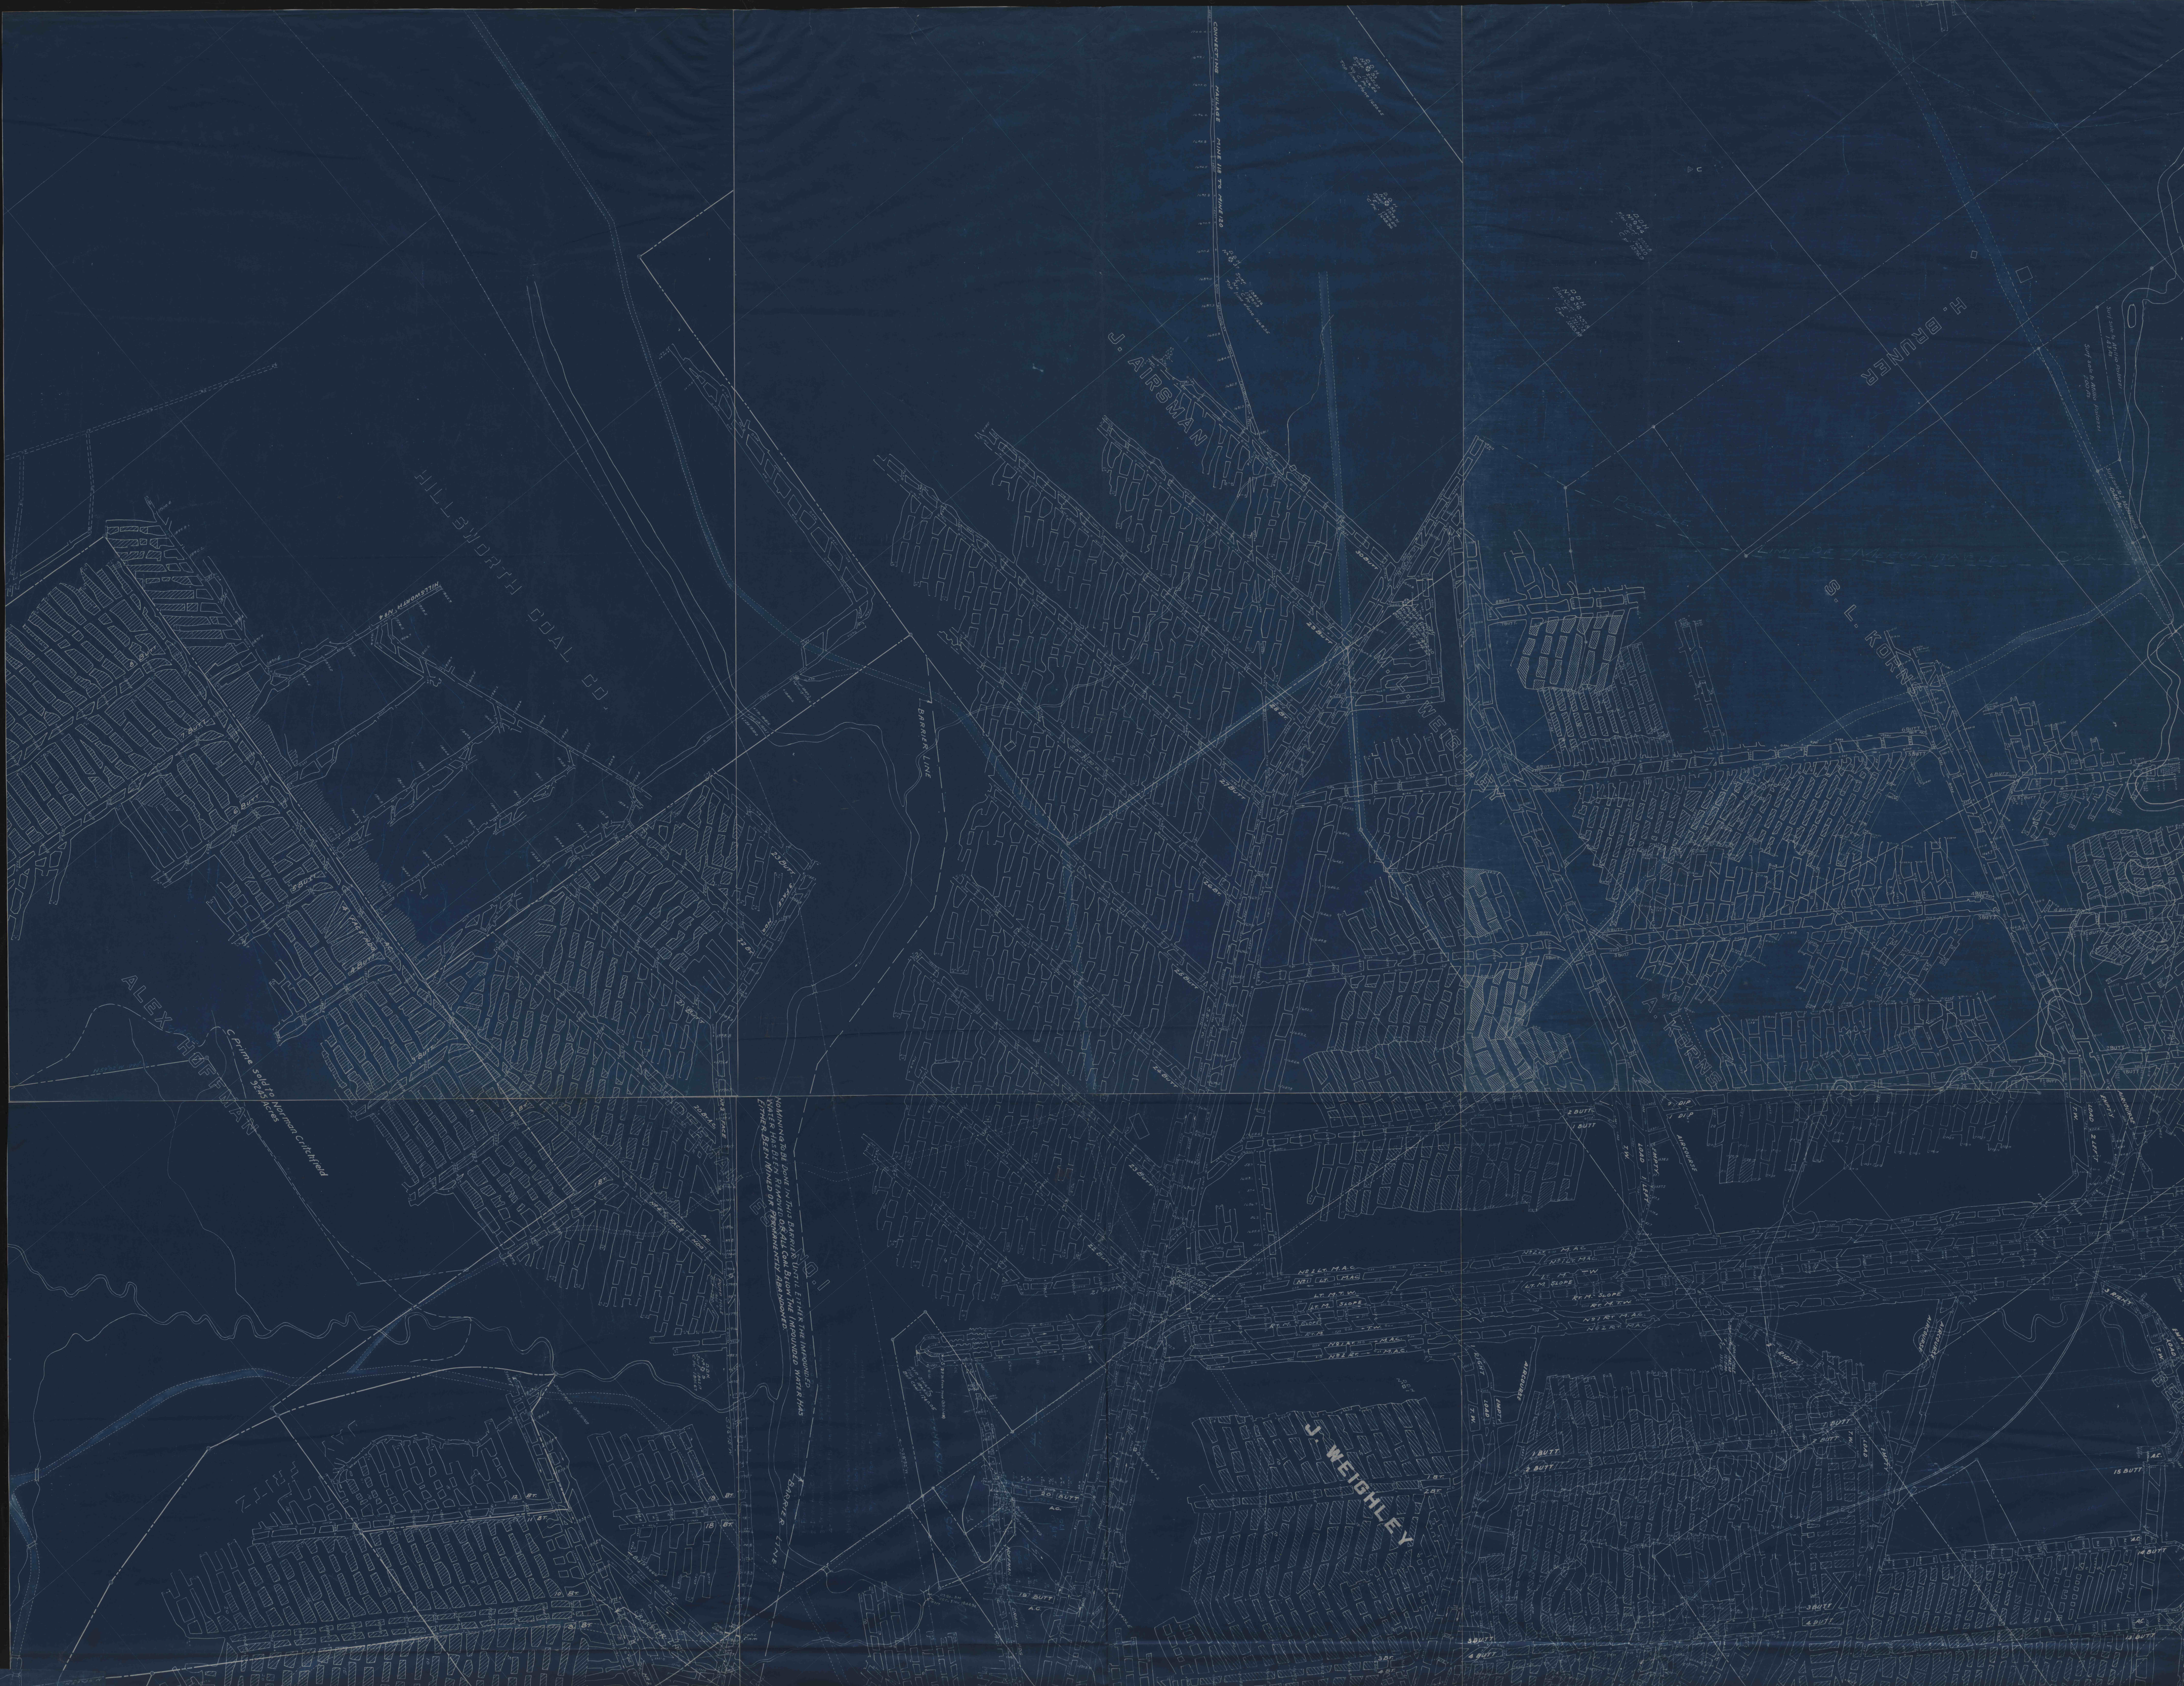
HILLSWORTH COAL CO.
HILLSWORTH NO 4
ALEX HOFFMAN
C Prime sold to Norman Critchfield 92.45 Acres
CONNECTING HAULAGE MINE 118 TO MINE 120
J. AIRSMAN
BARRIER LINE
H. BRUNER
LIMIT OF MERCHANTABLE COAL
S. L. KORNS
A. KORNS
NO MINING TO BE DONE IN THIS BARRIER UNTIL EITHER THE IMPOUNDED WATER HAS BEEN REMOVED OR ALL COAL BELOW THE IMPOUNDED WATER HAS EITHER BEEN MINED OR PERMANENTLY ABANDONED.
BARRIER LINE
J. WEIGHLEY
No 2 LT. M.AC.
No 1 LT. M.AC.
LT. M. T.W.
LT. M. SLOPE
RT. M. SLOPE
RT. M. T.W.
No 1 RT. M.AC.
No 2 RT. M.AC.
AIRCOURSE
EMPTY
LOAD
T.W.
20 BUTT
19 BUTT
15 BUTT
14 BUTT
13 BUTT