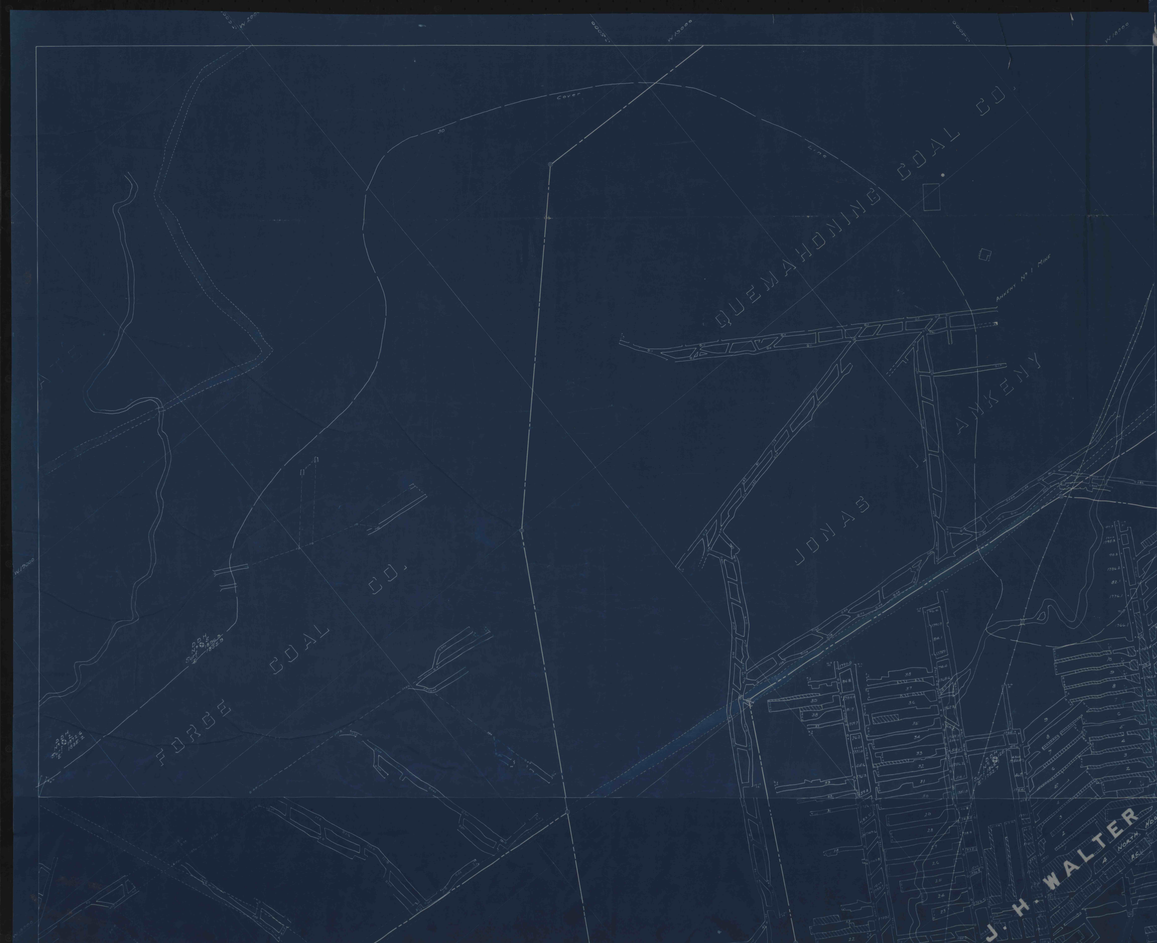
QUEMAHONING COAL CO
JONAS ANKENY
FORGE COAL CO.
J. H. WALTER
E. HEIPLE NO. 1
CHS
E. HEIPLE NO. 2
J. SACHS
C. M. ANKENY
J. G. SHULTICE

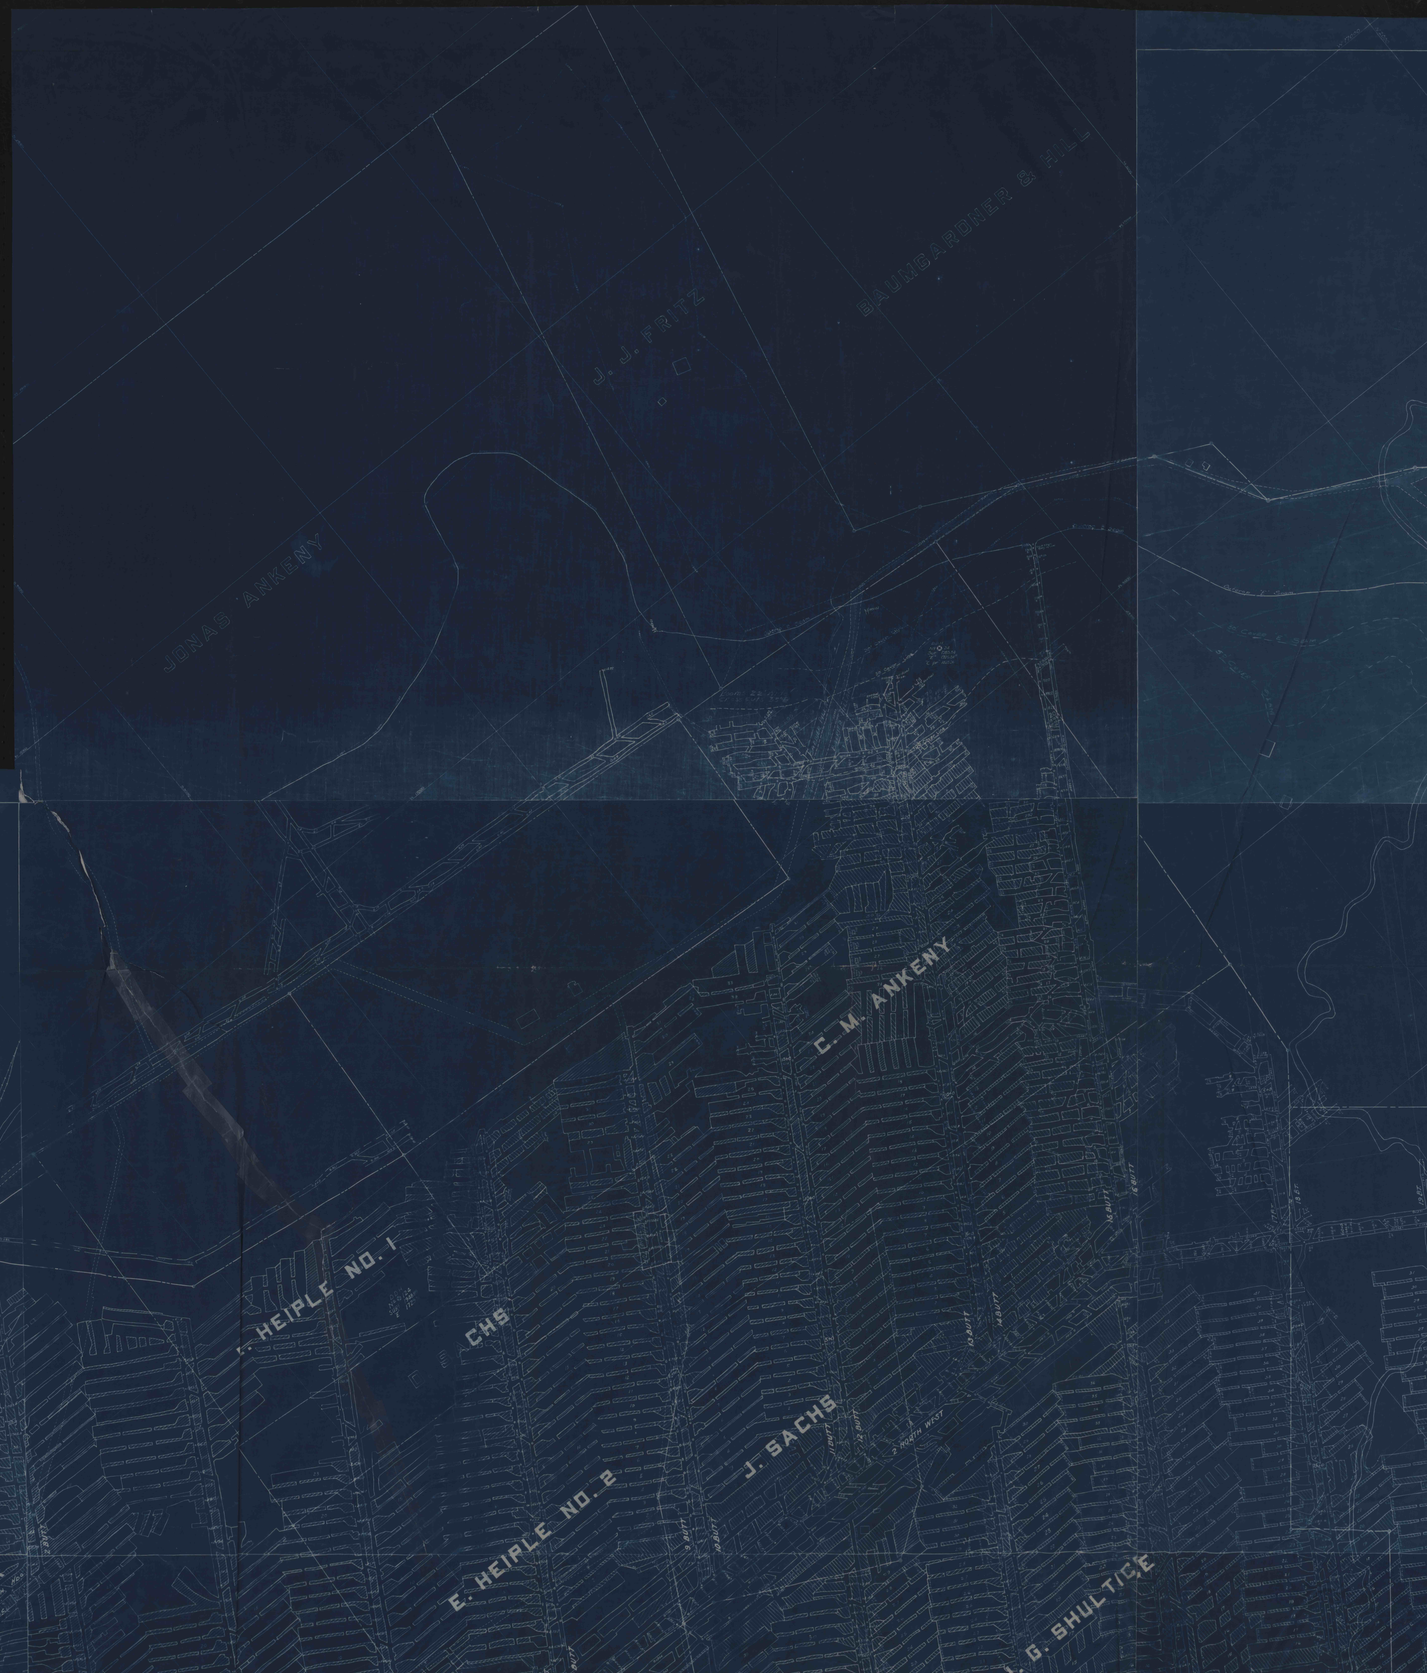
J. J. FRITZ
BAUMGARDNER & MILLS
JONAS ANKENY