

MCNEES REESE COAL CO.  
SURFACE & COAL  
CONTINENTAL CLAY PROD. CO.  
CLAY

*Proposed Headings*

BEORP SUR & COAL  
CONTINENTAL CLAY PROD. CO. CLAY

FREE BROOK

CEMETERY


EAST KITTANNING

CONTINENTAL CLAY PRODUCTS CO.  
CLAY MINE

SITUATED IN  
RAYBURN TOWNSHIP ARMSTRONG COUNTY PA.  
ADDRESS - OAK AVE KITTANNING PA.  
SCALE 1" = 100'

LEGEND

T	DEC. 1975
U	SEPT. 1974
V	SEPT. 1971
W	JAN. 1970
X	JAN. 1960
Y	APR. 1959
Z	APR. 1958
AA	DEC. 1950
AB	DEC. 1951
AC	JUNE 1952
AD	FEB. 1953

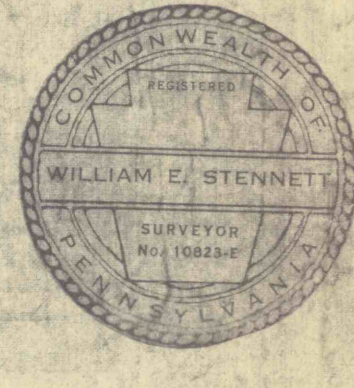

LEGEND

A	February 17, 1956	K	April, 1963
B	September, 1956	L	May, 1964
C	March, 1957	M	March, 1965
D	September, 1957	N	February, 1972
E	April, 1958	O	JANUARY 1974
F	September, 1958	P	JUNE, 1974
G	April, 1959	Q	DEC. 1974
H	April, 1960	R	JAN., 1975
I	March, 1961	S	MAY 1975
J	JUNE 1962		

*Main Headings #1 Escarpment, Escarpment Air*  
*#2 Escarpment, Air IV*

#641  
6-30-99  
C.C.