


30037B  
 REC'D. PROFESSIONAL CIVIL ENGINEER  
**ALLEN G. BUTLER**  
 Prepared by: **W.S.M.I.E.R.L.F.S.**  
 Date: **12-18-58**  
 Scale: **1"=100'**  
 County: **CENTRE**  
 Township: **SNOW SHOES**  
 Local Area: **KATO**  
 Operation: **DEEP MINE**  
**C & C COAL CO.**

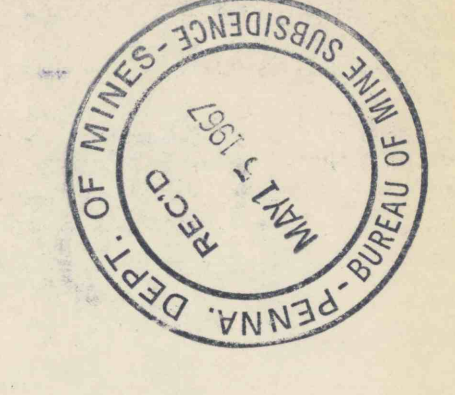

Legend:  
 Existing Highway  
 Spoil Area  
 100' Crop Barrier

Survey Dates  
 1. 7-5-56  
 2. 12-31-58  
 3. 7-25-60  
 4. 1-16-62  
 5. 10-22-63  
 6. 4-19-65  
 MINE DRAINAGE DATA  
 1. 10-24-60  
 Legend:  
 The boundaries of the area of surface land overlying the mine  
 The extent of which mining operations have been completed  
 The areas which mining operations will be conducted under this permit  
 Area to be mined in the next 6 months  
 April 15, 1957 to October 15, 1957

