

LEO NIBERT

WADE BERKPILE

A. G. HUGHMANIC

HARRY RAPACH

FRED RAPACH

FRED RAPACH

JAMES LITTLE


*I certify that this map is a true and correct copy of the original mine workings and that the workings here are made from correct surveys made by John C. Passmore Company
John C. Passmore*

COPPER VALLEY COAL COMPANY
COPPER VALLEY NO. 5 MINE
UPPER FREEPORT COAL SEAM
CHERRYHILL TOWNSHIP - INDIANA COUNTY - PENNA.
SCALE 1" = 100' CLYMER, PENNA. 15728 **SURVEY DATE _____**

CONTEMPLATED MINING _____ TO _____
 SIX MONTH EXTRACTION _____ TO _____
 REVISED ADDITIONS _____ TO _____

JOHN C. PASSMORE - SURVEYOR
Abandoned January 12, 1972 **SEAL**

Signed *John C. Passmore*

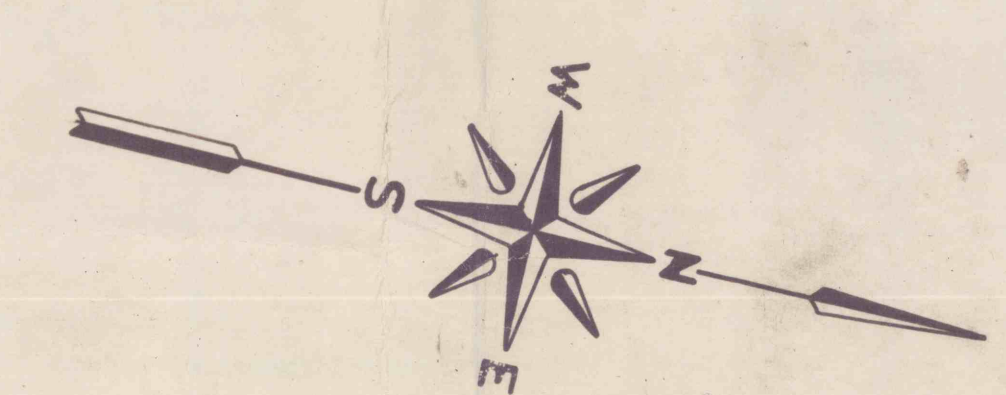

#651
6-30-77
C.S.

