




MINES ADJACENT APR. 1907
 ADJUSTED BY THEORETICAL INFORMATION
 PROVIDED BY THE COMPANY

COAL CO.
 OF

A MINE
 IN
 BUTLER CO., PA.

Prepared by
 Groves City, Pa.

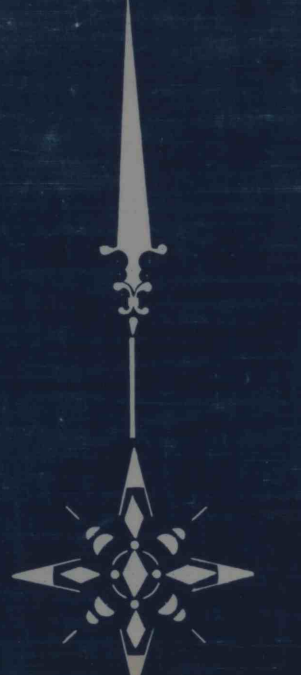

COSCOGAS COAL CO.
 MAP OF

MINE # 2

CENTER TOWNSHIP BUTLER CO. PENNA.
 SCALE 1 INCH = 100 FT.
 JUNE 1907

LEGEND

