


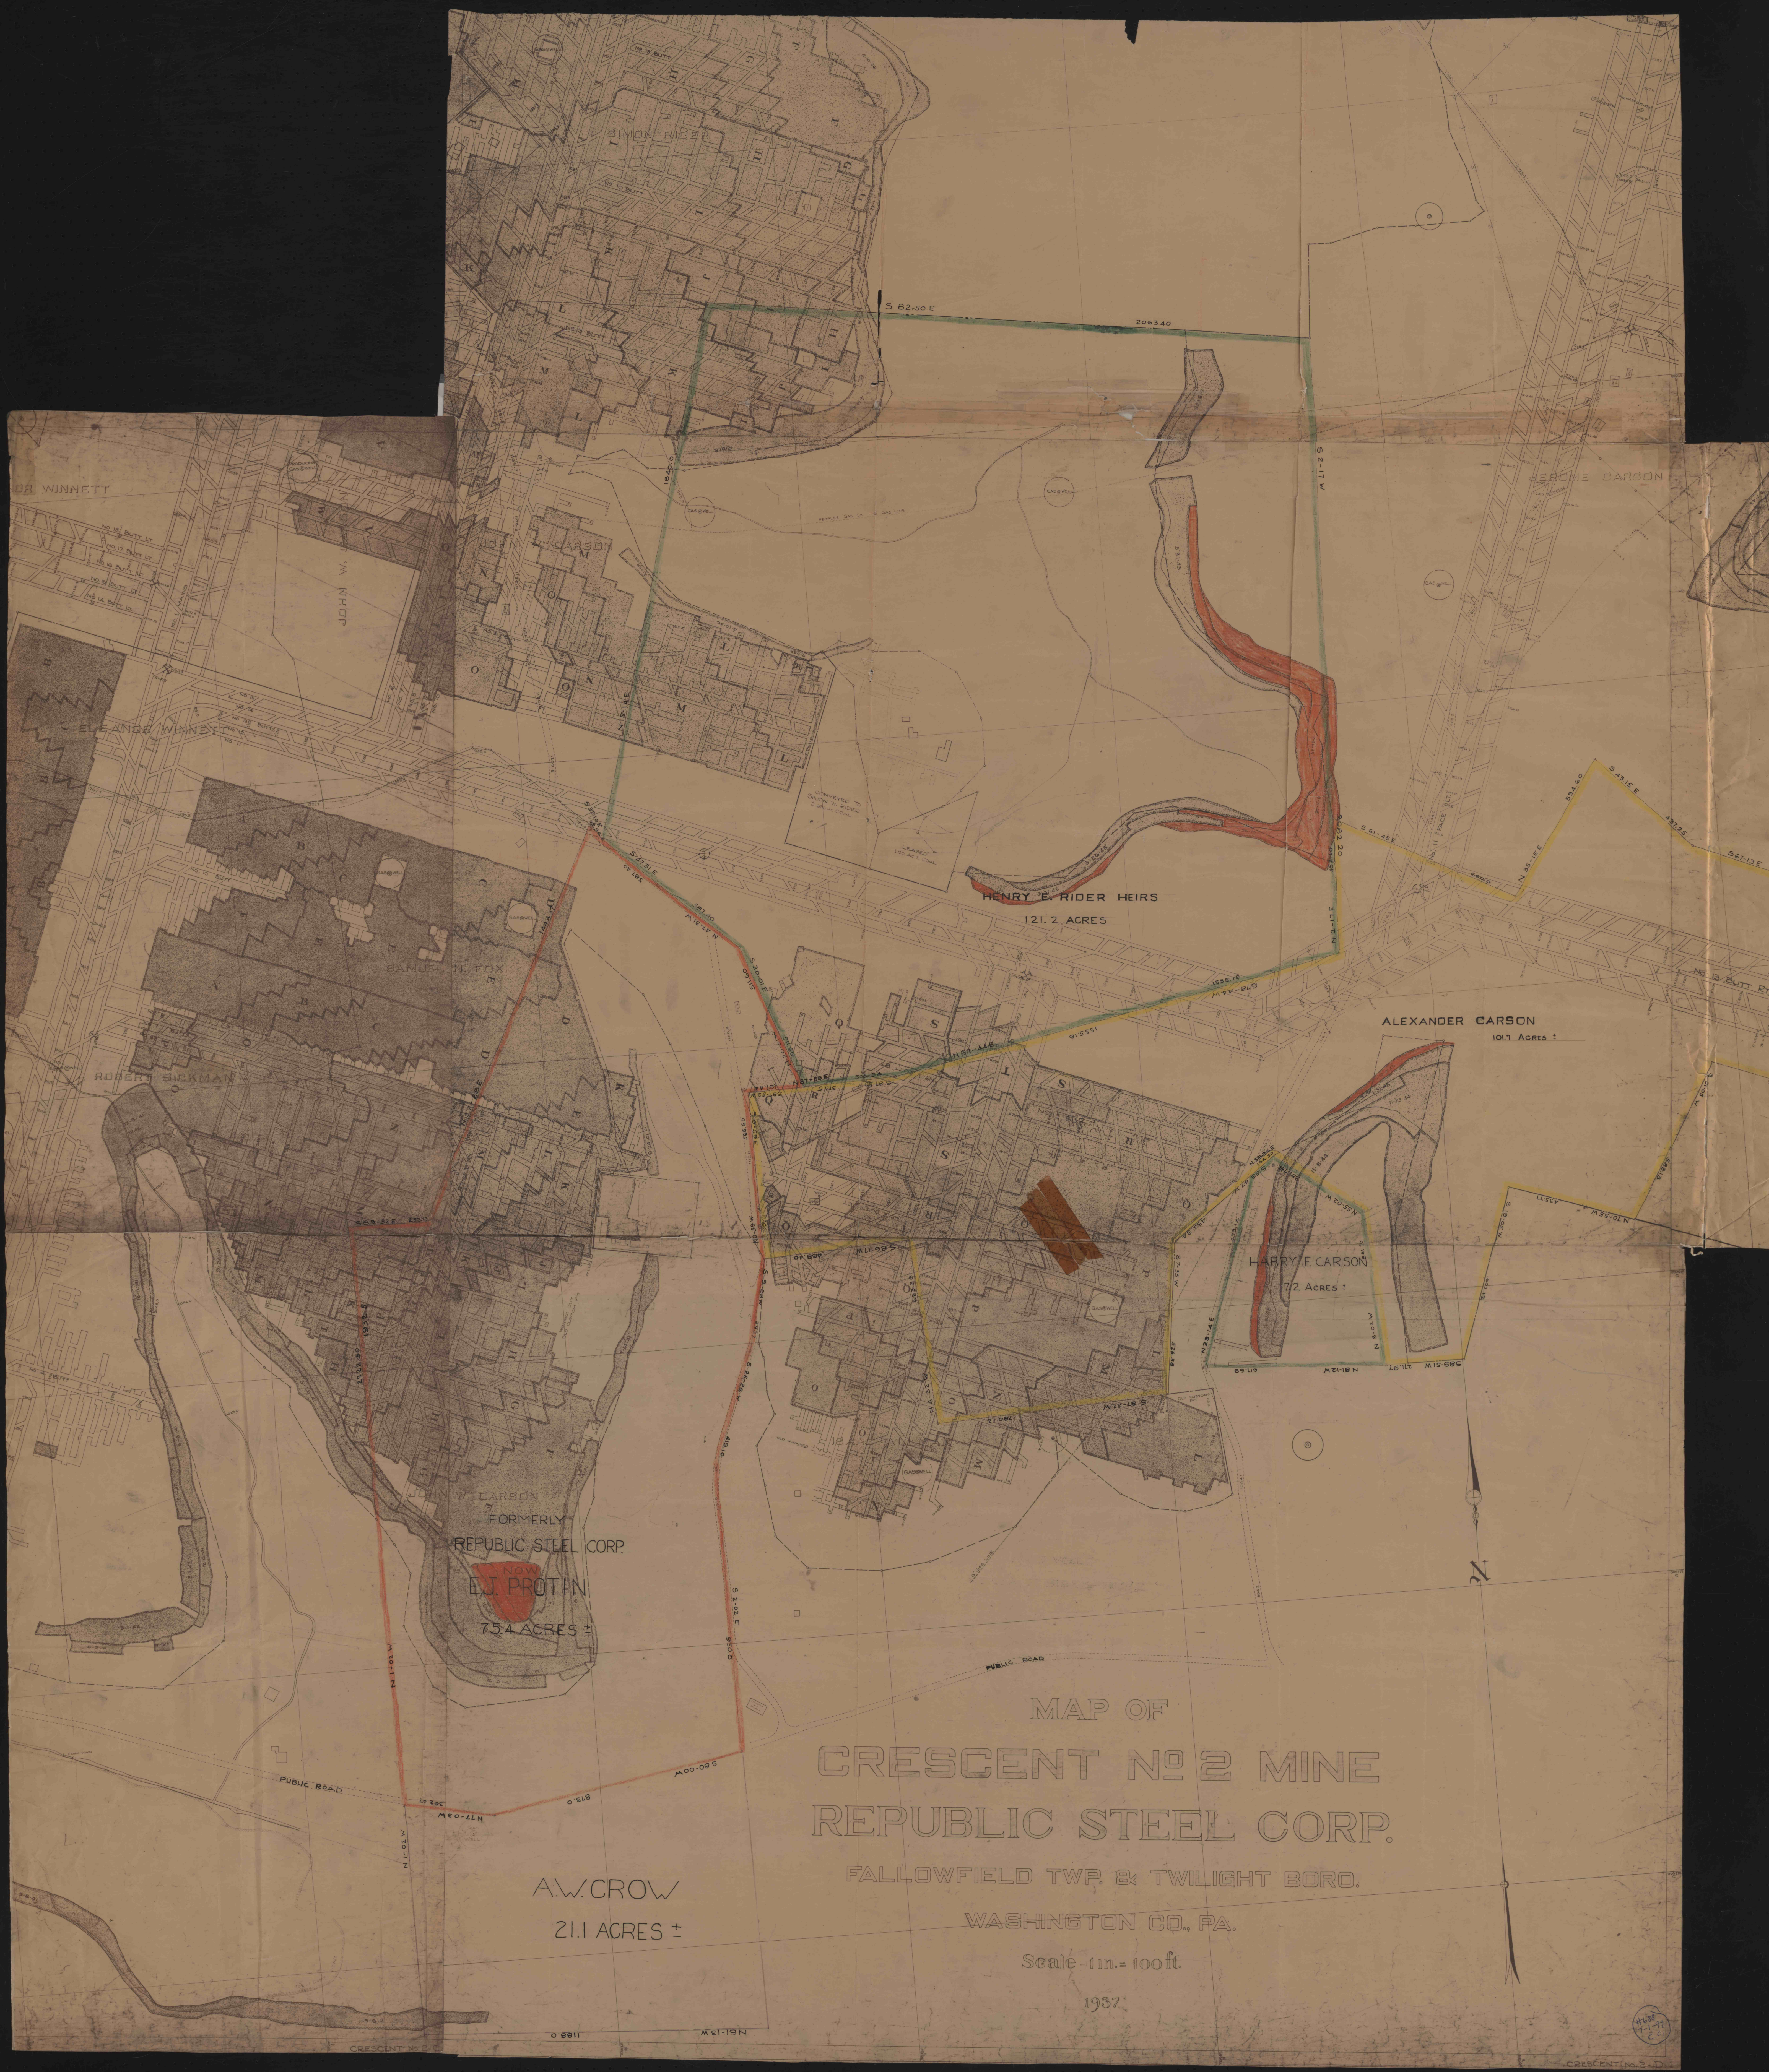

MAP OF
CRESCENT NO. 2 MINE
REPUBLIC STEEL CORP.

FALLOWFIELD TWP. & TWILIGHT BORO.

WASHINGTON CO., PA.

Scale - 1 in. = 100 ft.

1937

A.W. CROW
21.1 ACRES ±

JOHN W. CARSON
FORMERLY
REPUBLIC STEEL CORP.
75.4 ACRES ±

HENRY E. RIDER HEIRS
121.2 ACRES

ALEXANDER CARSON
101.1 ACRES ±

HARRY E. CARSON
72 ACRES ±