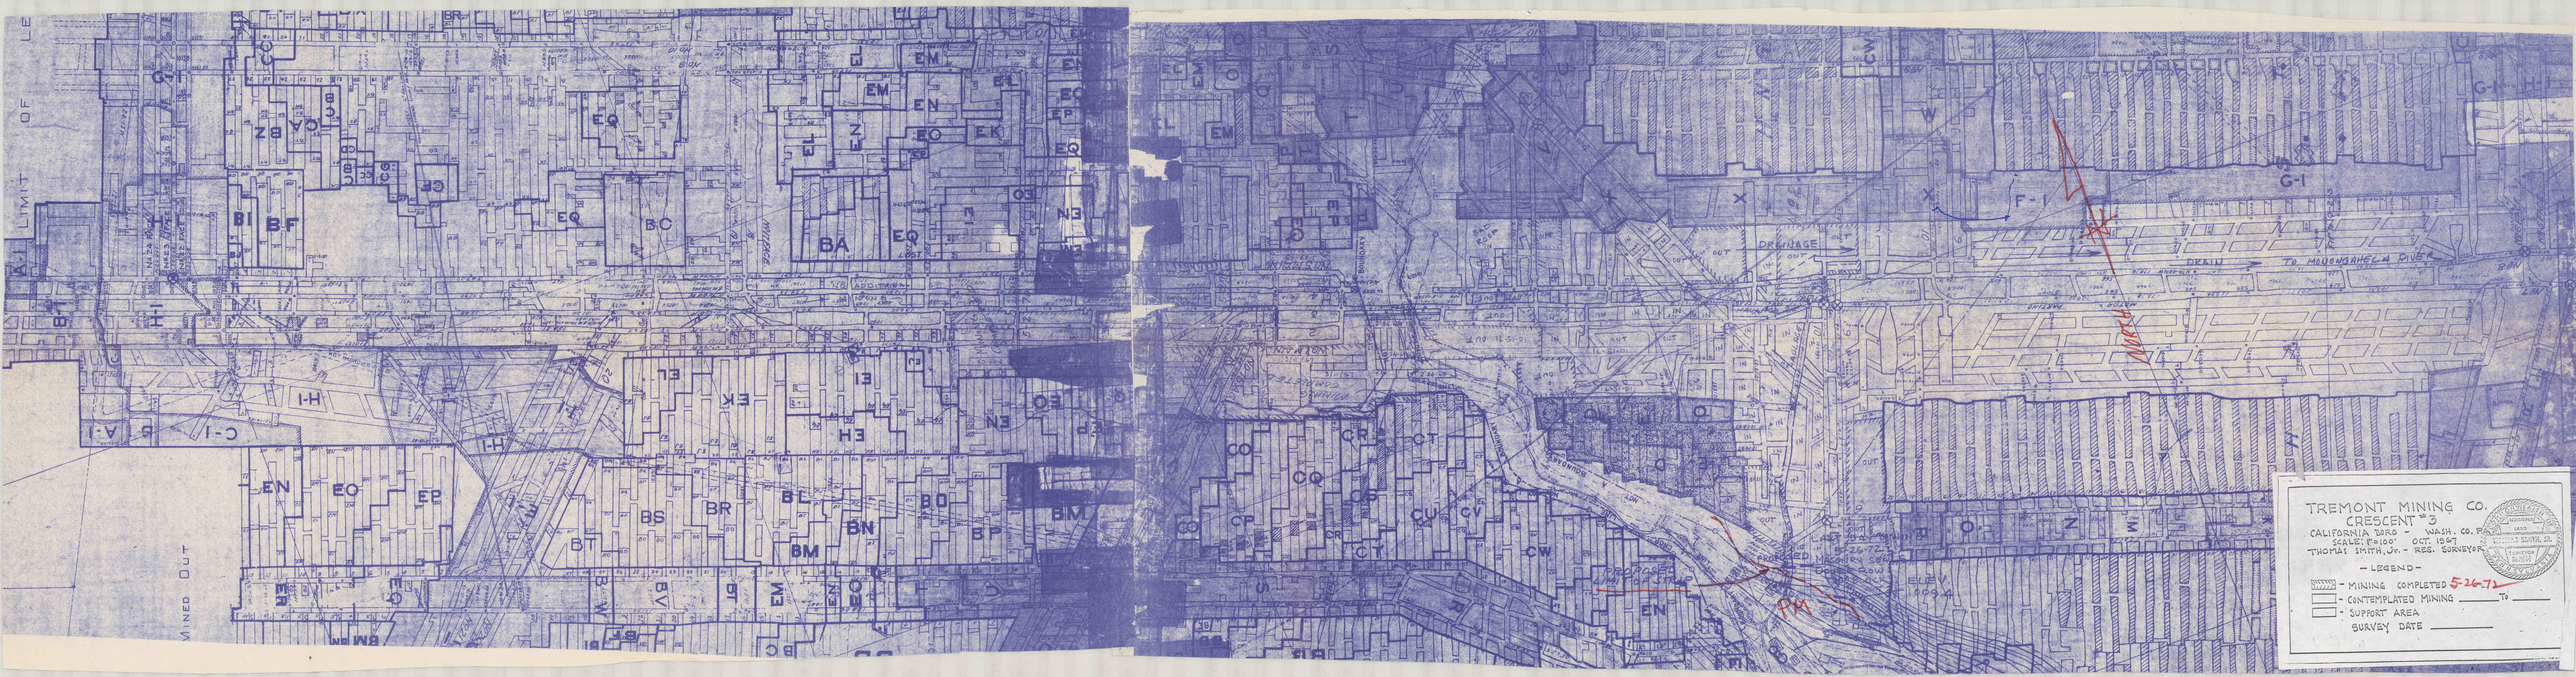
TREMONT MINING CO.
CRESCENT #3
CALIFORNIA 30RD - WASH. CO. PA.
SCALE: 1"=100' OCT. 1947
THOMAS SMITH, JR. - REG. SURVEYOR
- LEGEND -
- MINING COMPLETED 5-26-72
- CONTEMPLATED MINING ____ TO ____
- SUPPORT AREA
SURVEY DATE ____
DRAINAGE
DRAIN TO MONONGAHELA RIVER
PROPOSED HIGHWAY
ELEV. 1094.4
MINED OUT
LIMIT OF LE