


NOTE:
 I CERTIFY THAT THIS IS A TRUE AND CORRECT COPY OF ALL EXCAVATIONS MADE
 IN THE 'D' SEAM MINE OF THE CROSS ROAD COAL COMPANY.
 Edmund W. Carlson
 GUNNARD W. CARLSON
 R.S. 5816E

NOTE:
 12' CONC. BLOCK MINE SEAL 30\"/>

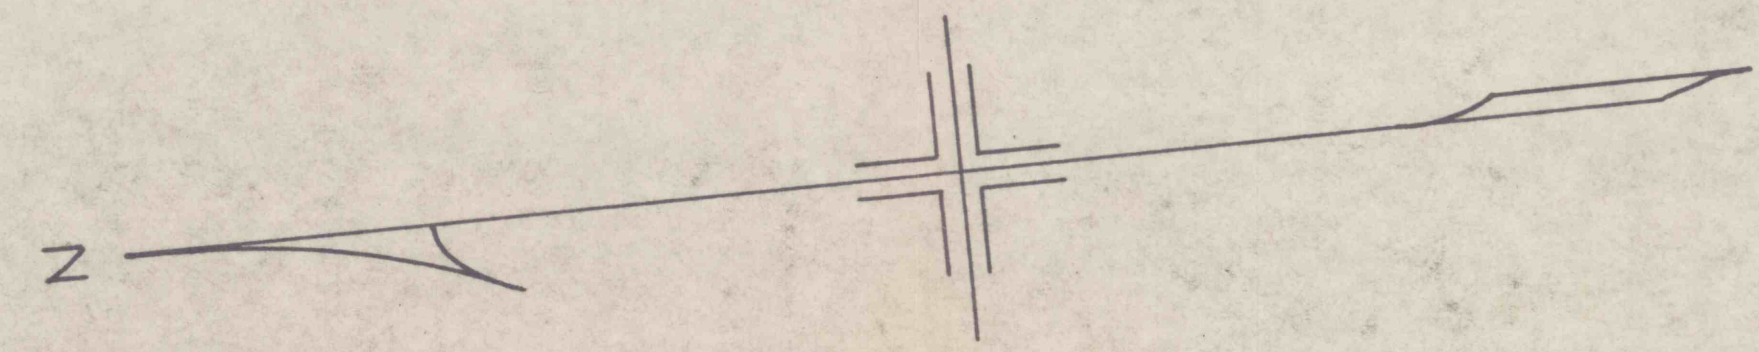

MAP SHOWING 'D' SEAM MINE
 OPERATED BY CROSS ROAD COAL COMPANY INC.
 BECCARIA TWP. CLEARFIELD COUNTY PENNA.
 SCALE 1/2\"/>

#699
 7-2-99
 CC