


Map Showing Deep Mine Under Highway Operated By Ken. Crottsley In Todd Twp. Huntingdon County Pennsylvania 1961-July 1"=100' E. Corrie Engr.

Wm. Greenland
Ken. Crottsley

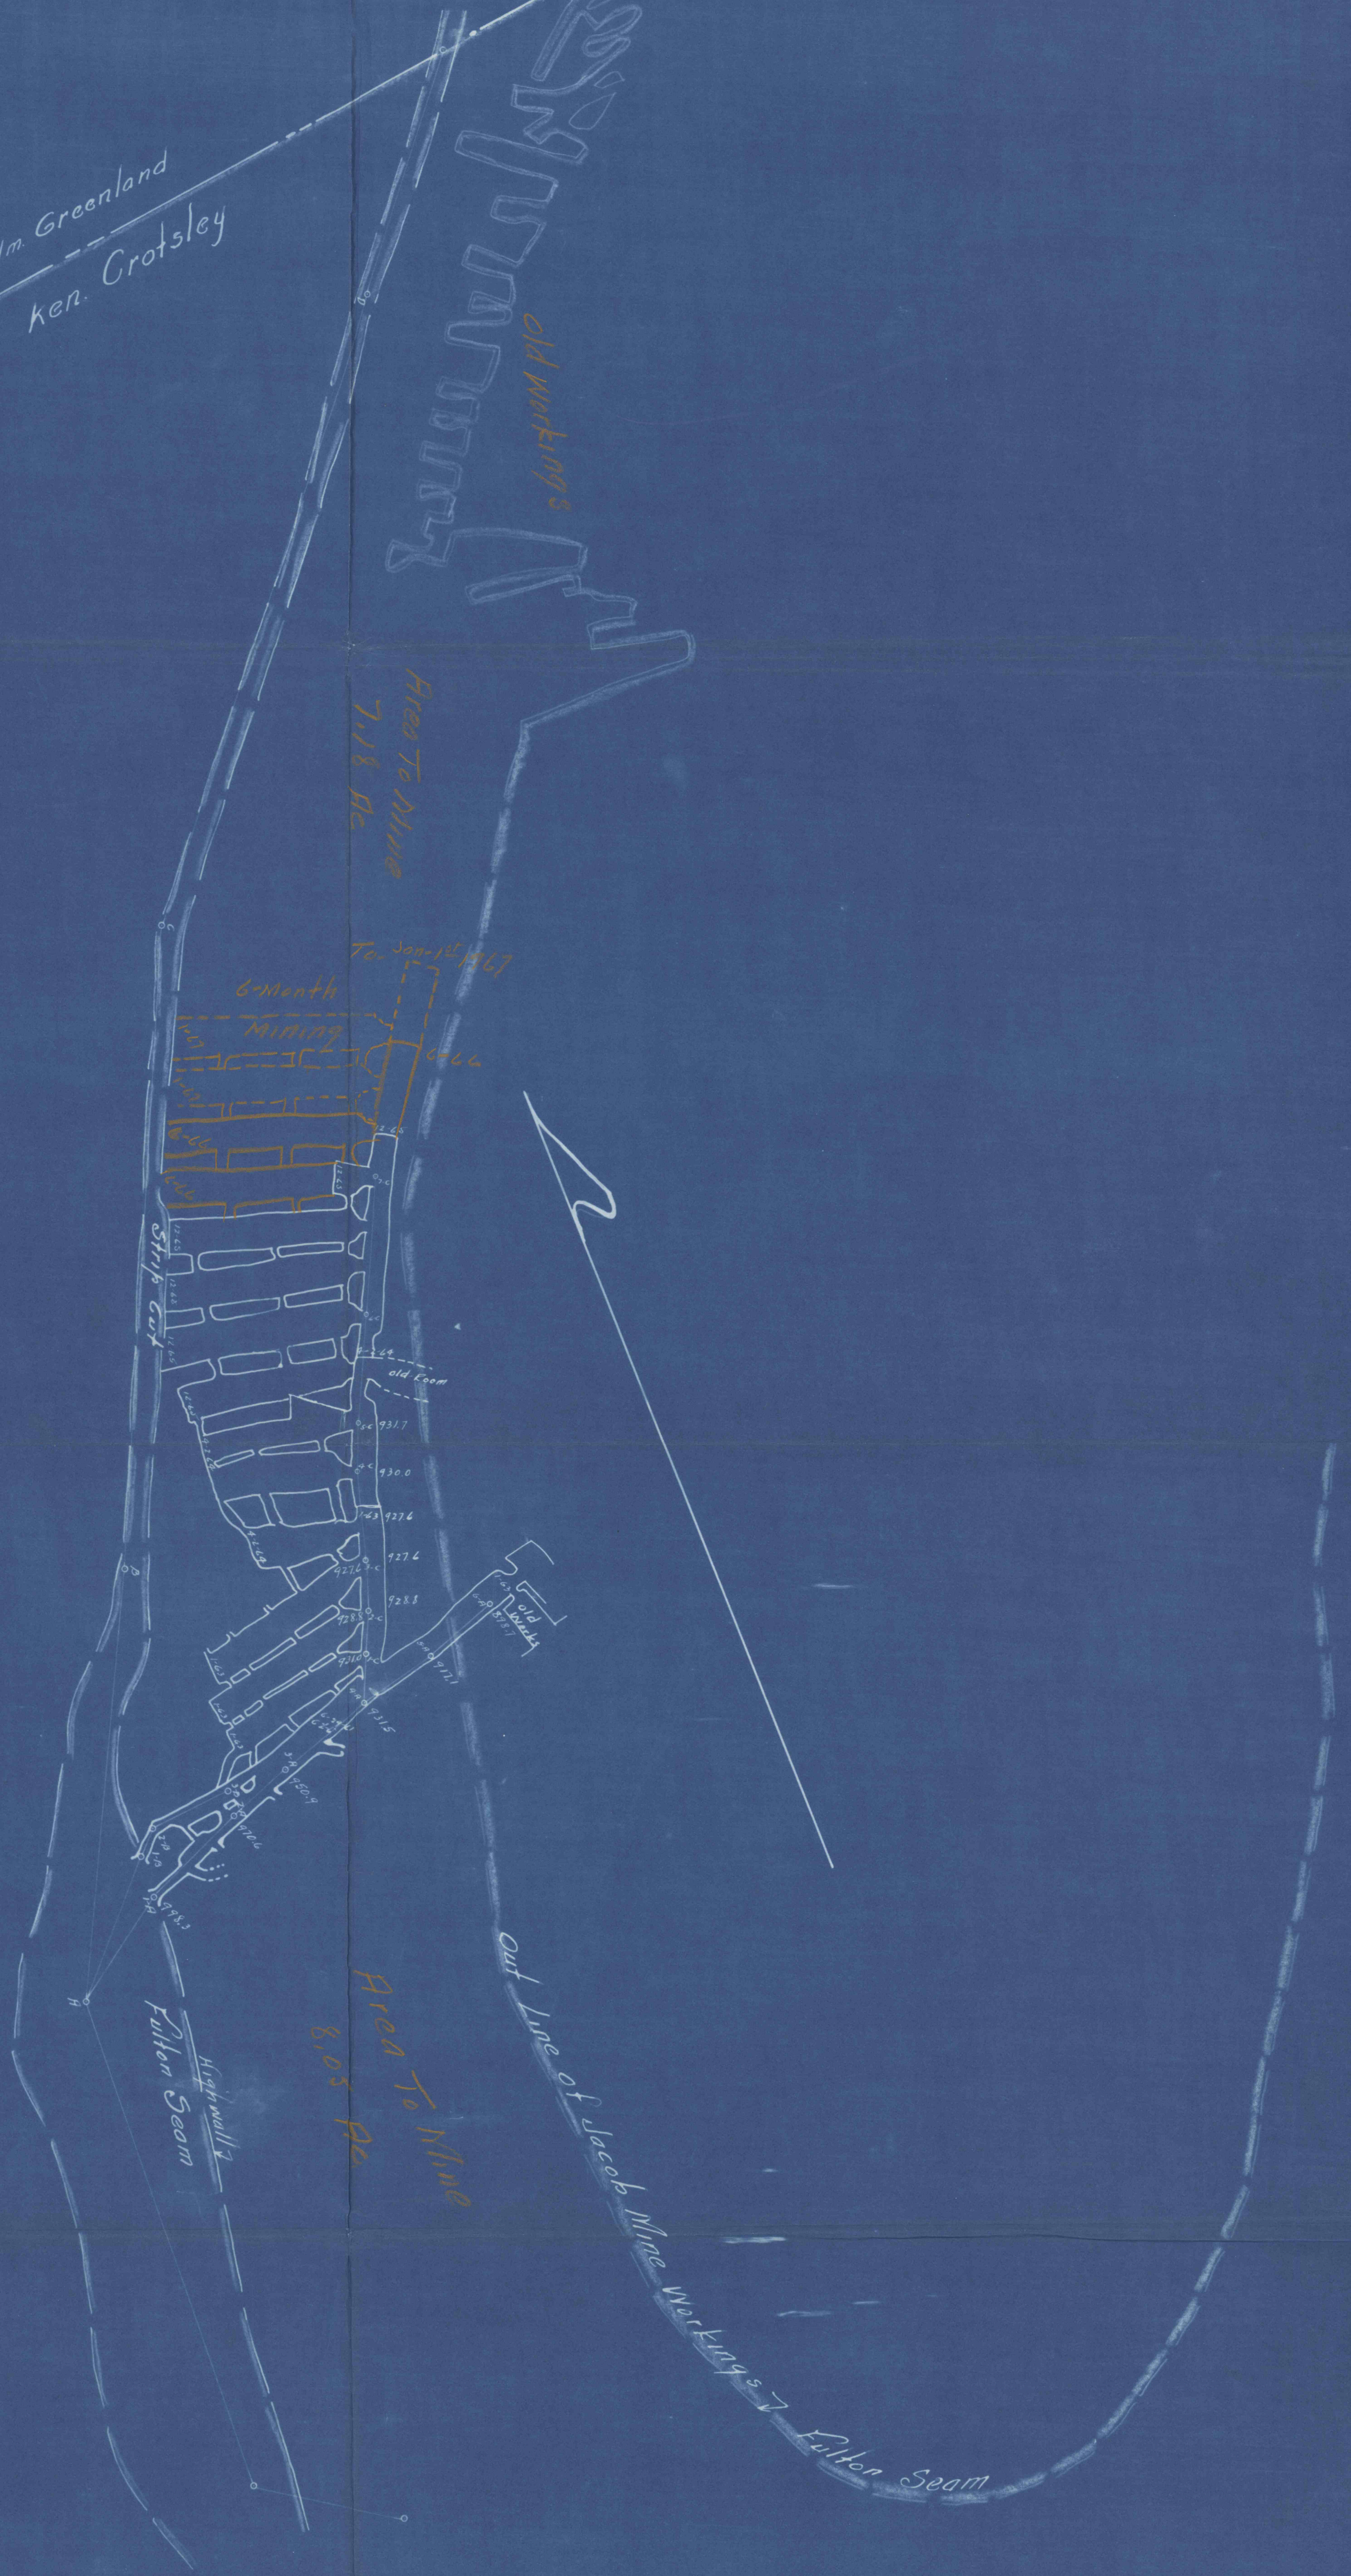

Mined To July 31-1961
Proposed To Be Mined July To Jan-1-1967