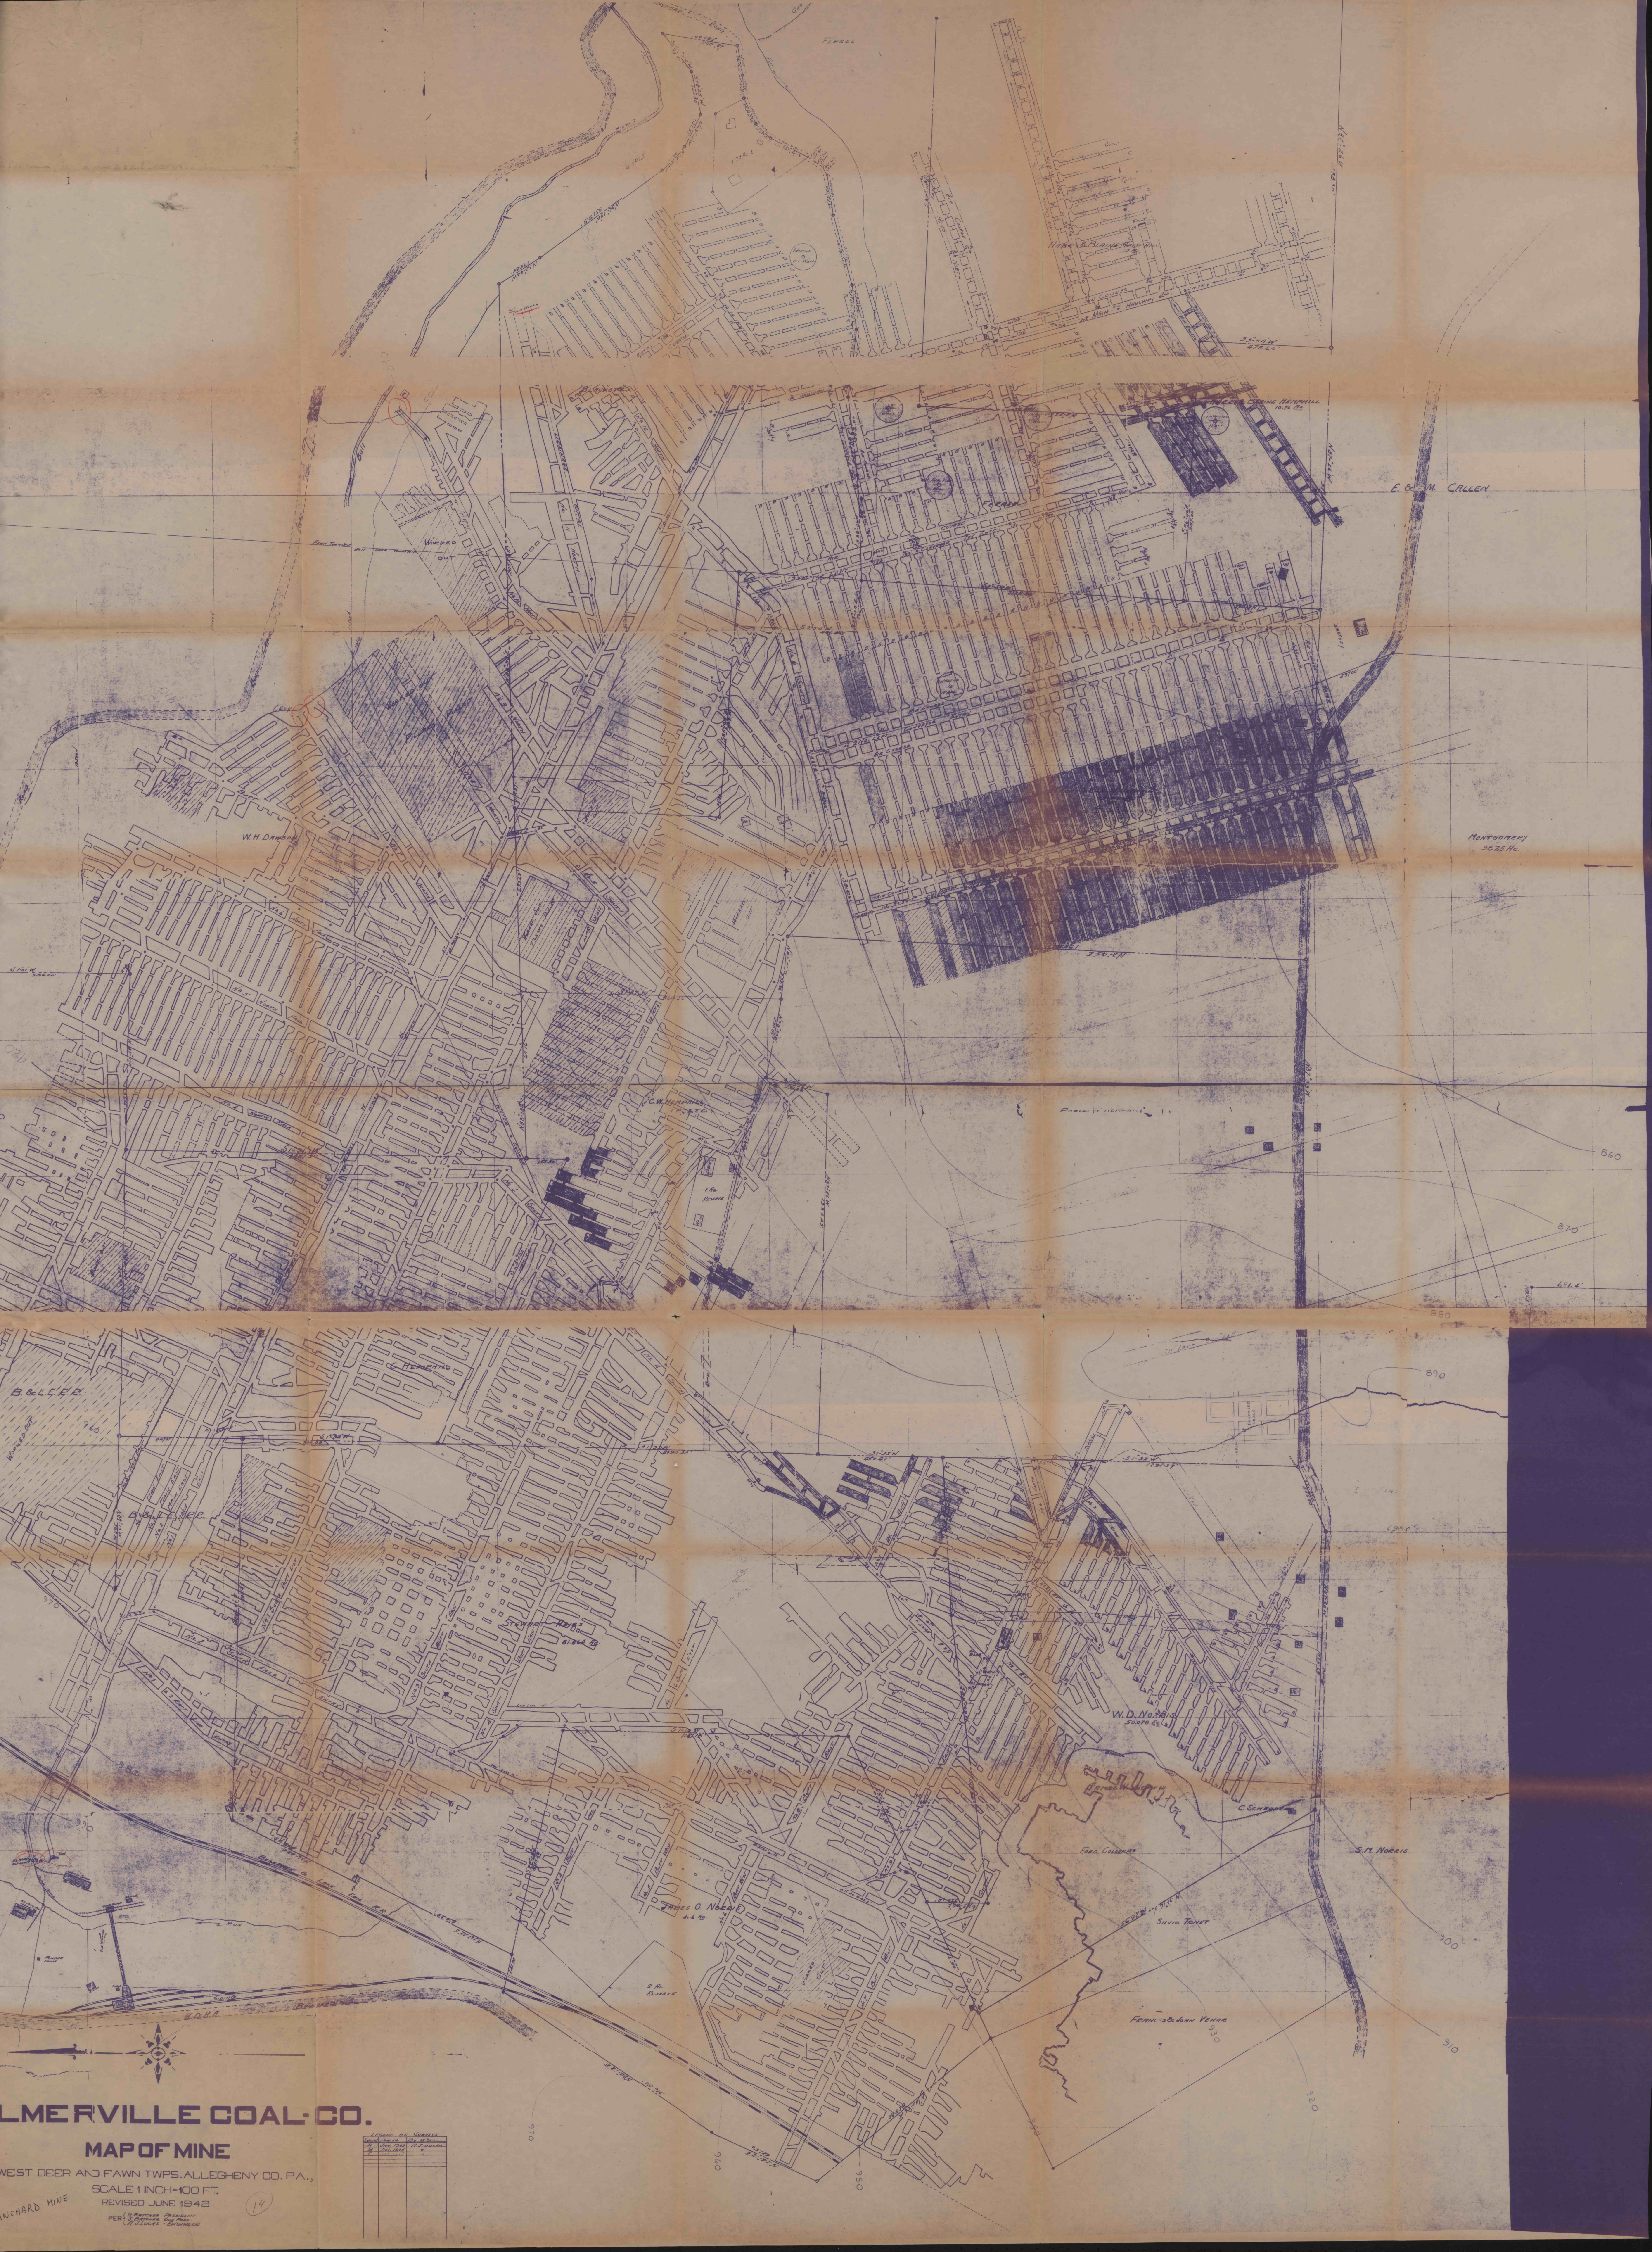

Ferree
Inactive Oil Well
Worked Out
W. H. Dawson
Haber & Blaine Hemphill
Main Haulway
Air Course
Entry
Haber & Blaine Hemphill 10.76 Ac.
E. & M. Callen
Ferree
Montgomery 98.25 Ac.
860
870
880
890
C. W. Hemphill
1 Ac. Reserve
C. Hemphill
B. & L. E. R.R.
Worked Out
Stewart Heyes 81.866 Ac.
No. 2 South Face Entry
Bessemer & Lake Erie R.R.
Run
Powder House
Siding
James O. Norris 4.6 Ac.
2 Ac. Reserve
W. D. Norris 50.078 Ac.
C. Schroder
Ford Collieries
S. M. Norris
Silvio Tonet
Frances & John Venar
900
910
920
930
950
960
970
…LMERVILLE COAL-CO.
MAP OF MINE
WEST DEER AND FAWN TWPS. ALLEGHENY CO. PA.,
SCALE 1 INCH=100 FT.
REVISED JUNE 1942
PER G. Batcher President
J. Batcher Vice Pres.
A. J. Lucas Engineer
Legend of Surveys
A Jan. 1943 A. J. Lucas
B Jan. 1945
(14)
…nchard Mine