

RESERVE
Barn
Shed
N. 301 1/2'

Support for Martin
SOLLO - Bishop
M. T. ...


Mining Area
June 11, 1969
June 30, 1969

WORKED OUT
Information by
the system
12-26-66

BOYD L. CUSTER COAL CO., INC. OPERATOR
UPPER FREEPORT SEAM
SITUATE JENNER TWP., SOMERSET CO., PA.
JUNE 7, 1969 SCALE 1" = 100'

Don Cortese, R.S.
HOLLSOPPLE, PA. 15935

Note: Amendment to previously submitted maps

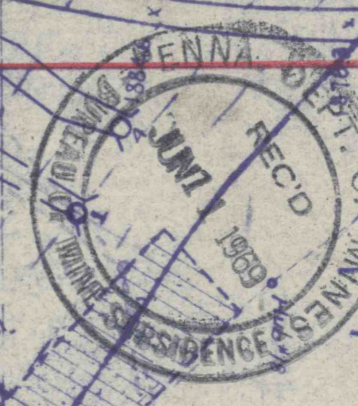

Boyd Custer mine
Jenner Twp, Somerset co
Upper Freeport
scale 1" = 100'

Note: Mine operation
Nearing completion.

#714
7-2-69
C.C.

MAHLON