


Fence Cor.

S. 85° 00' E. - 1536.5'

Stone in Stones

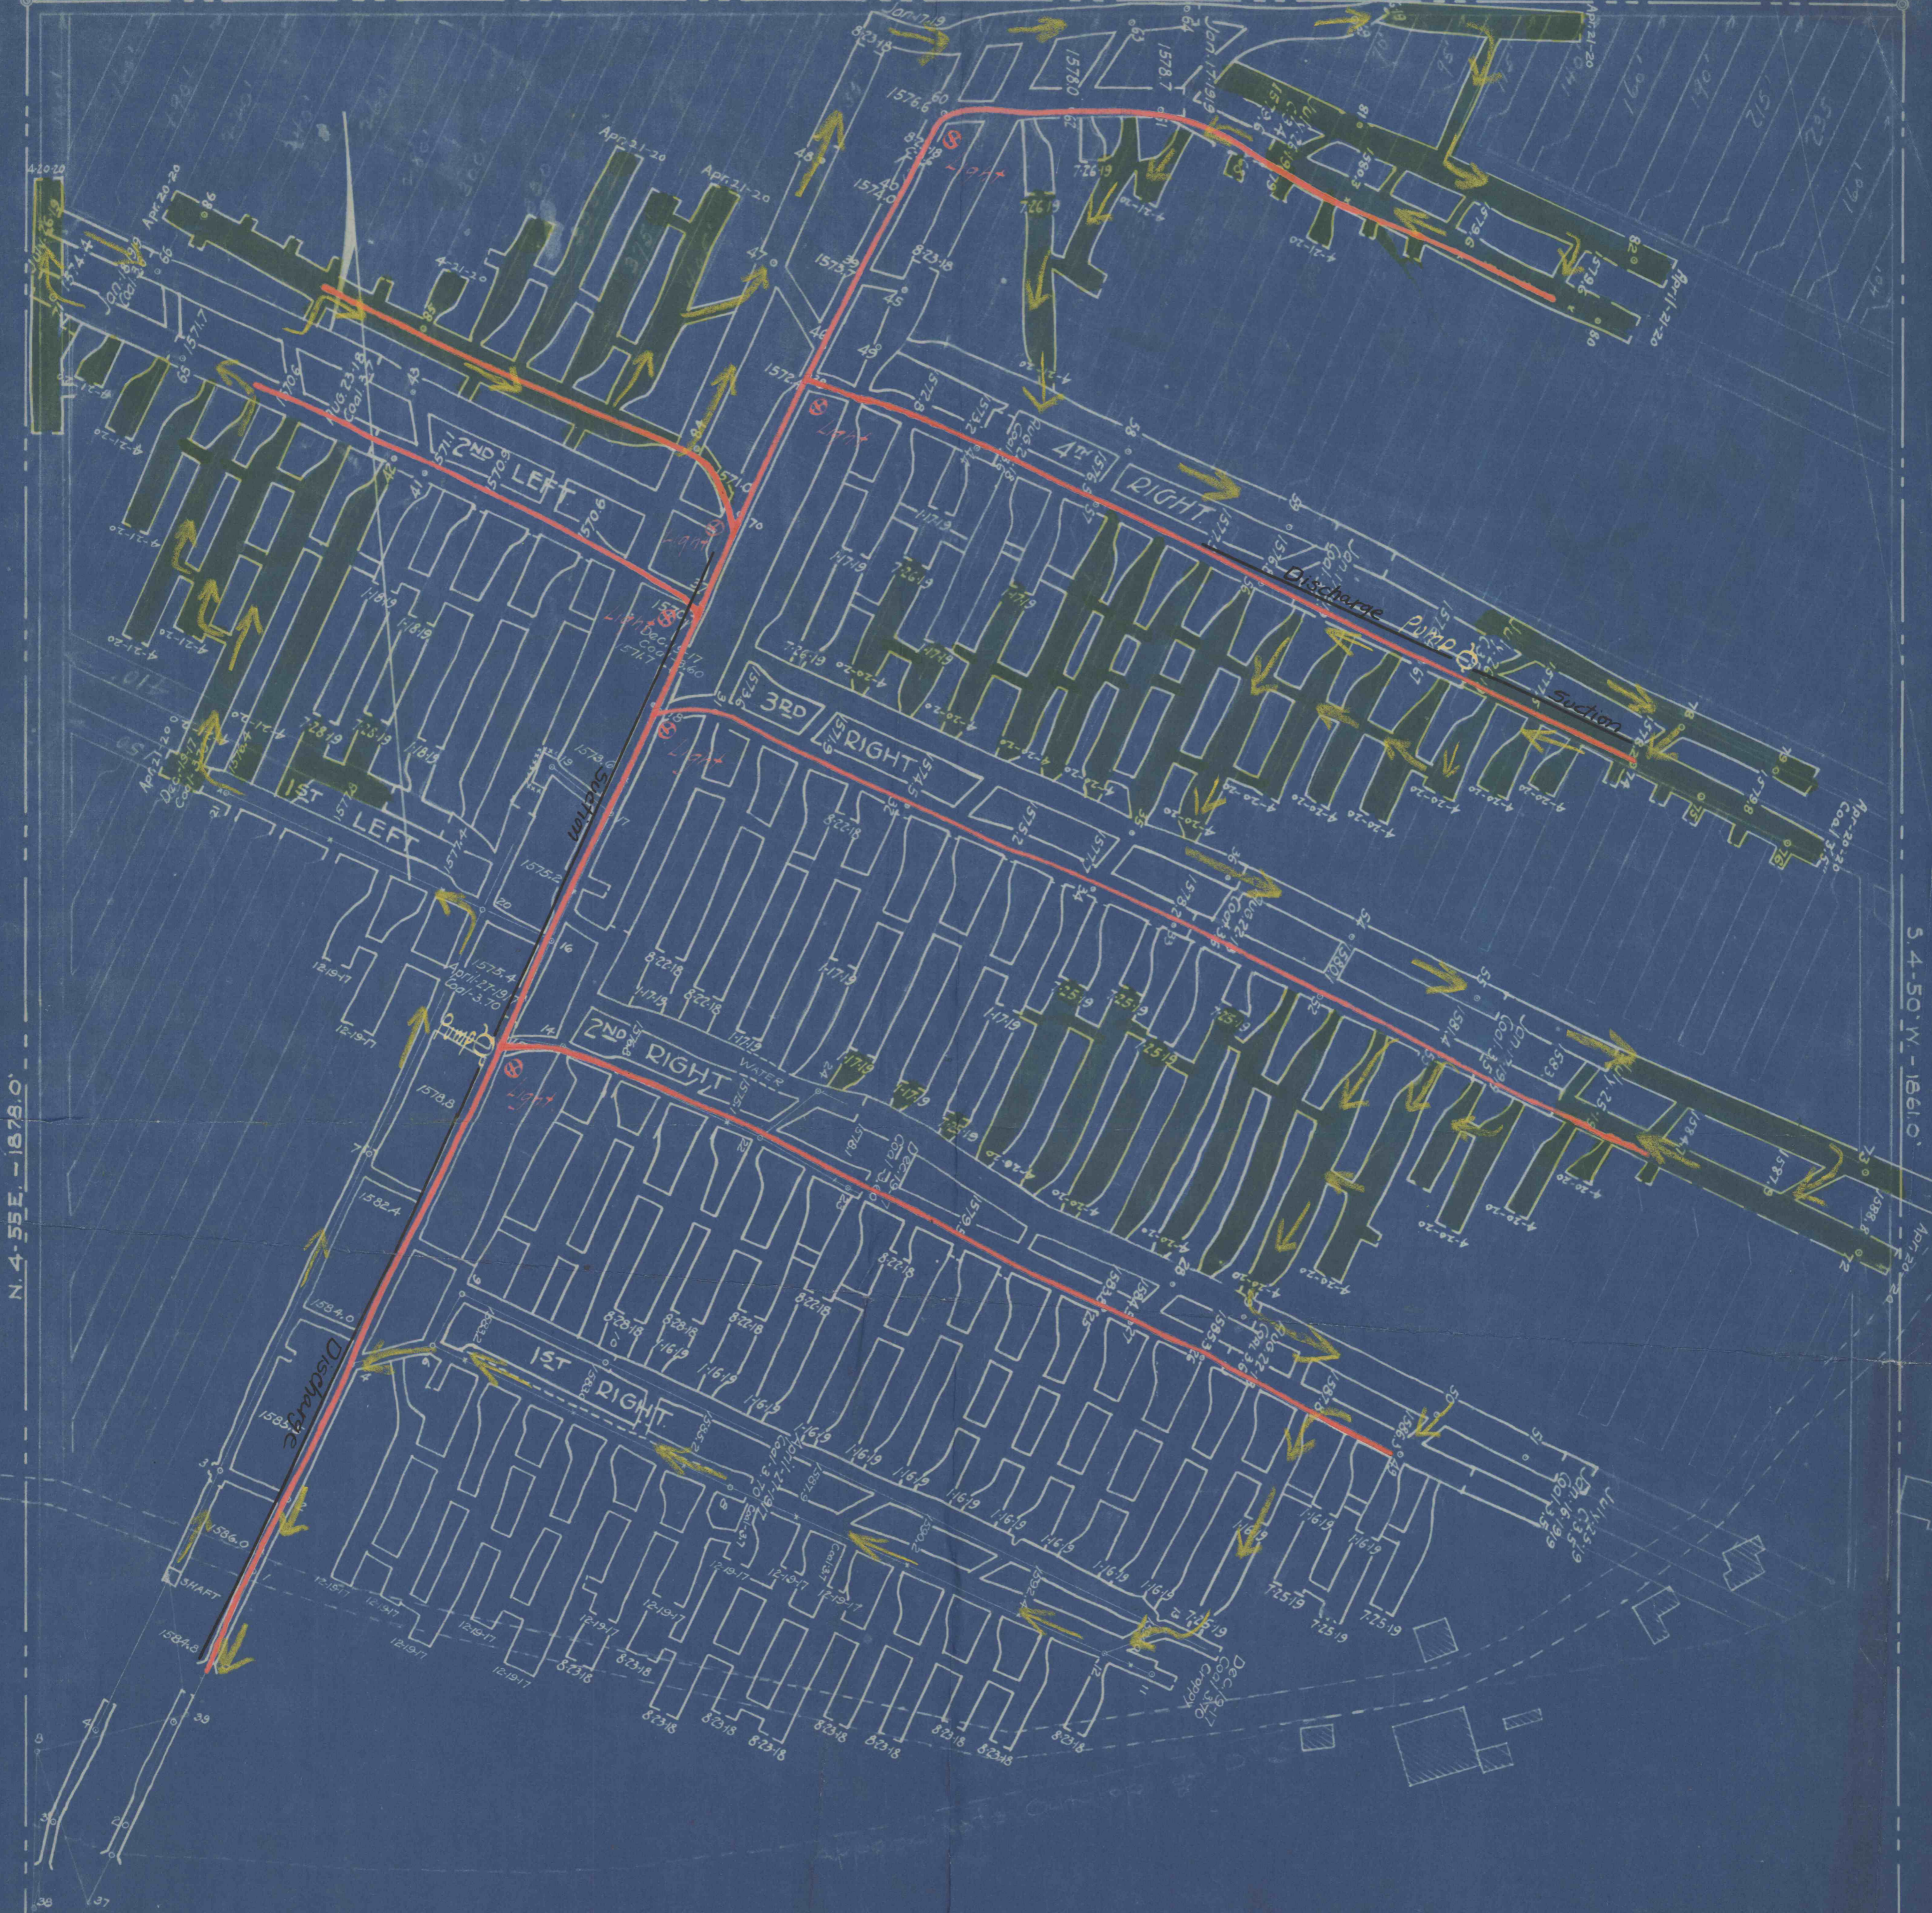

CYMBRIA COAL CO.

MAP OF "E" SEAM WORKINGS

— ON —
NORTH HALF OF JOHN M. WEAKLAND TRACT
NEAR

Cymbria Mines, Cambria County, Pa.

Scale - 1" = 100' - A.B. Crichton - Nov. 6 - 1916

Miner's Engineer
Johnstown, Penna.

#718
T-2-97
CC