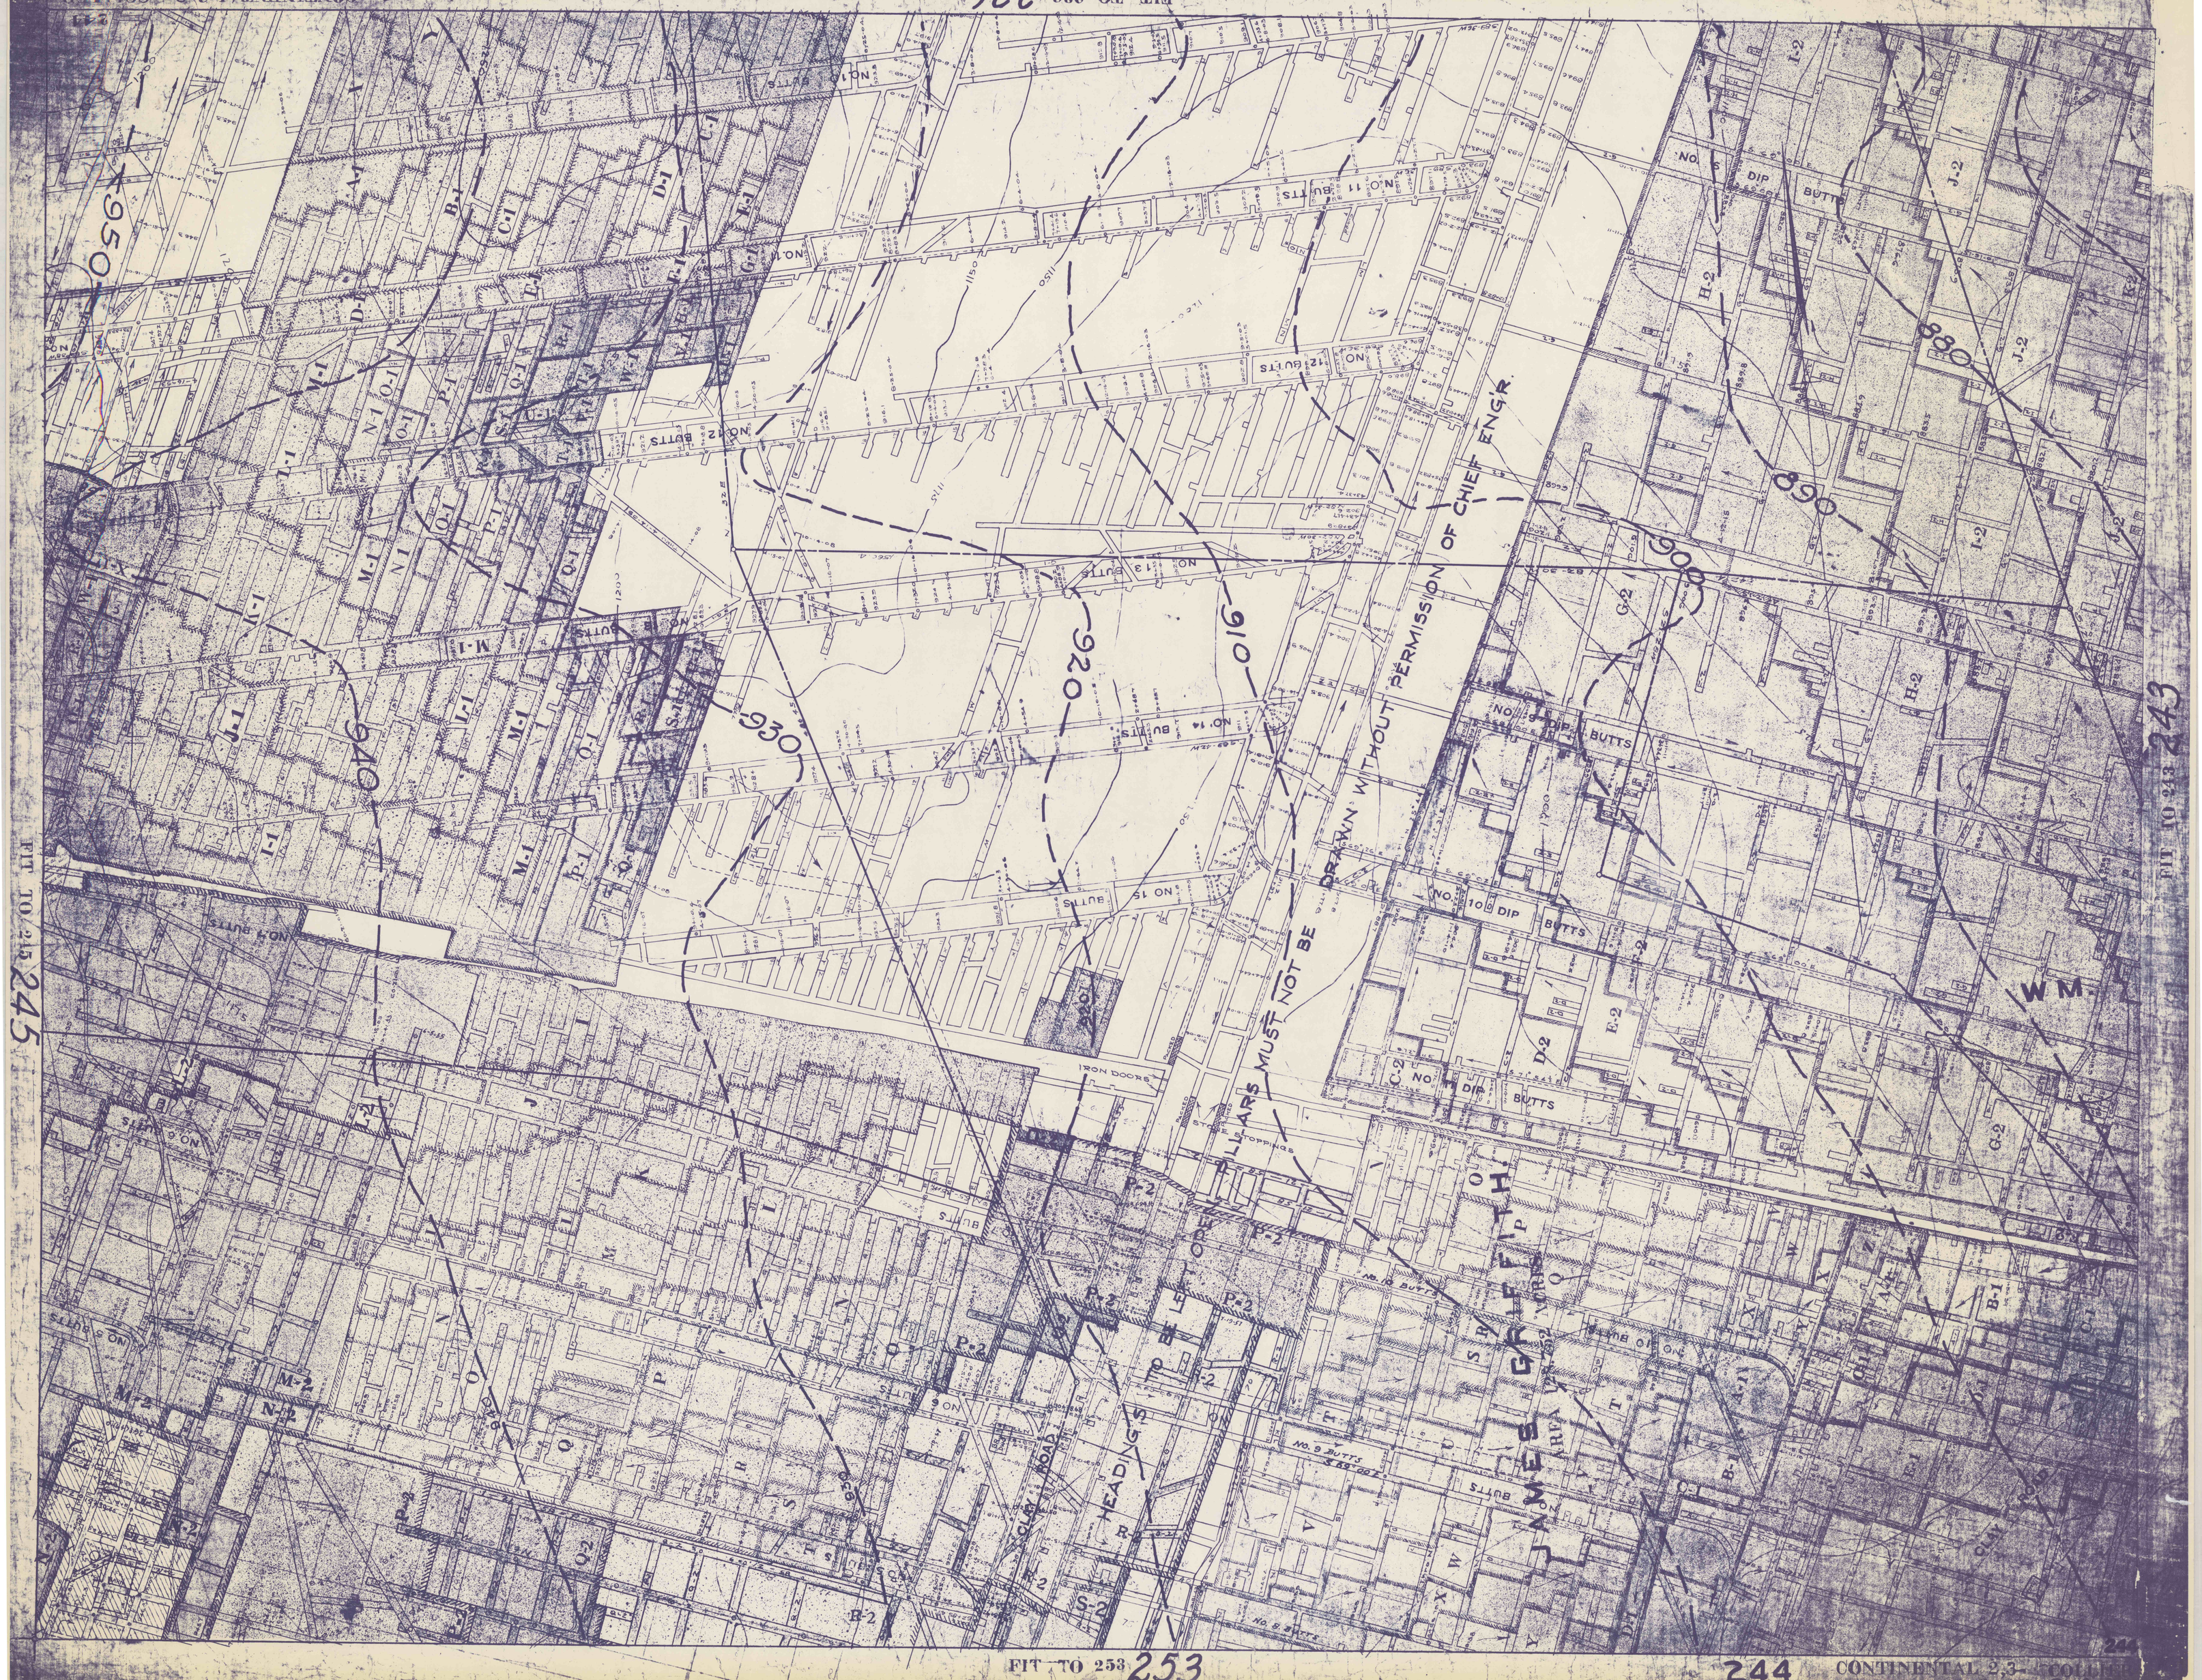
950
940
930
920
910
900
890
880
No. 10 BUTTS
No. 11 BUTTS
No. 12 BUTTS
No. 13 BUTTS
No. 14 BUTTS
No. 15 BUTTS
No. 9 BUTTS
No. 8 BUTTS
No. 7 BUTTS
No. 6 BUTTS
No. 5 DIP BUTTS
No. 10 DIP BUTTS
No. 9 DIP BUTTS
No. 8 DIP BUTTS
IRON DOORS
LIARS MUST NOT BE DRAWN WITHOUT PERMISSION OF CHIEF ENGR.
HEADING TO BE FLOORED
SPIRIT OF THE GRIFFITH
JAMES
WM
CLAY ROAD
FIT TO 245
FIT TO 243
FIT TO 253
253
244 CONTINENTAL 2-3-COLLIER