


Surveyed
Drifts in
REITZ COAL CO. C-COAL
AND NO. 2 SOMERSET CO.
ROBERT KOHL

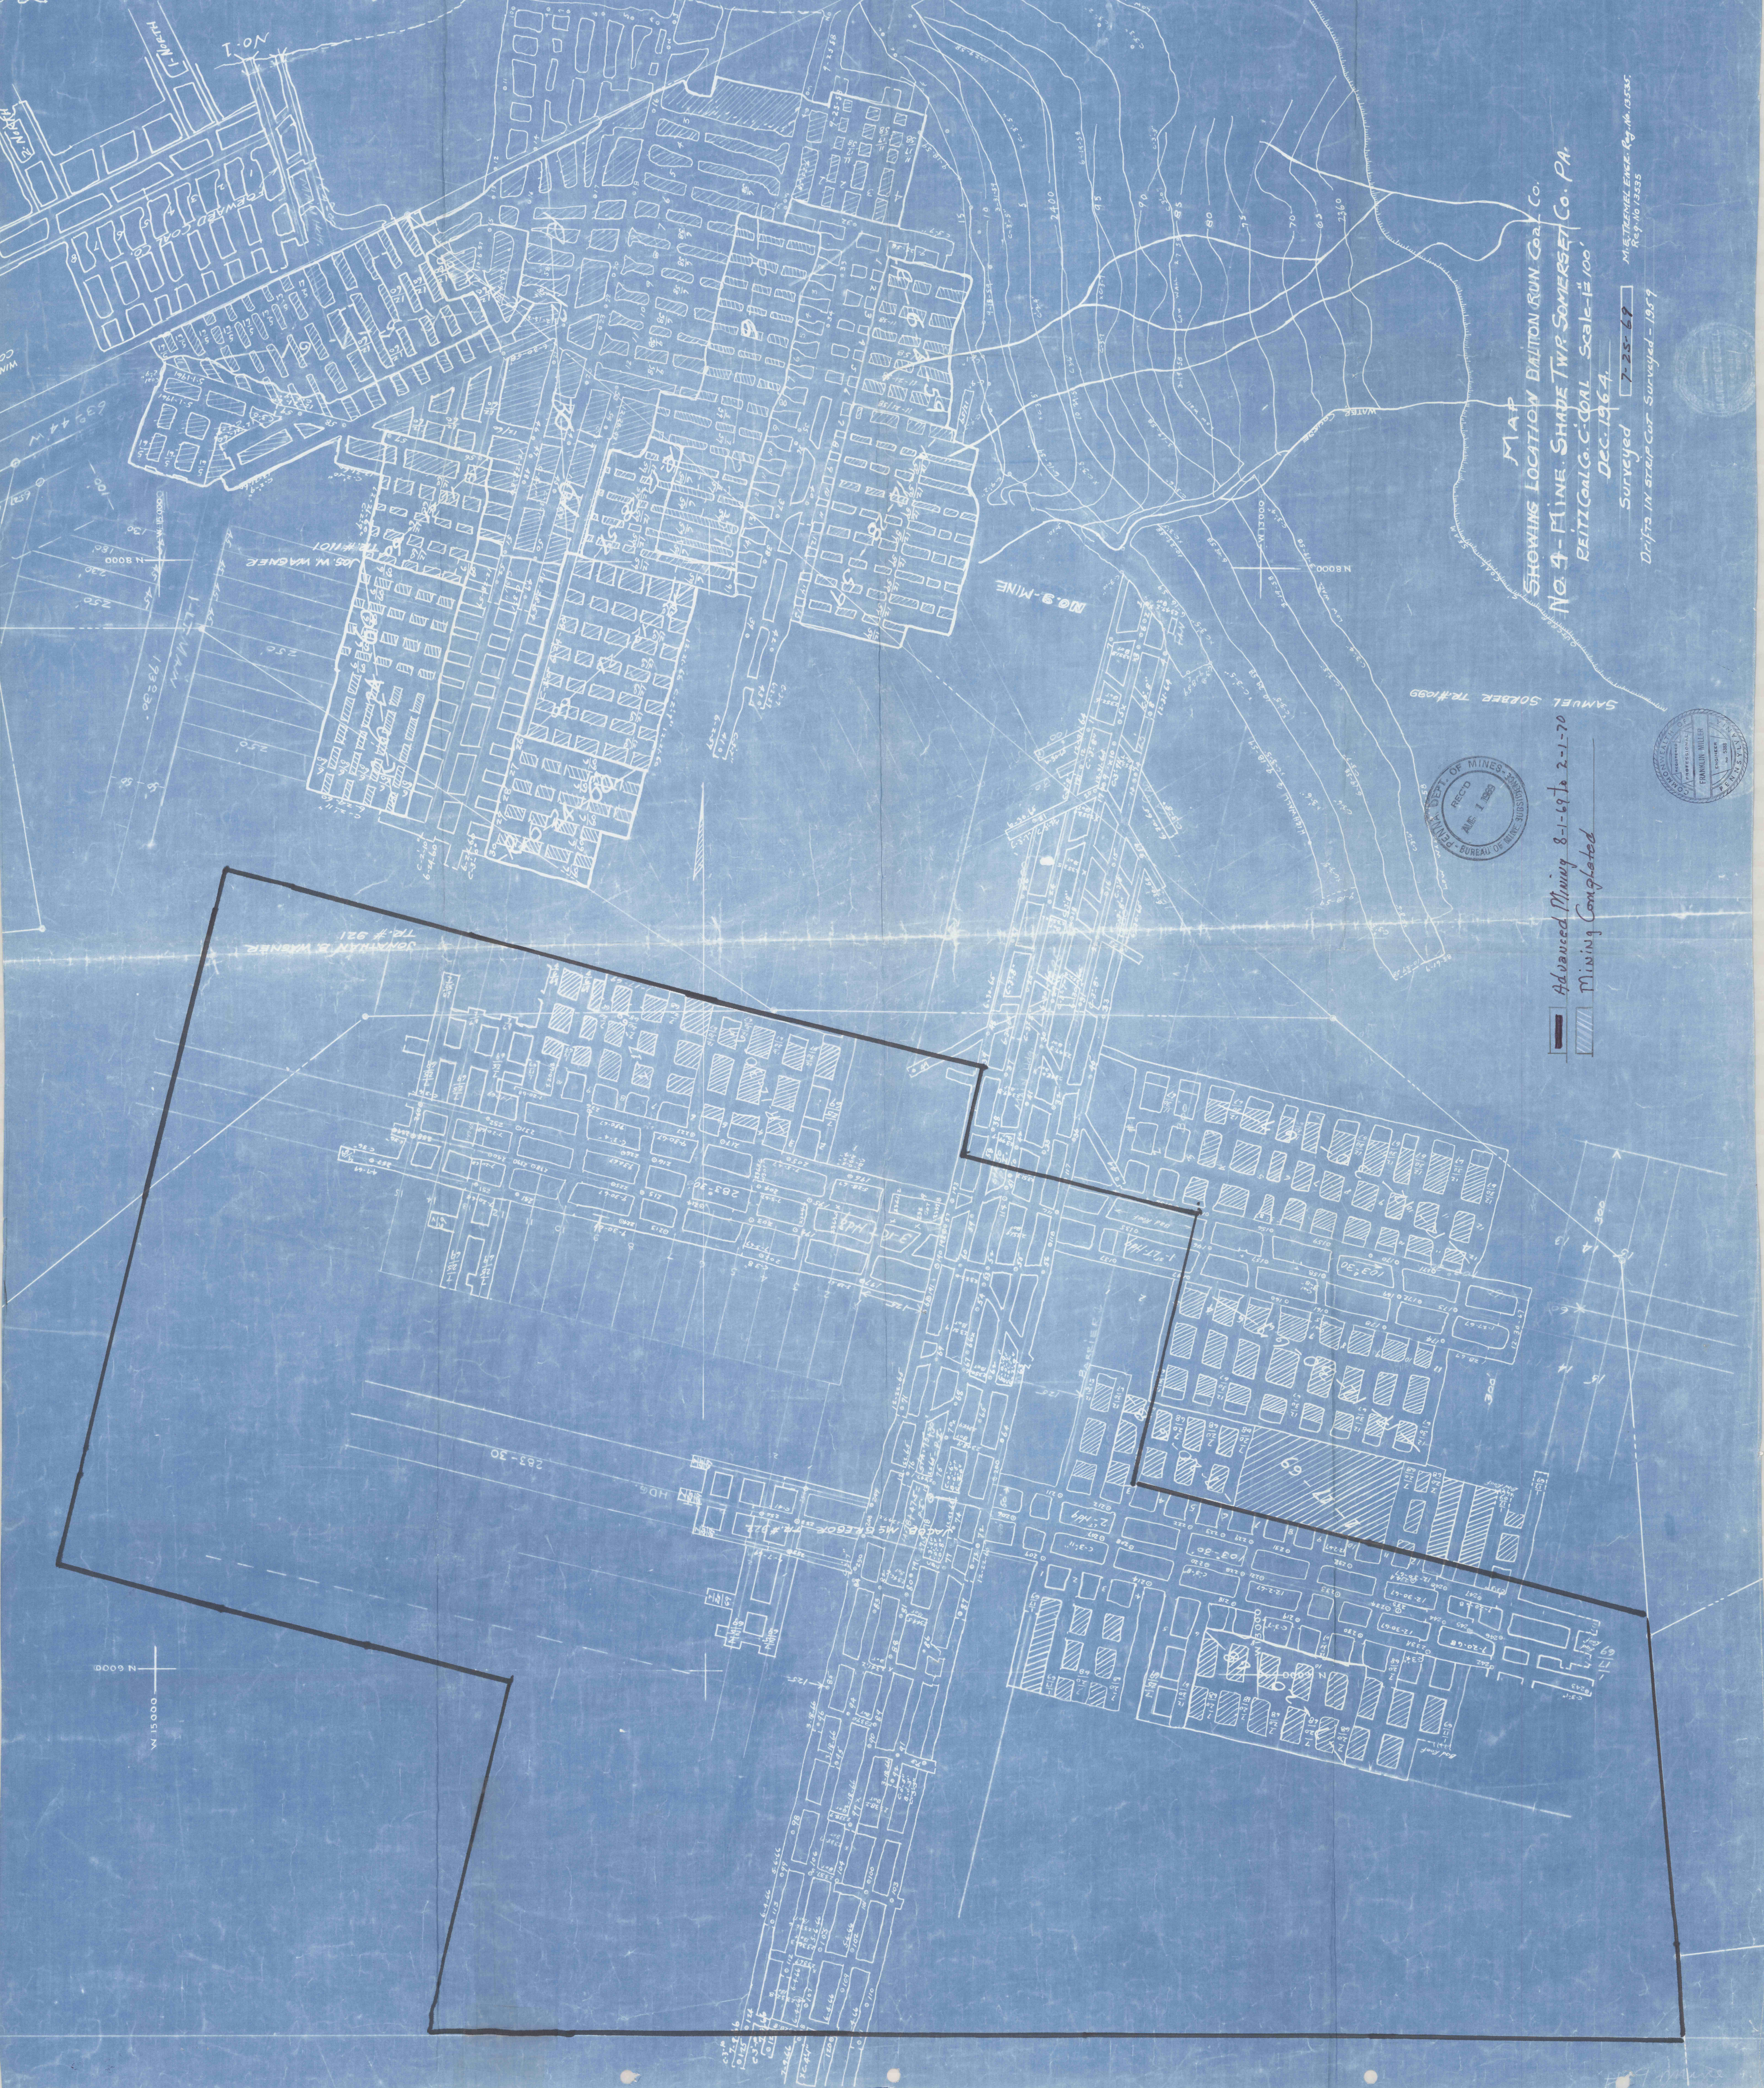

MAP
SHOWING LOCATION BALTIMORE CO. CO.
NO. 4-MINE, SHADE TWP SOMERSET CO. PA.
REITZ COAL CO. C-COAL Scale 1/4\"/>

Advanced Mining 8-1-19 to 2-1-70
Mining Completed

Surveyed 7-25-77
Drifts in strip cut Surveyed - 1957
M. E. T. M. E. C. Rep. No. 13535

