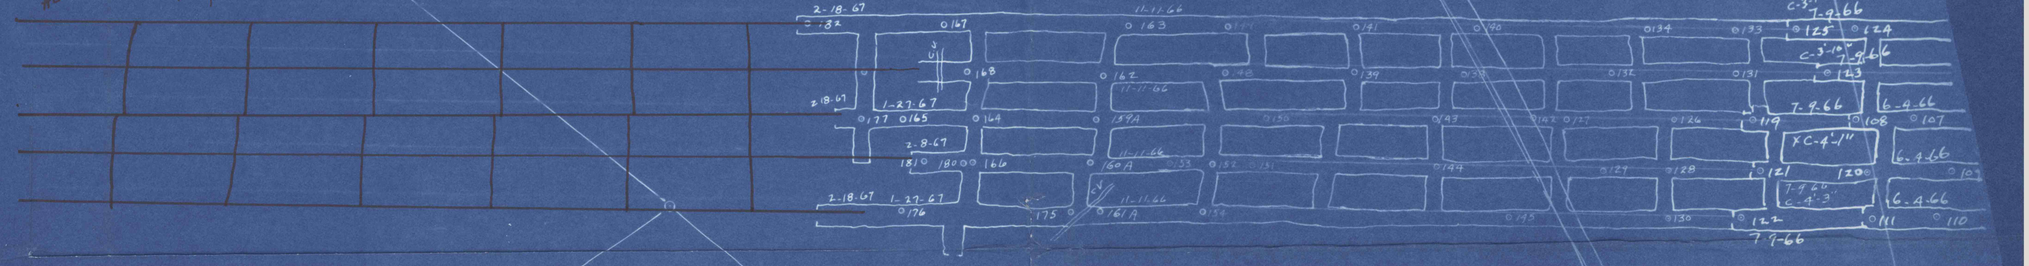

TR. 922
JACOB MC GREGOR
BERWIND WHITE COAL MINING CO.
ALL COAL → SURFACE.

DANIEL B. ZIMMERMAN - CARL WAGNER
SURFACE - BERWIND WHITE COAL MINING CO.
C-5 SEAM @ 0'-5 SEAM COAL

L. M. LAMBERT SURFACE
BERWIND WHITE COAL CO.
ALL SEAMS OF COAL TRACT 927

DOLTON RUN No. 4 MINE

SCALE 1" = 100'

ADVANCED MINING TO AUG 31, 1967