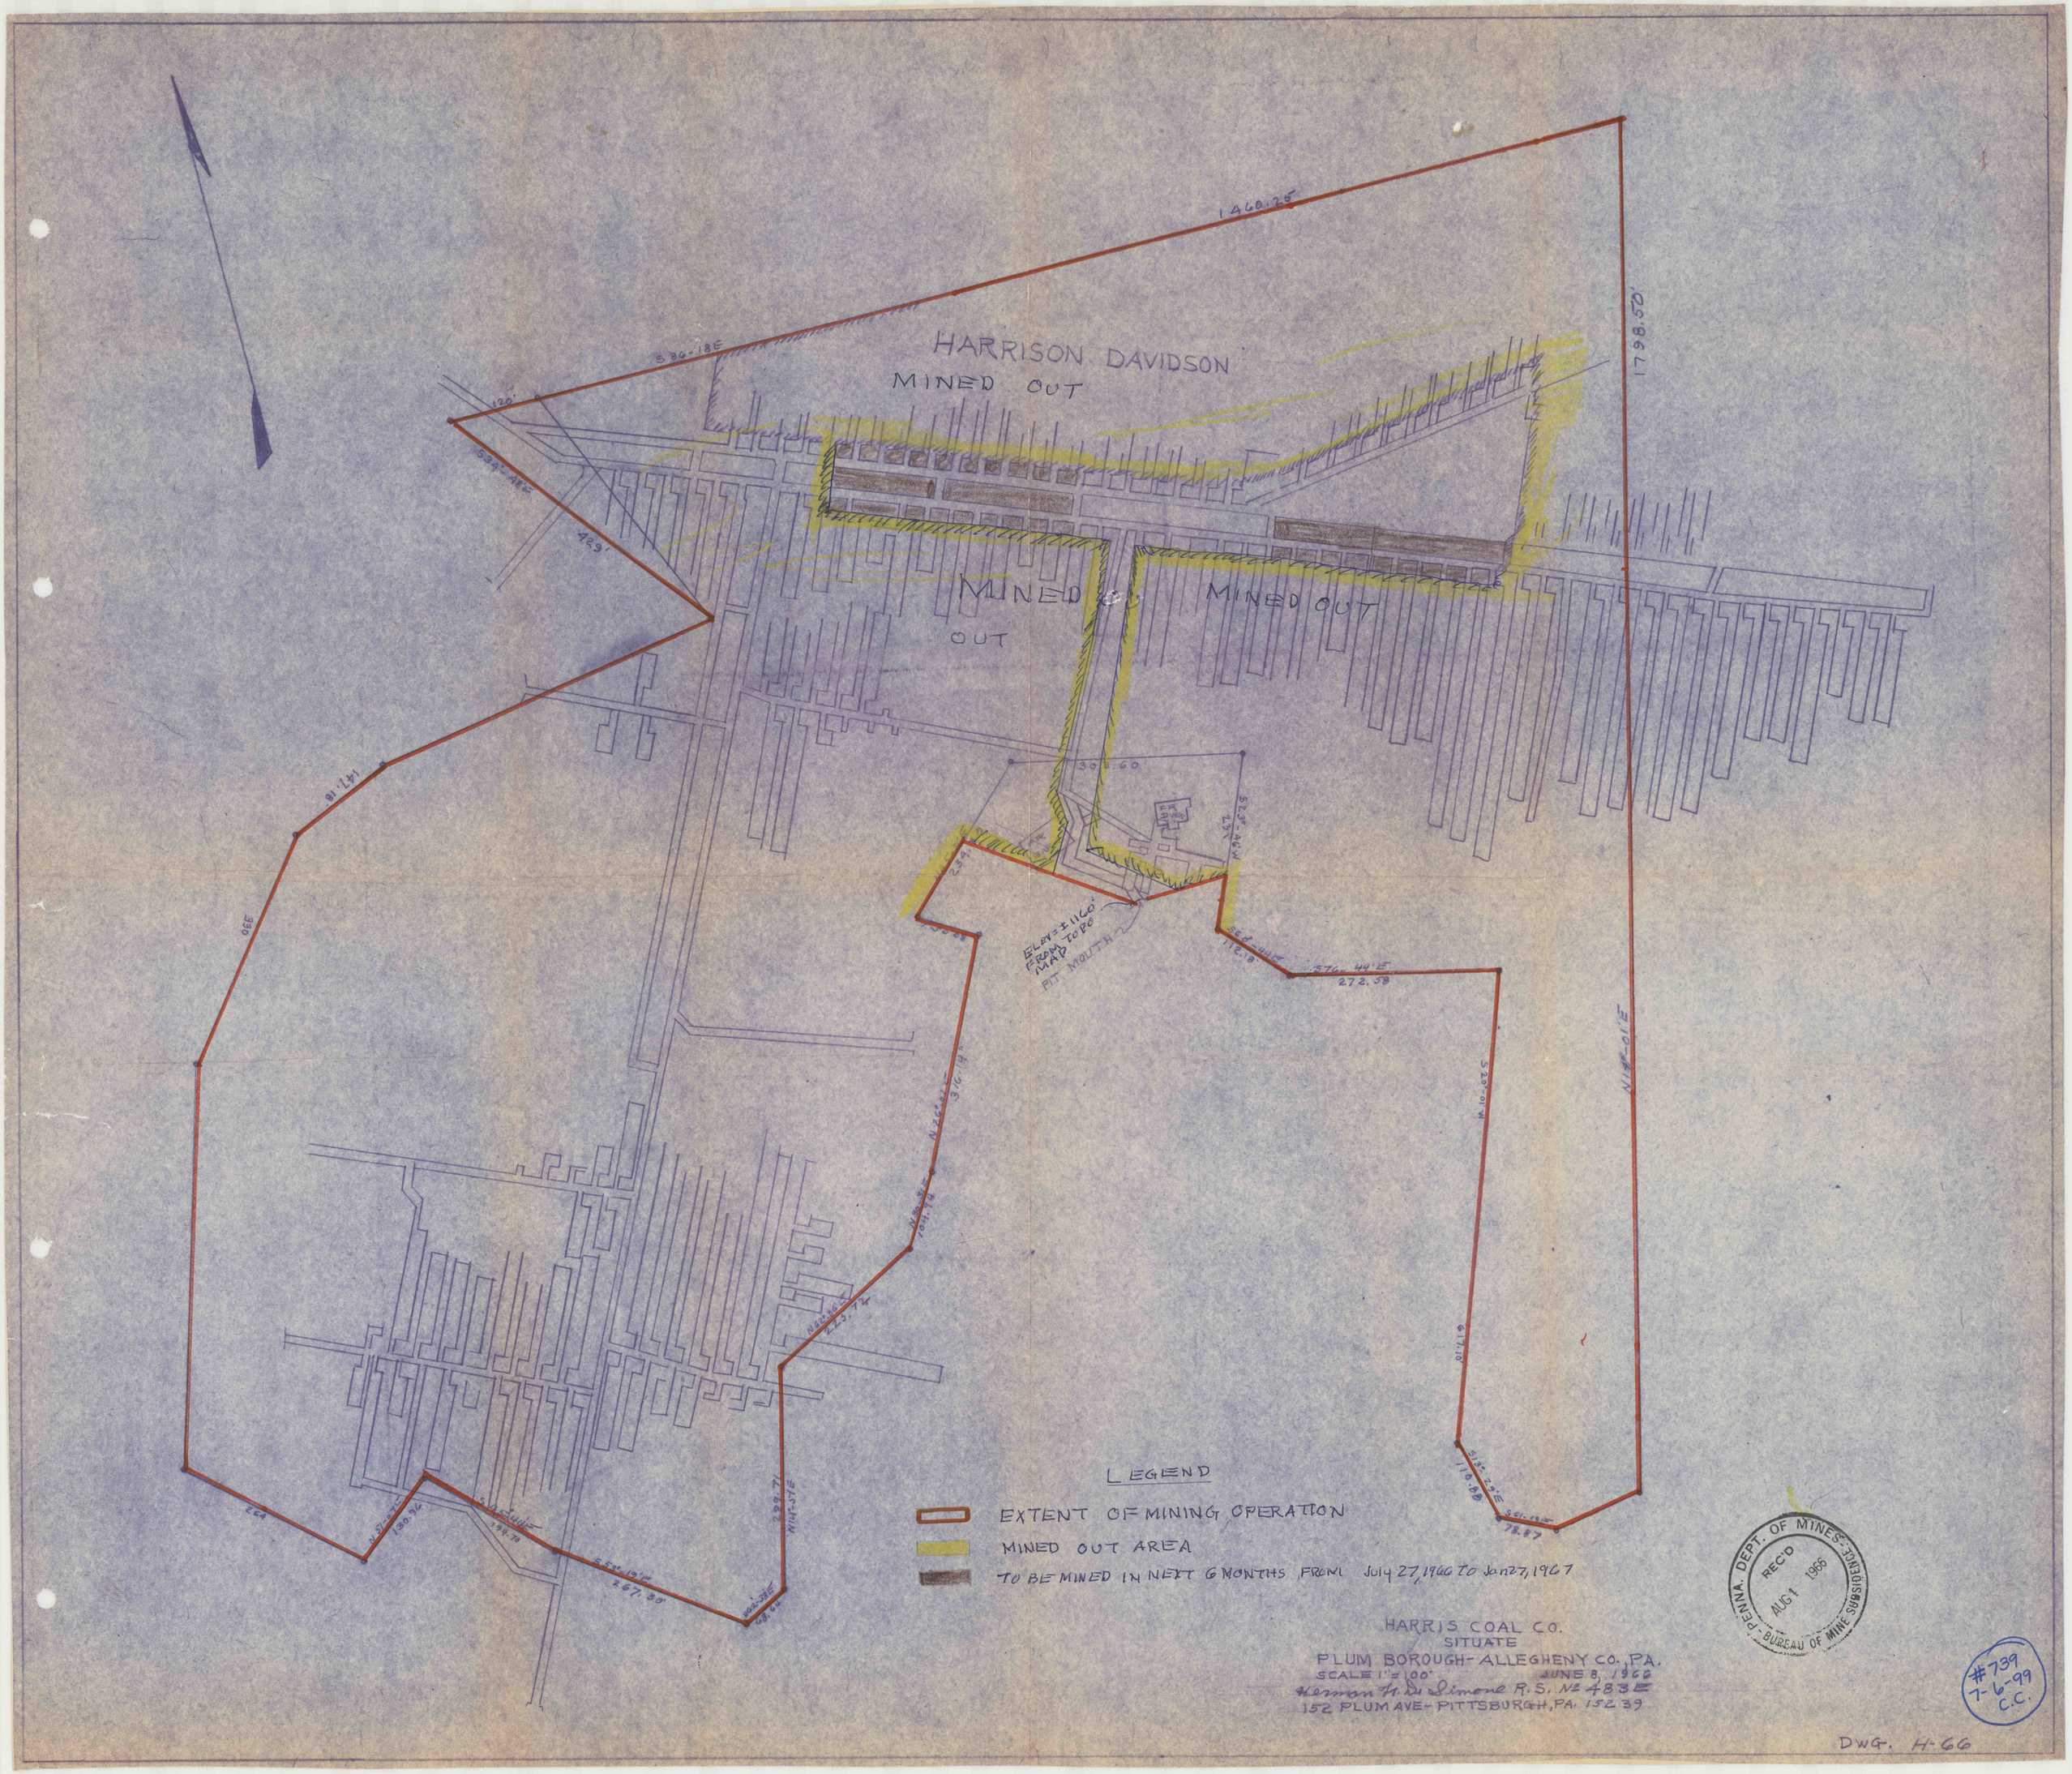
HARRISON DAVIDSON
MINED OUT
MINED OUT
MINED OUT
1460.25
1798.50'
S86-18E
120'
429'
147.18'
330
264
130.96
267.30'
299.71
N14°-57E
N14°-01E
S76-44'E
272.58
S13°-29'E
110.88
78.87
ELEV = ±1160' FROM TOPO MAP
PIT MOUTH
LEGEND
EXTENT OF MINING OPERATION
MINED OUT AREA
TO BE MINED IN NEXT 6 MONTHS FROM July 27, 1966 TO Jan 27, 1967
HARRIS COAL CO.
SITUATE
PLUM BOROUGH-ALLEGHENY CO., PA.
SCALE 1" = 100'
JUNE 8, 1966
Herman H. De Simone R.S. No 483E
152 PLUM AVE - PITTSBURGH, PA. 15239
PENNA. DEPT. OF MINES
REC'D
AUG 1 1966
BUREAU OF MINE SUBSIDENCE
#739
7-6-99
C.C.
DWG. H-66